

TRACT No 918
"ORANGE PARK ACRES"

BEING A RESUBDIVISION OF PORTIONS OF TRACT No 752 AS SHOWN ON A MAP THEREOF RECORDED IN BOOK 25 PAGES 12 TO 14 INCLUSIVE MISCELLANEOUS MAPS RECORDS OF ORANGE COUNTY, CALIFORNIA AND A SUBDIVISION OF PORTIONS OF SECTIONS 23-24-25 AND 26 TWP. 4 SOUTH, RANGE 9 WEST SAN BERNARDINO BASE AND MERIDIAN ALL IN RANCHO SANTIAGO DE SANTA ANA, ORANGE COUNTY, CALIFORNIA.

ORANGE PARK ACRES

E. E. Mead President
Frank F. Mead Jr. Secretary

I, W. K. Hilliard, Civil Engineer certify that during August, A.D. 1928 an actual survey was made under my direction on the ground covered by the accompanying map and that the same is a correct map thereof.

W. K. Hilliard
Civil Engineer

STATE OF CALIFORNIA)
COUNTY OF ORANGE } ss: On this 9 day of September
A.D. 1928 before me Milly Galbreath a Notary Public
in and for said County and State, residing therein, duly
commissioned and sworn personally appeared
E. E. Mead known to me to be the
President and Frank F. Mead Jr. known to me to be the
Secretary of ORANGE PARK ACRES the corporation
described in and that executed the within instru-
ment and known to me to be the persons who execut-
ed the within instrument on behalf of the corporation
therein named and acknowledged to me that such
corporation executed the same

IN WITNESS WHEREOF I have hereunto set my
hand and affixed my official seal the day and year
in this certificate first above written.

Milly Galbreath
Notary Public in and for Orange County, California

STATE OF CALIFORNIA)
COUNTY OF ORANGE } ss: I, J. M. BACKS County Clerk
in and for said County, do hereby certify that a good and
sufficient bond approved by the County Board of Super-
visors has been filed with said County Board which
said bond is conditioned for the payment of all taxes
which are a lien upon the land covered by the ac-
companying map and not yet due and payable, also this
map was presented for approval to said Board at a reg-
ular meeting thereof held on the 11 day of
A.D. 1928 and that thereupon said Board did by an
order duly passed and entered approve said map
and accepted on behalf of the public County Park Road
and Pepper Avenue but did not accept Lots A to K
inclusive for Road purposes.

County Clerk and ex-officio clerk of the Board of Supervisors

STATE OF CALIFORNIA)
COUNTY OF ORANGE } ss: I, W. M. C. JEROME County
Auditor do hereby certify that there are no liens for
unpaid State or County taxes except taxes not yet due
and payable against the tract of land covered by the
accompanying map

Dated this 11 day of Sept A.D. 1928.

W. M. C. Jerome
County Auditor

L. H. Ockel
Chief Deputy

Examined and approved this 10 day of October AD 1928.

W. K. Hilliard
County Surveyor

STATE OF CALIFORNIA)
COUNTY OF ORANGE } ss: It was, on the 4 day of
Sept A.D. 1928, ordered by the Board of Super-
visors of said County that this map be submitted to the
City Engineer of Orange being the nearest City to said
tract and lying within three miles thereof.

J. M. Backs
County Clerk and ex-officio clerk of the Board of Supervisors

I hereby recommend to the Board of Trustees of
the City of Orange that this map be approved
Dated this 4 day of Sept A.D. 1928

C. C. Bonebrake
City Engineer

STATE OF CALIFORNIA)
COUNTY OF ORANGE } ss: It was, on the 4 day of Sept
A.D. 1928 ordered by the Board of Trustees
of the City of Orange that this map be approved

Paul E. Clark
City Clerk

We hereby certify that we have examined the lots of
this subdivision as shown on the accompanying map
and approve said lots for residence or commercial uses.

Gas B. B. By *Maurice H. H. H.* *W. K. Hilliard*
County Assessor Chief Deputy County Surveyor



INDEXED

FILED
OCT 13 1928

500
Mathilde Williams

28-42


32516

ORIGINAL

INDEXED
FILED
001 13 1928

Owners
CHANGE COUNTY RECORDS
JUSTINE WHITNEY
Mathilde Williams

SHEET NO 2 OF 3 SHEETS
TRACT NO 918
Scale: 1"=200'

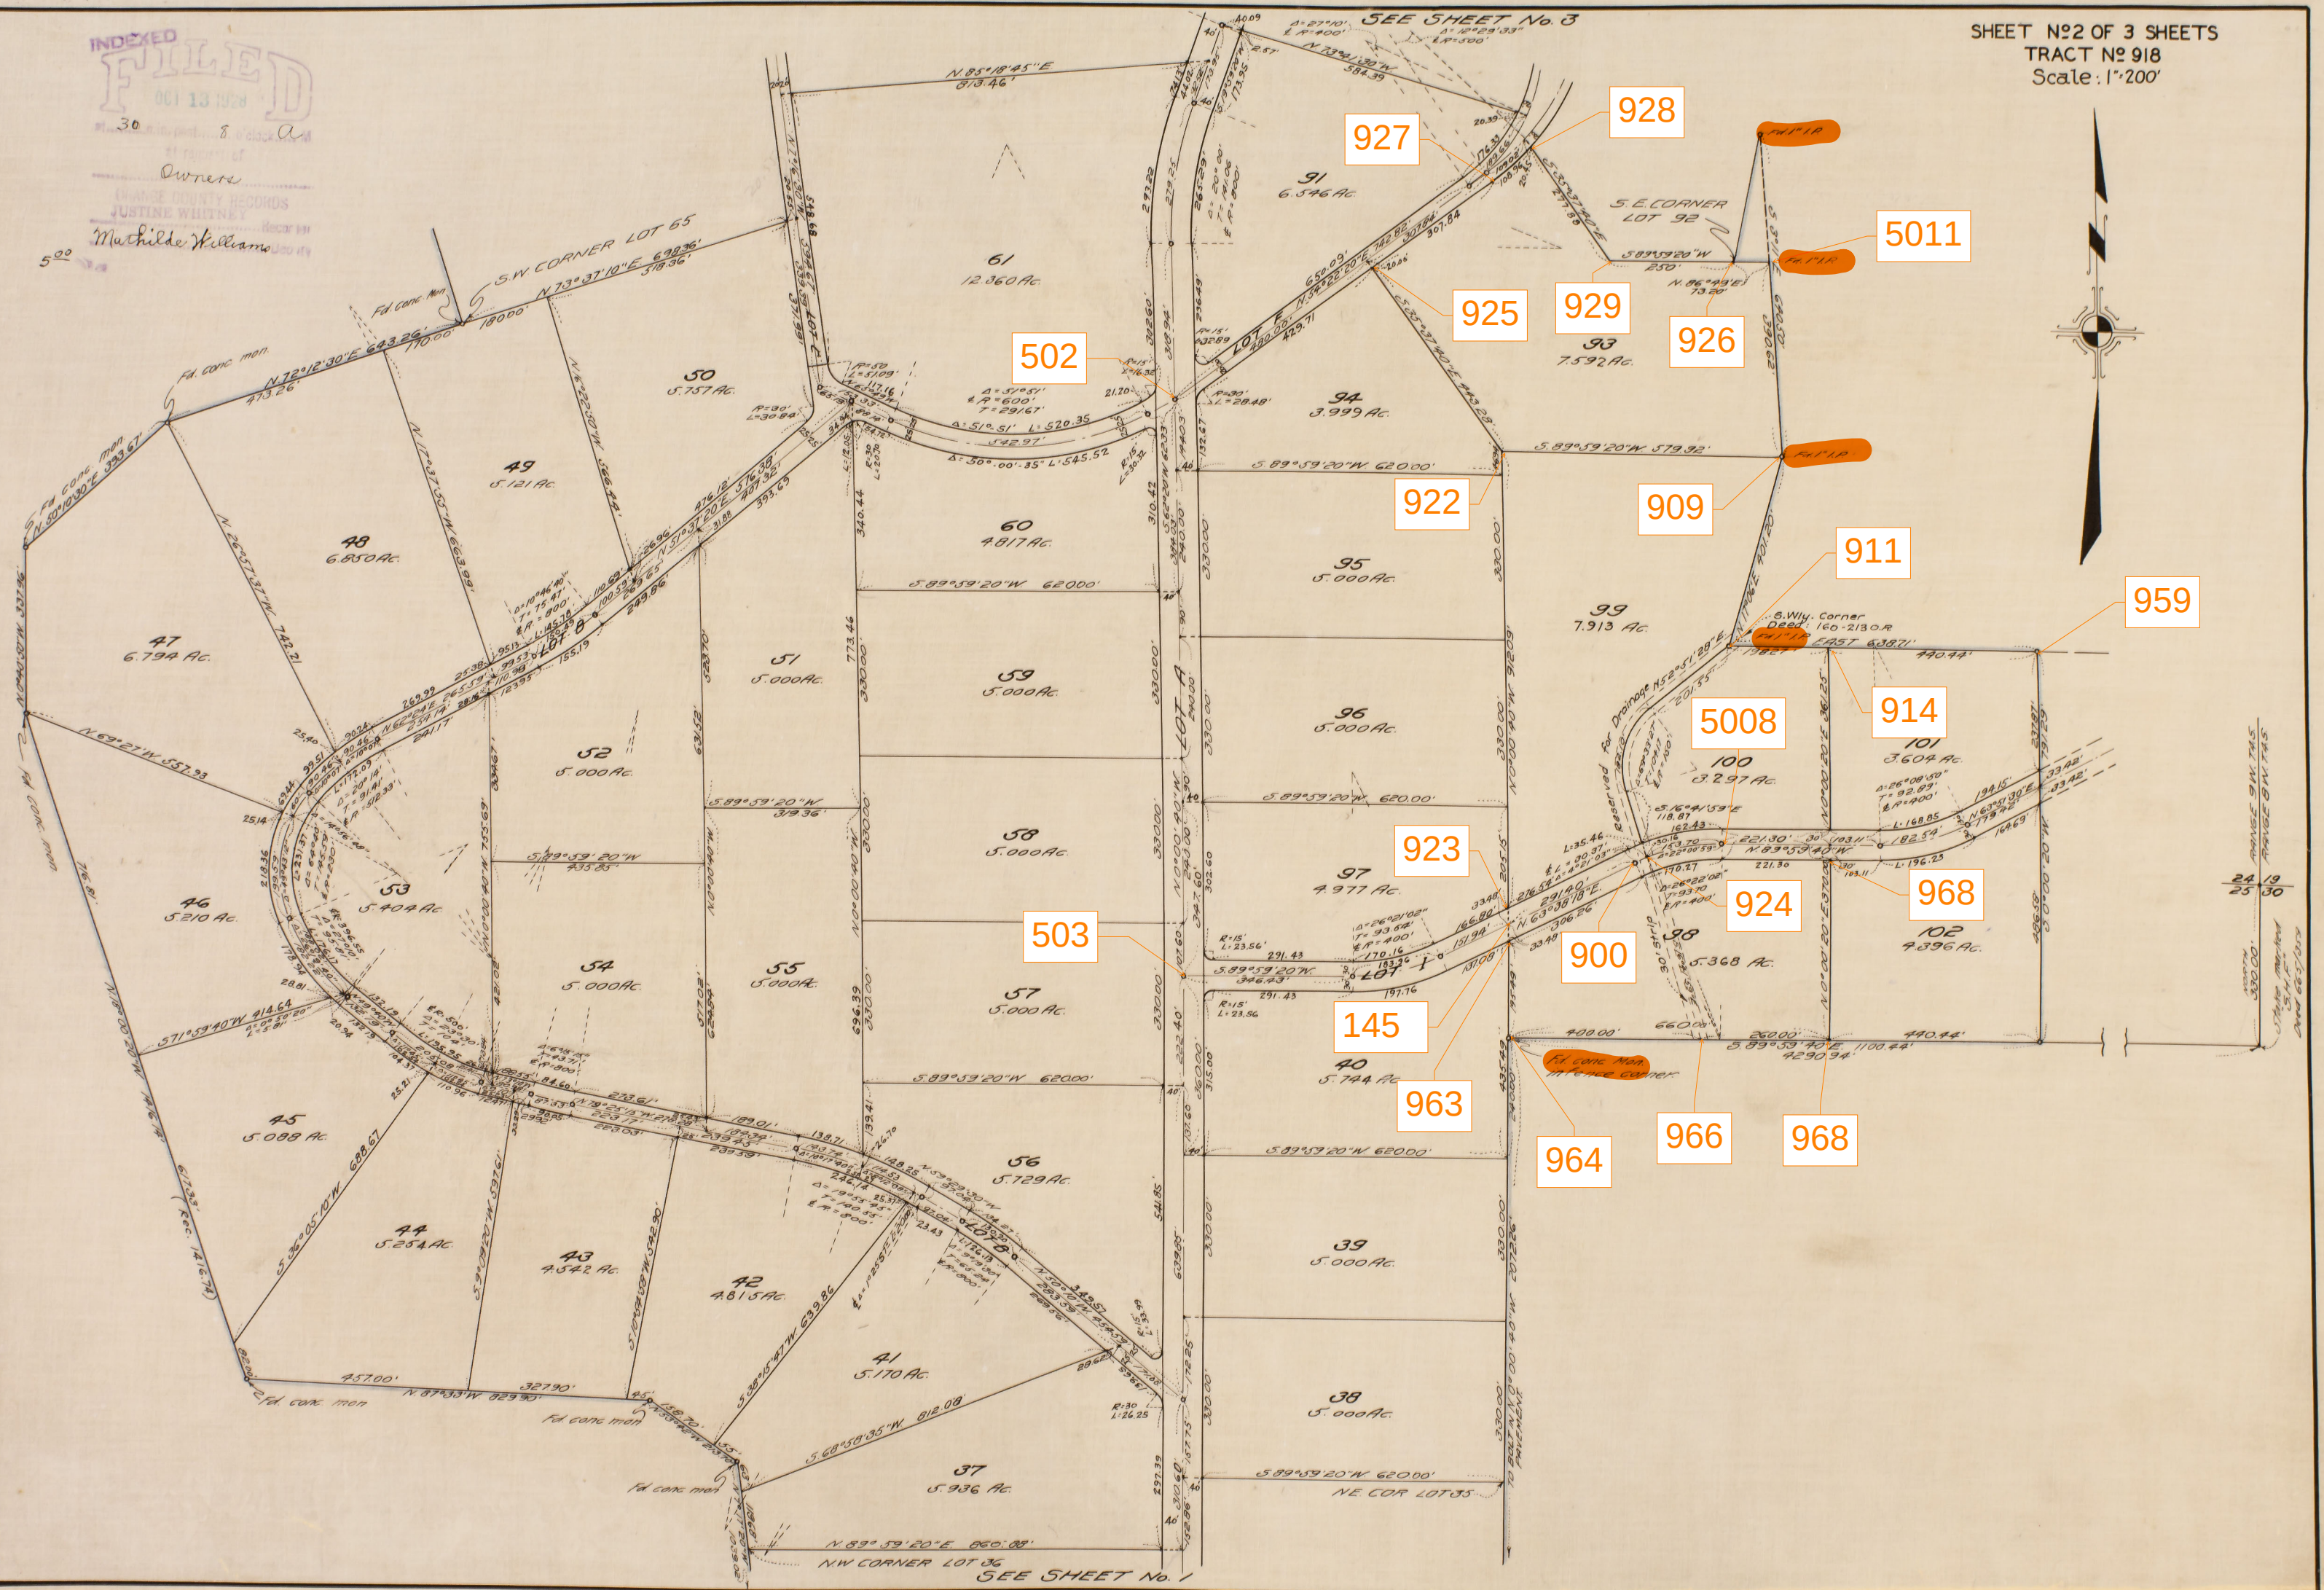

28-42

SEE SHEET No. 1

SEE SHEET No. 3

INDEXED

FILED
OCT 13 1928
M. 30

Owner
GRANGE COUNTY RECORDS
JUSTICE WHITNEY, Clerk
Machilde Williams

Note: Bearings shown on
this Tract differ by 0° 02' 40"
from those used on Tract No.
752.

