

RECORD OF SURVEY

OF PARCELS SHOWN BELOW,
GIVING NAME OF OWNER, DATE OF
SURVEY, SCALE, AND OTHER DATA
AS INDICATED.
D. D. HILLYARD, LICENSED SURVEYOR

RECEIVED
NOV 29 1951
FILED
Nov. 28. 1951
At 35 Min. past 2 o'clock P. M.
at request of
W. H. Wiley, and
ORANGE COUNTY RECORDS
Sandy W. Hardin
FEE
d.00

OWNER :

Ernest N. Winbigler


DESCRIPTION :

Port. of Blk. 15, Irvine's
Subdivision, MRM: 1-88

SURVEYED:

August 15, 1951

SCALE : 1" = 100'

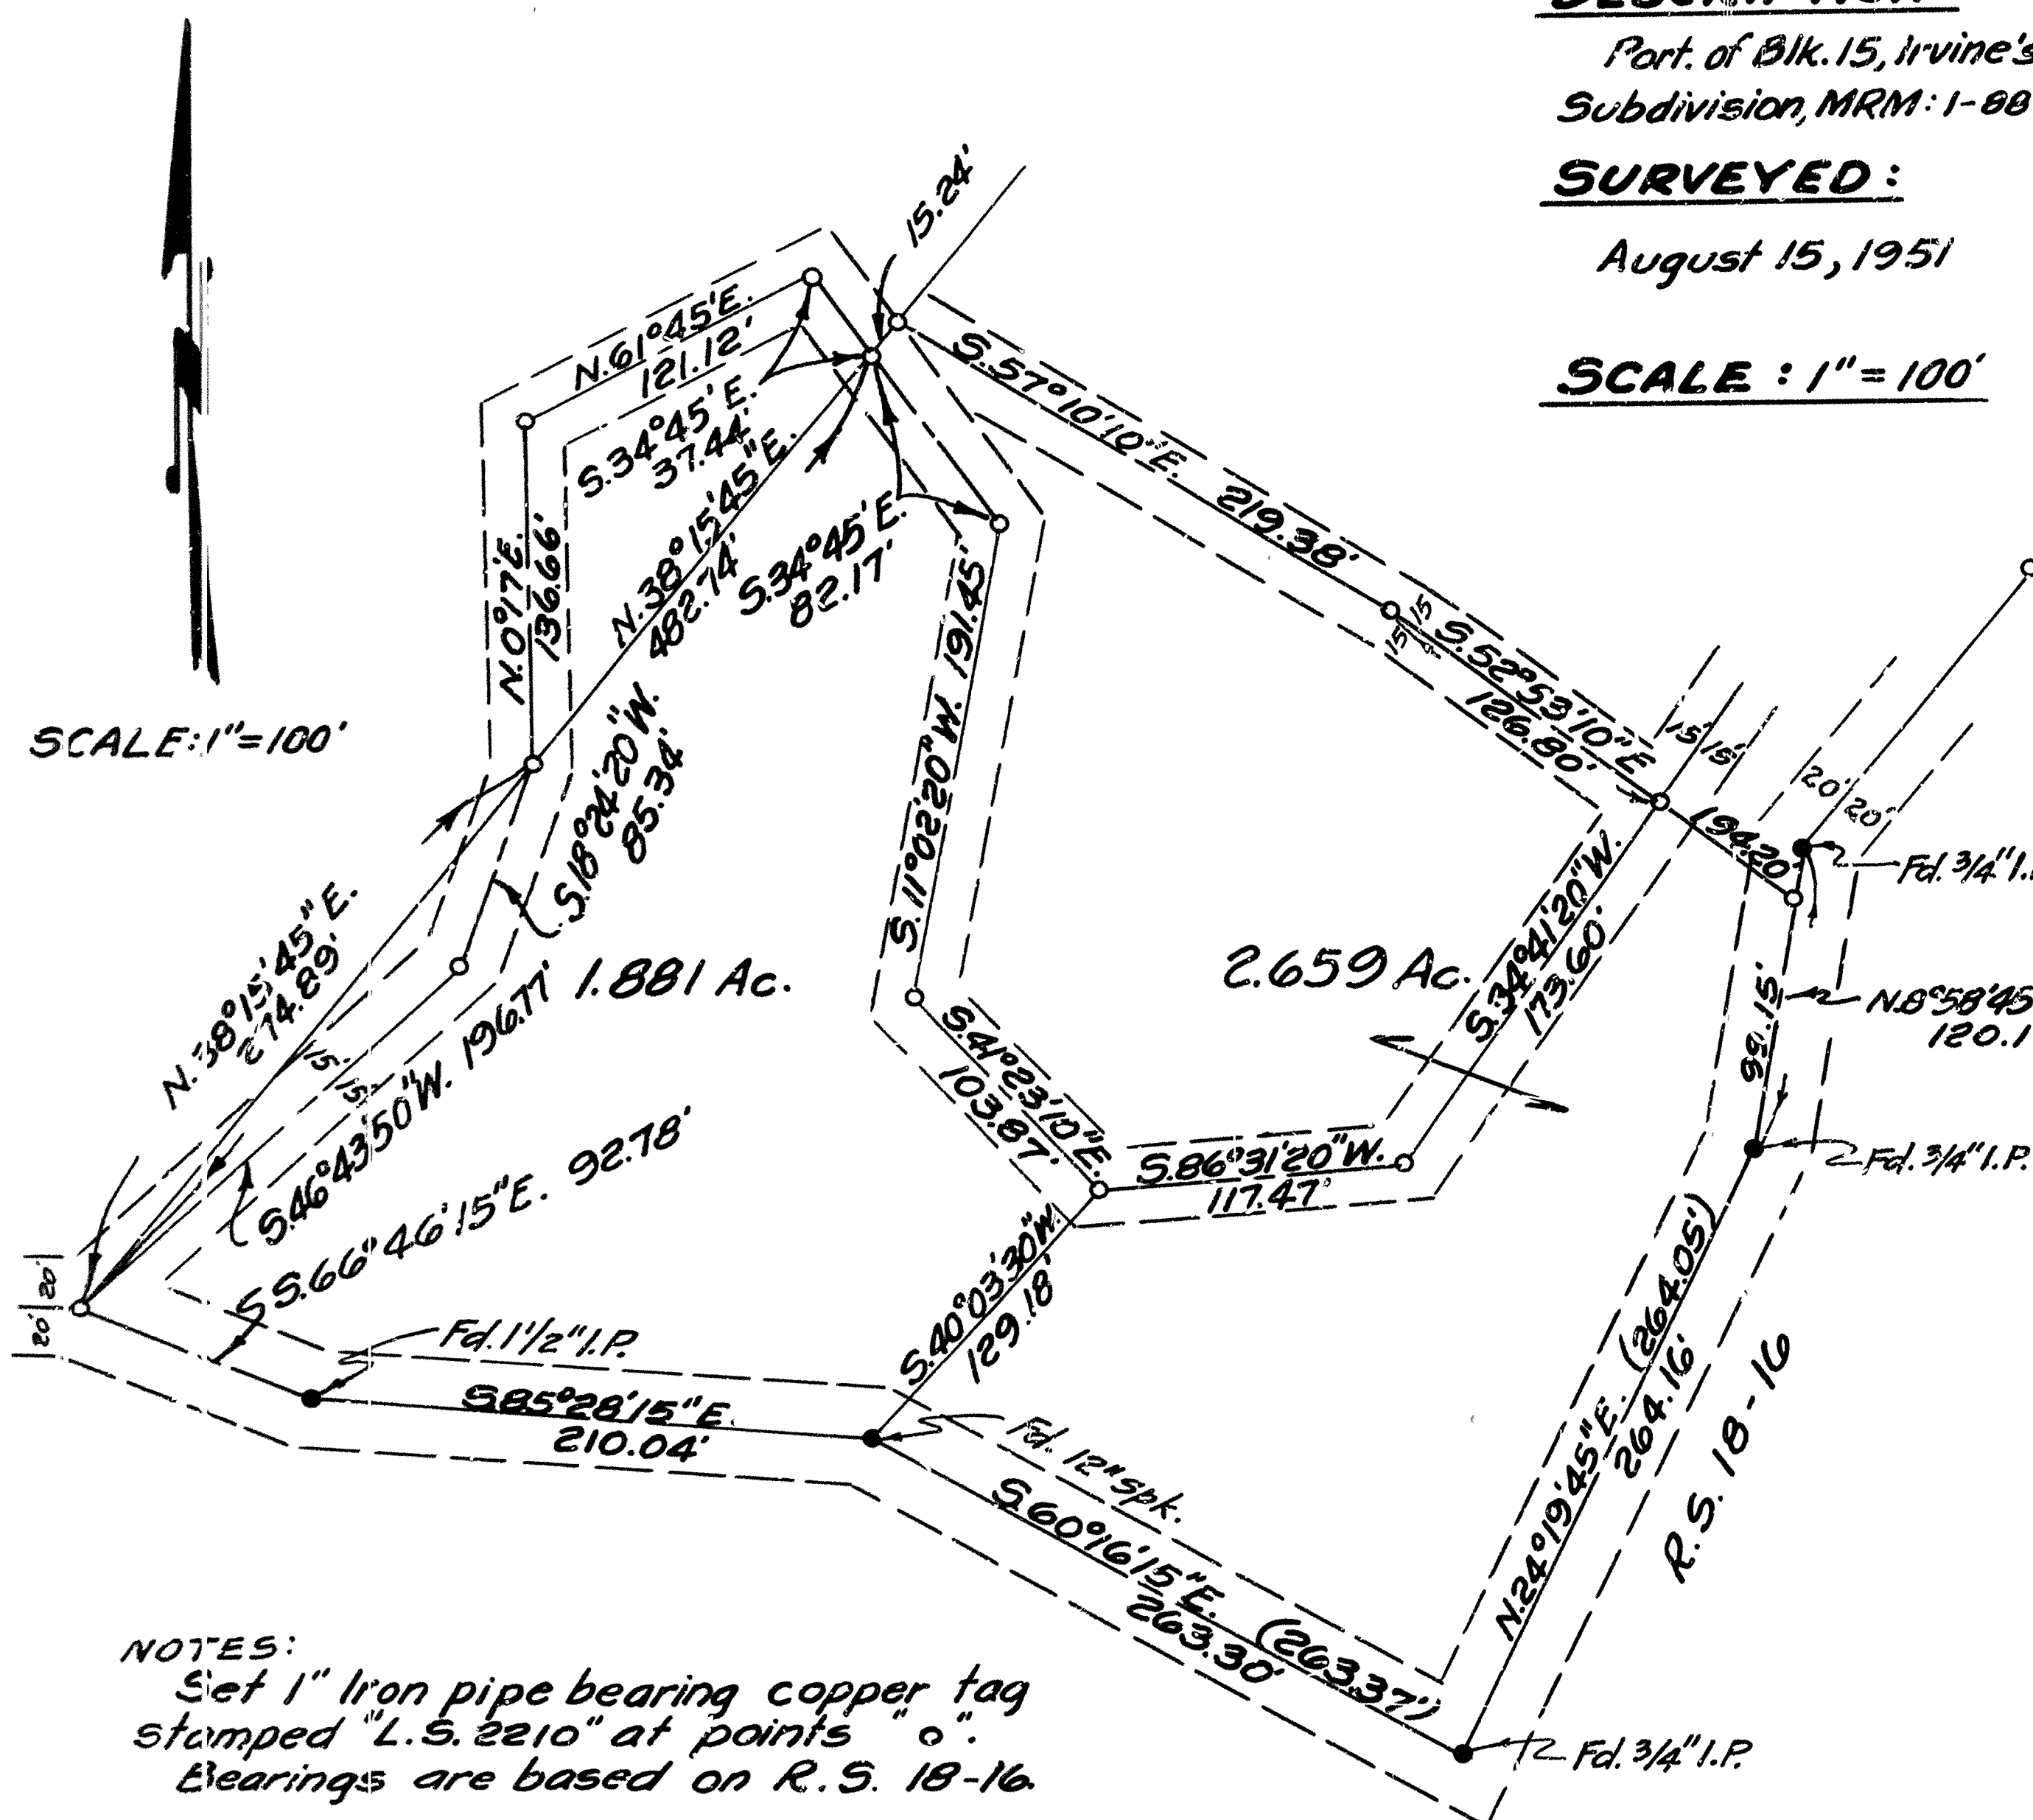

NOTES:
Set 1" Iron pipe bearing copper tag
stamped "L.S. 2210" at points "o".
Bearings are based on R.S. 18-16

60-23

OWNER:

Orange Park Acres, Inc.


DESCRIPTION:

Port. of Lots 79 & 84,
Tr. No. 918, MM: 28-41-43,
inc.

SURVEYED:

Oct. 3, 1951

SCALE : 1" = 200'

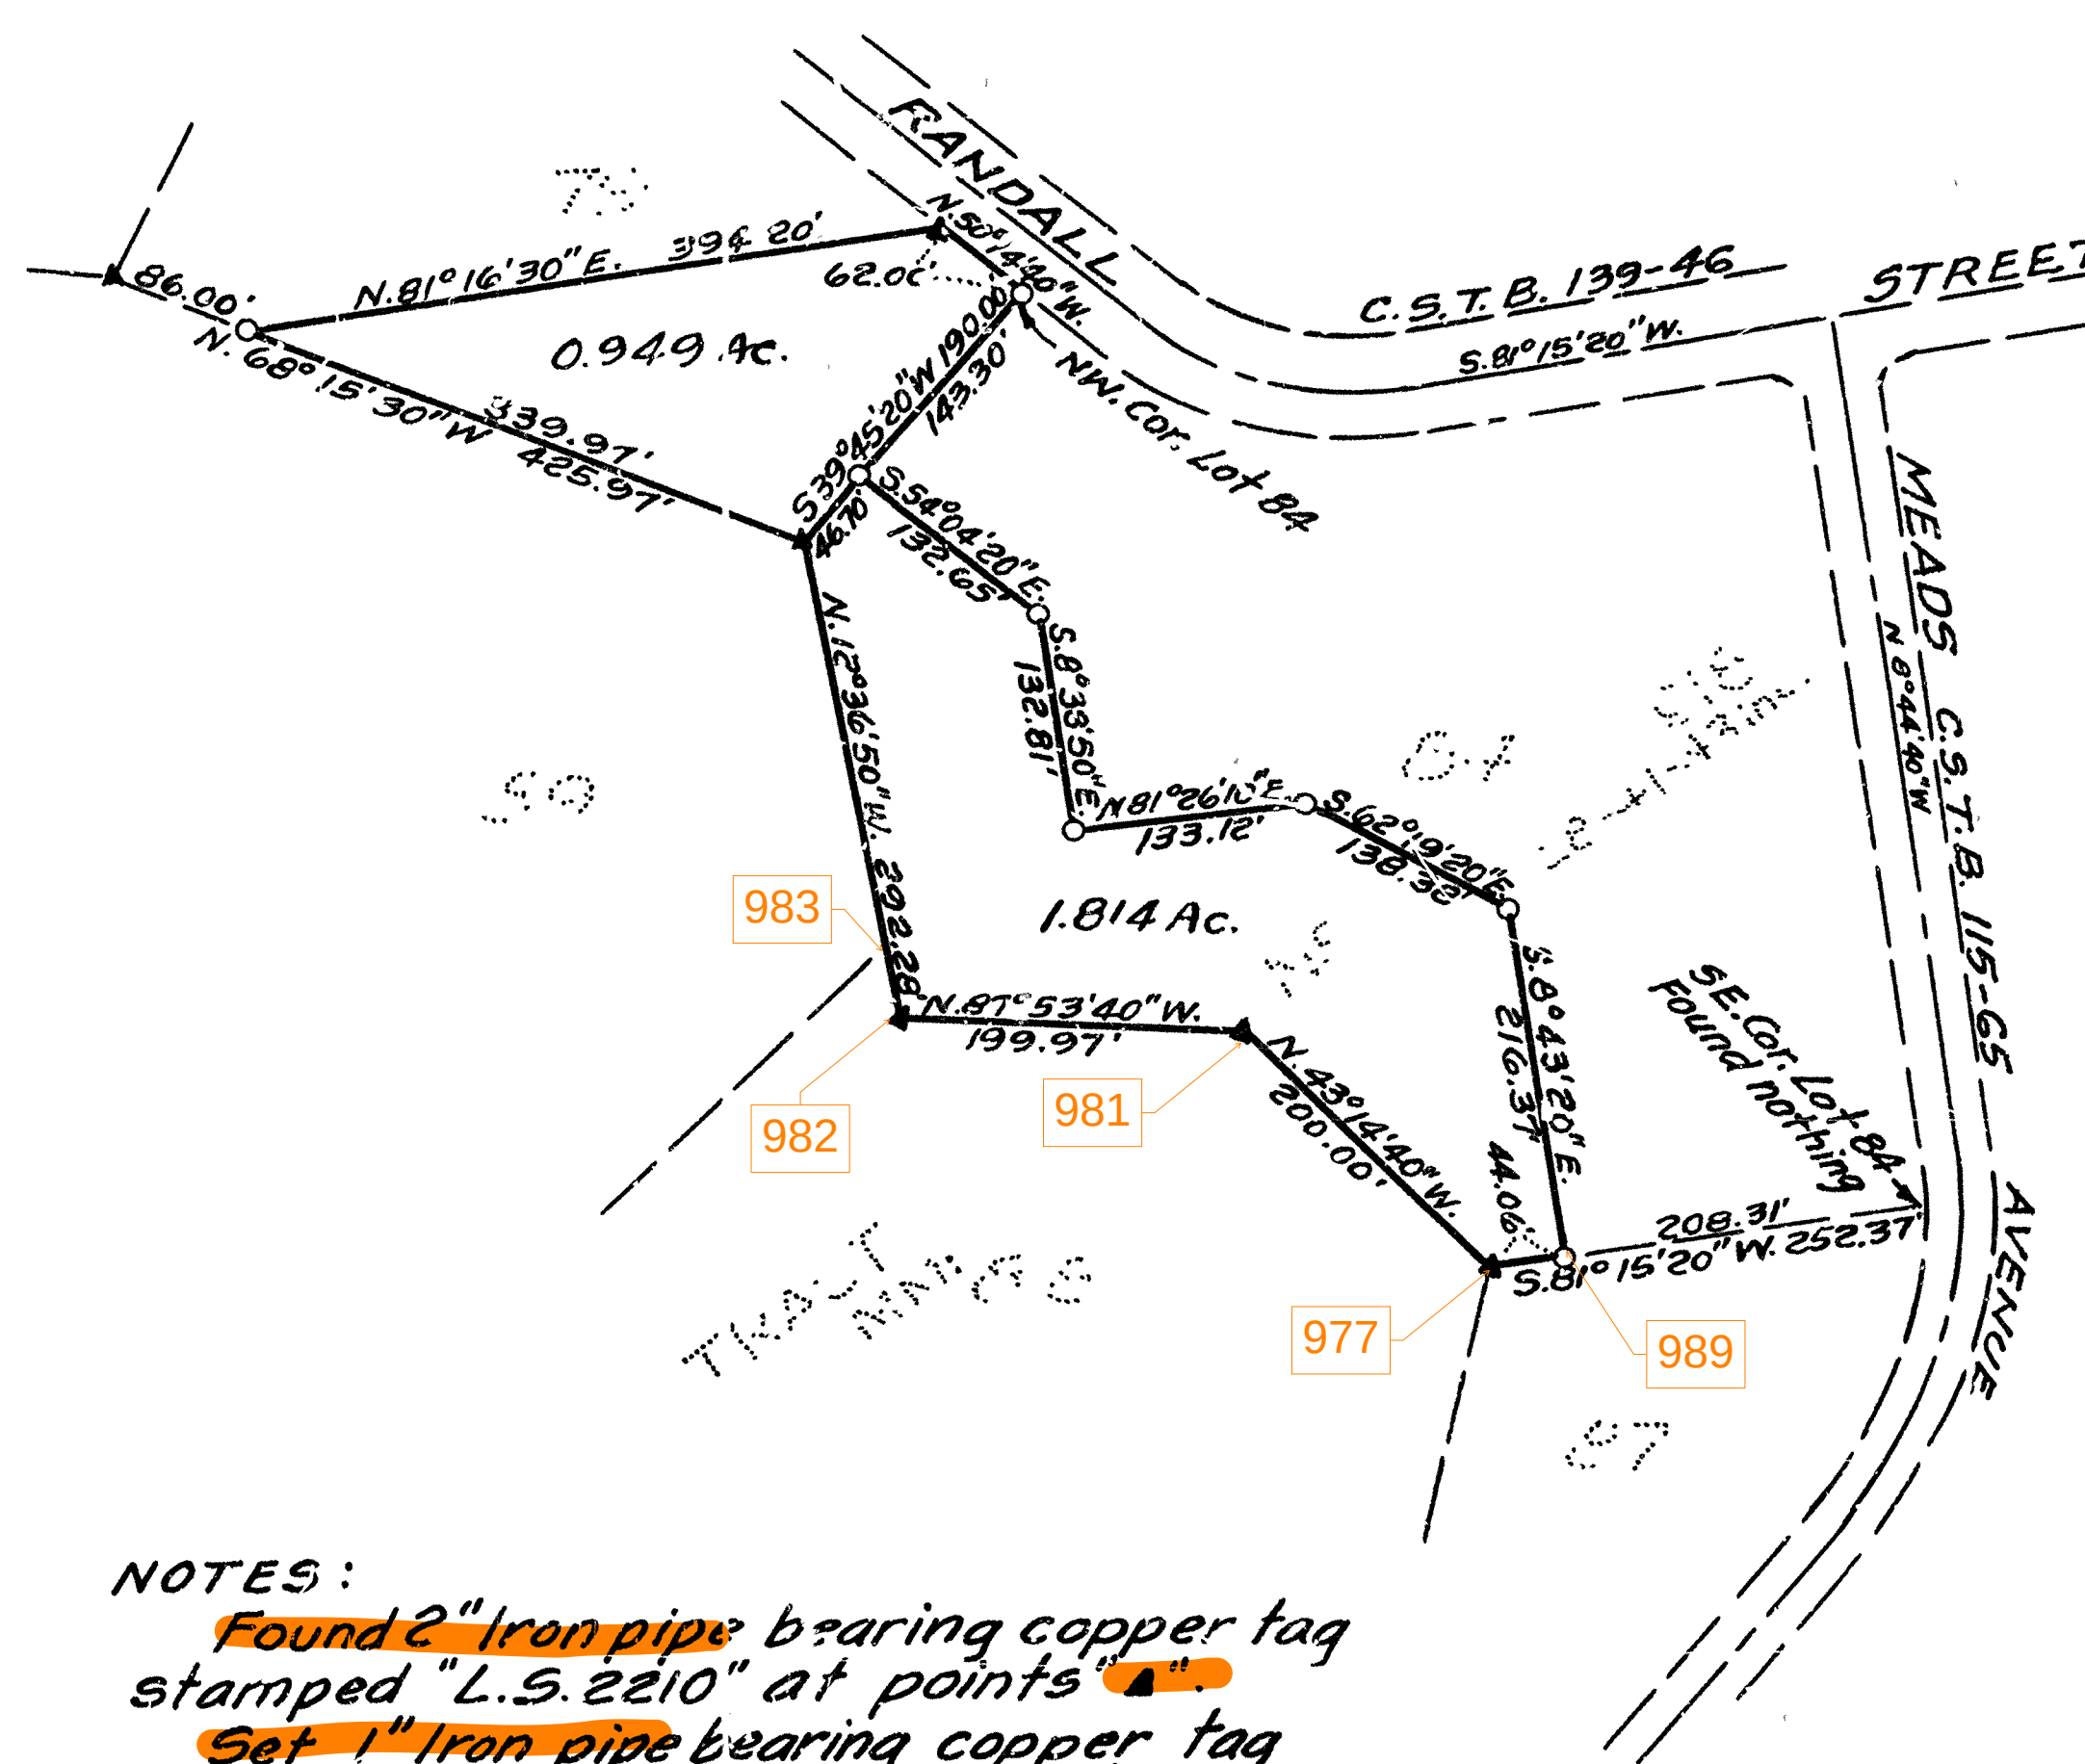

NOTES:
Found 2" Iron pipe bearing copper tag stamped "L.S. 2210" at points **a**.
Set 1" Iron pipe bearing copper tag stamped "L.S. 2210" at points **c**.
Bearings are based on (5.81'5"±0.1") as per 514 line of Lot 84, Tr. No. 918, MM: 28-41-43inc.

60-29

OWNER:

Lovie Tetzlaff, Esitate


DESCRIPTION:

Ports. of SE $\frac{1}{4}$ of Sect. 7 &
NE $\frac{1}{4}$ of Sect. 18, T. 4 S.,
R. 9 W., S. B. B. & M.

SURVEYED:

Sept. 19, 1951.

SCALE : 1" = 200'

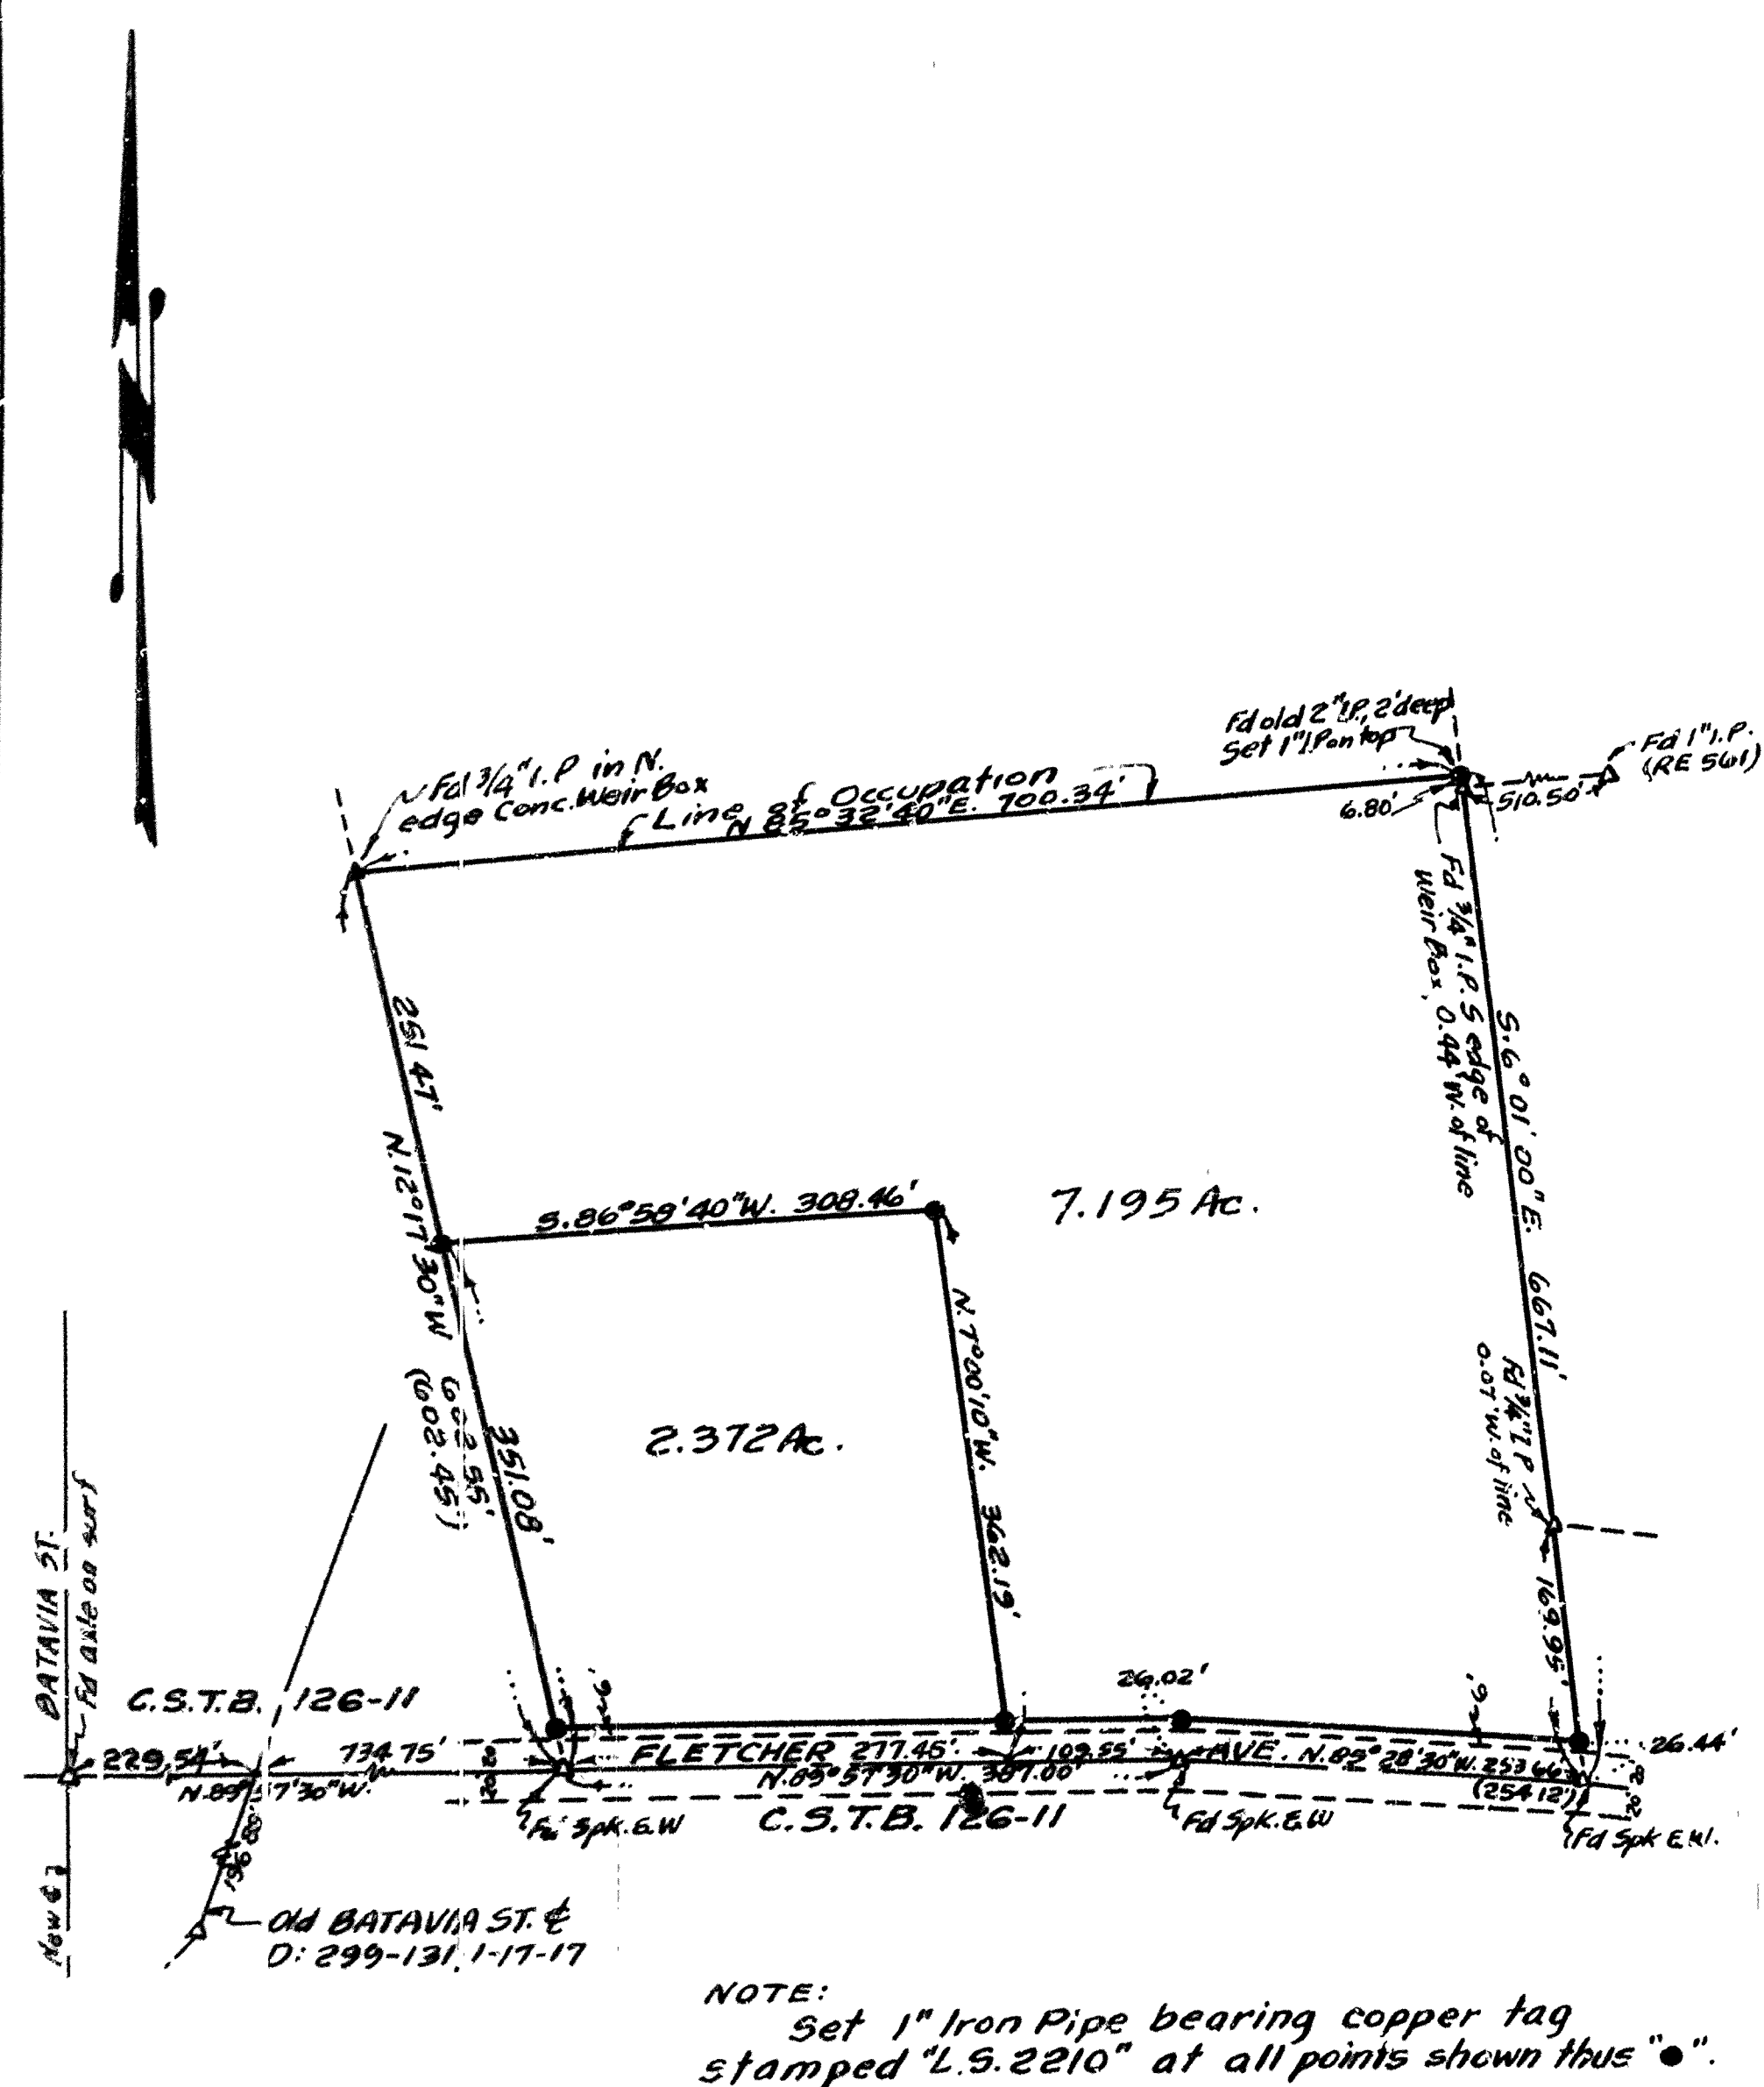

NOTE:
Set 1" Iron Pipe bearing copper tag
stamped "L.S. 2210" at all points shown thus "●"

60-27E28

OWNER :

Fred S. Chapman


DESCRIPTION:

Ports. of Sect. 23 & 24,
T.4S., R.9W., S.B.B. & M.

SURVEYED:

Sept. 13, 1951.

SCALE: 1"=200'

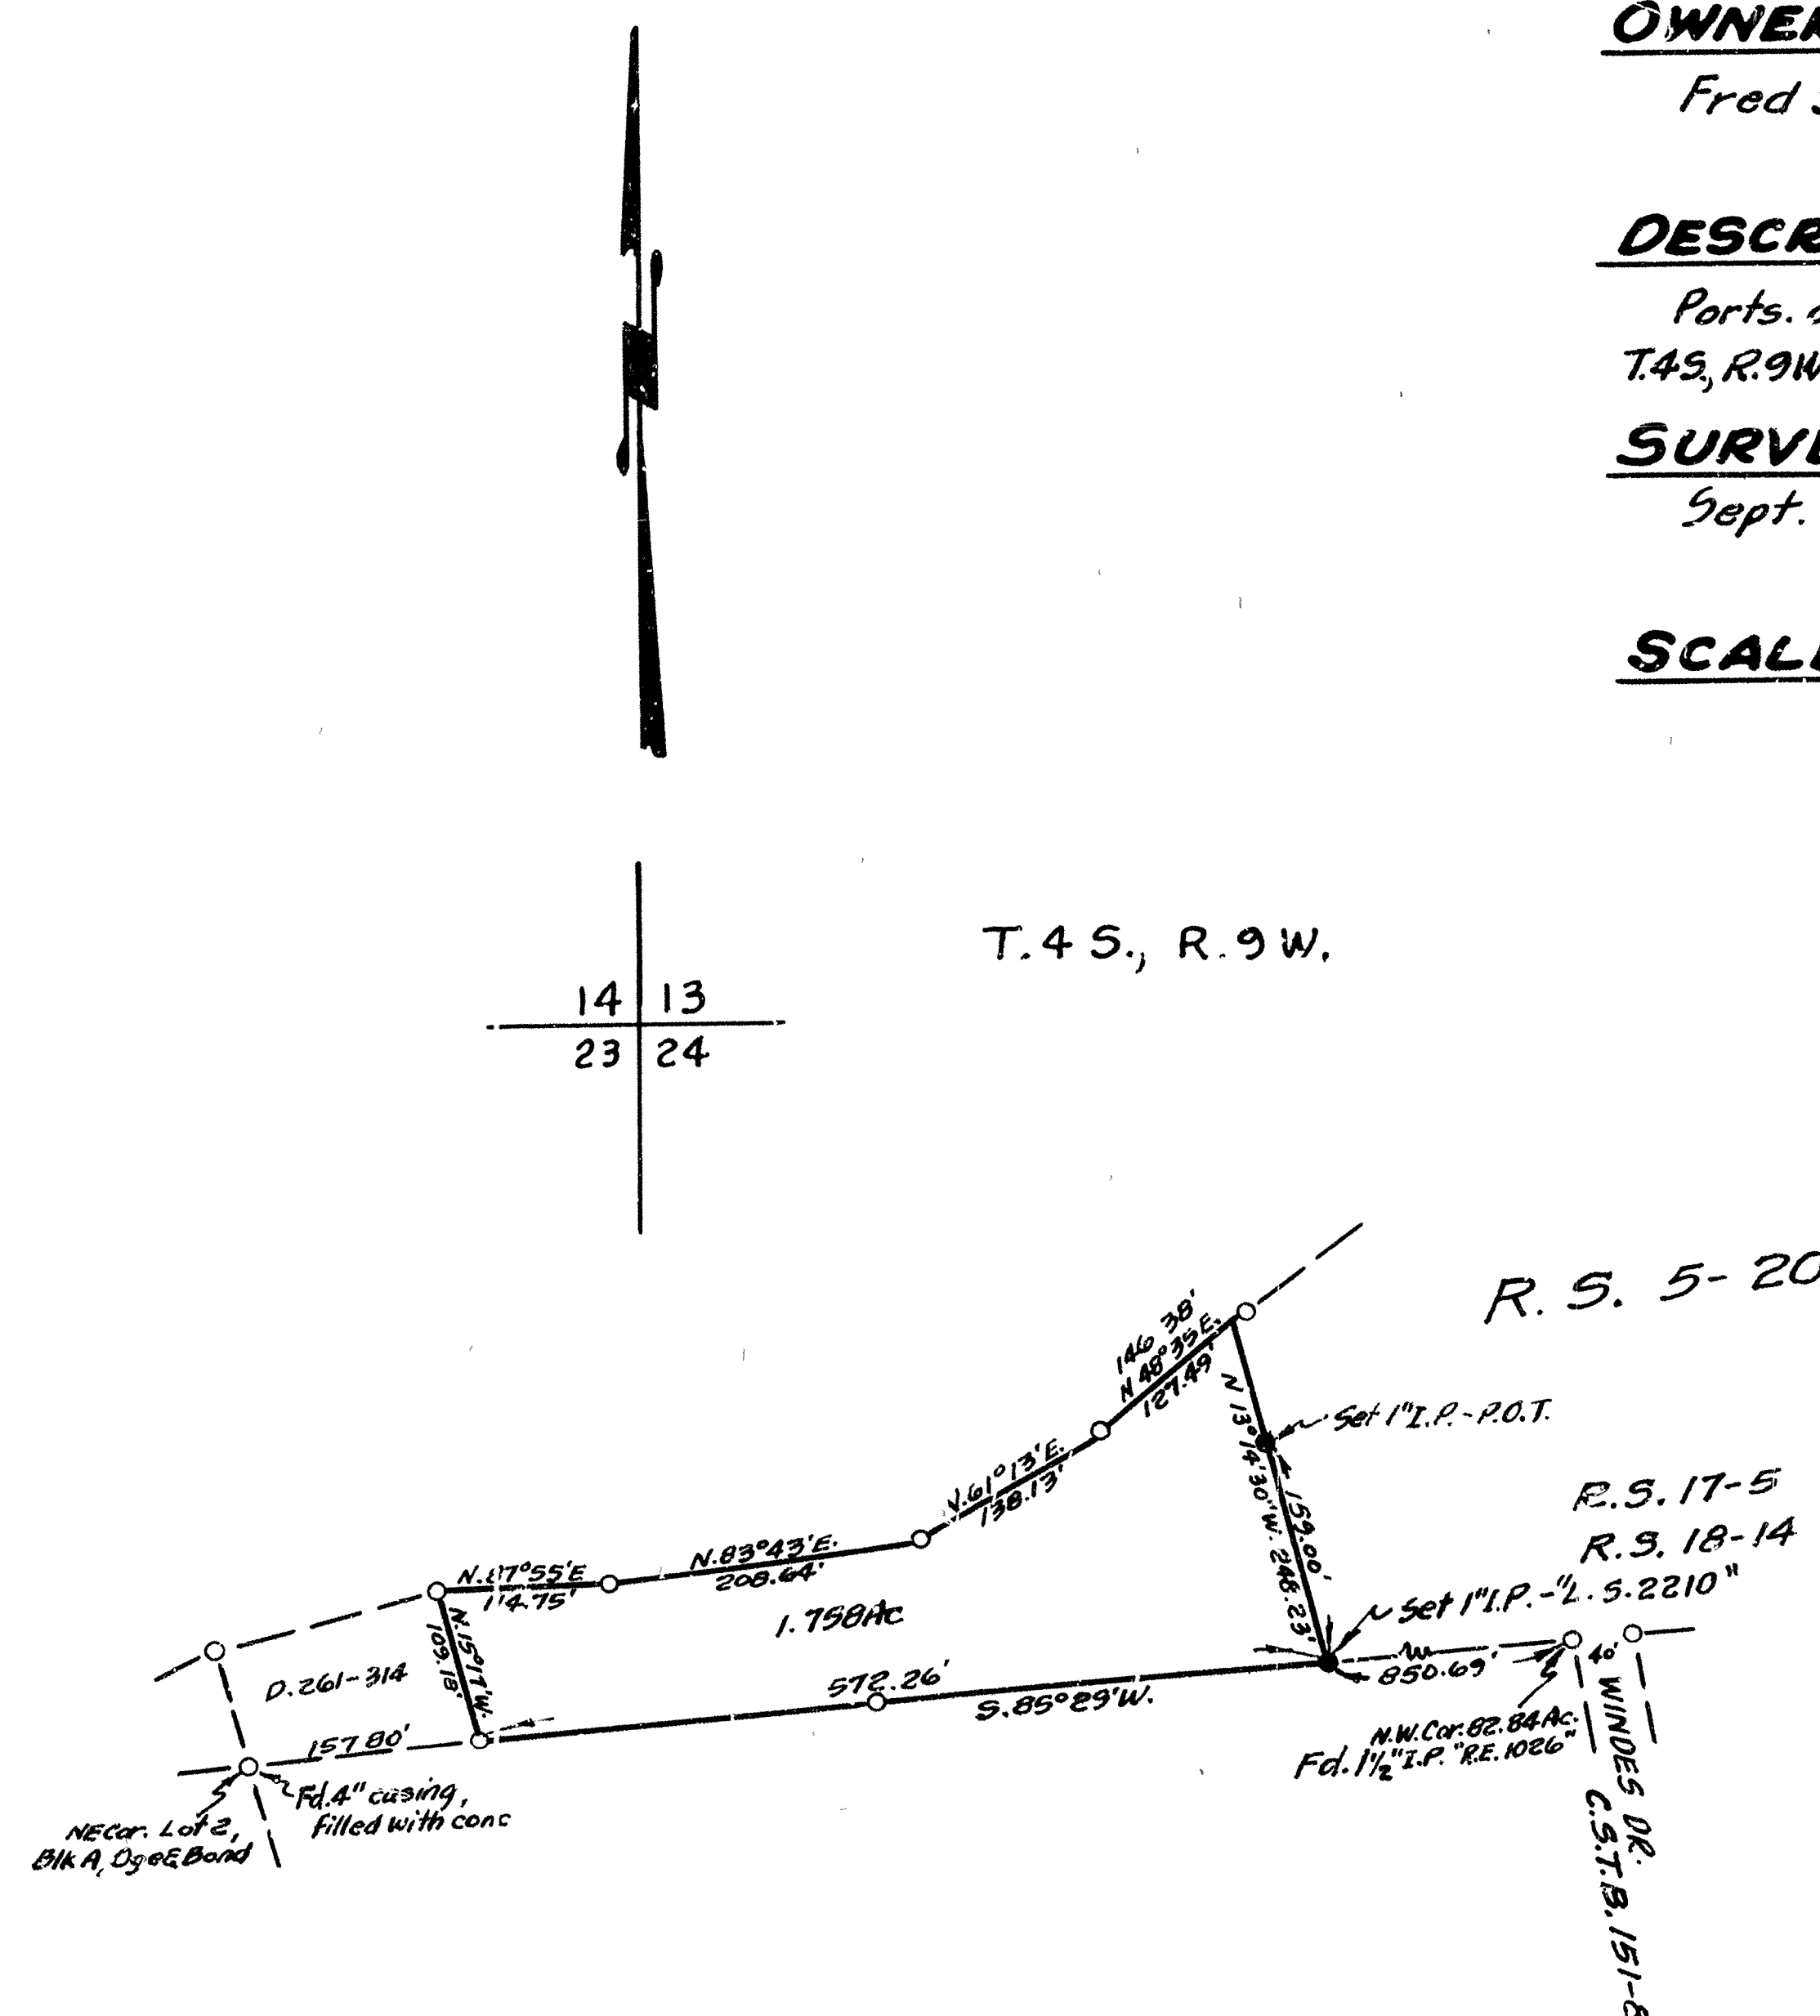

NOTES:
Bearings are based on S'y line
(S. 85° 29' W.) as per R.S. 5-20.

Examined and approved this
28th day of November ---

J. E. Lloyd
Deputy County Surveyor

I, D.D. Hillyard, certify: That I am a Licensed Surveyor in the State of California, No. 2210; that this map consisting of one sheet, represents surveys made under my supervision at the request of the Owners; and that all monuments shown actually existed at the time of the survey and their position is correctly shown. A dollar

shown.

W. A. Hayward
Licensed Surveyor.