

R.S.T. 1653

RECORD OF SURVEY

IN UNINCORPORATED TERRITORY, ORANGE COUNTY, CALIFORNIA


BEING A PORTION OF THE SOUTH ONE-FIFTH OF LOT 95 AND THE NORTH TWO-FIFTHS OF LOT 96 OF TRACT N^o 918, ORANGE PARK ACRES, AS SHOWN ON A MAP RECORDED IN BOOK 28, PAGES 41, 42 AND 43 OF MISCELLANEOUS MAPS, RECORDS OF ORANGE COUNTY, CALIFORNIA.

INDEXED

15544 OCT 18 1962

FILED FOR RECORD THIS DAY OF
 1. 20. 2. M IN BOOK 6.0 PAGE 3.4.
 RECORDS OF SURVEYS, COUNTY OF ORANGE,
 CALIFORNIA
 REQUEST OF COUNTY SURVEYOR
 RUBY McFARLAND, County Recorder

\$5.00

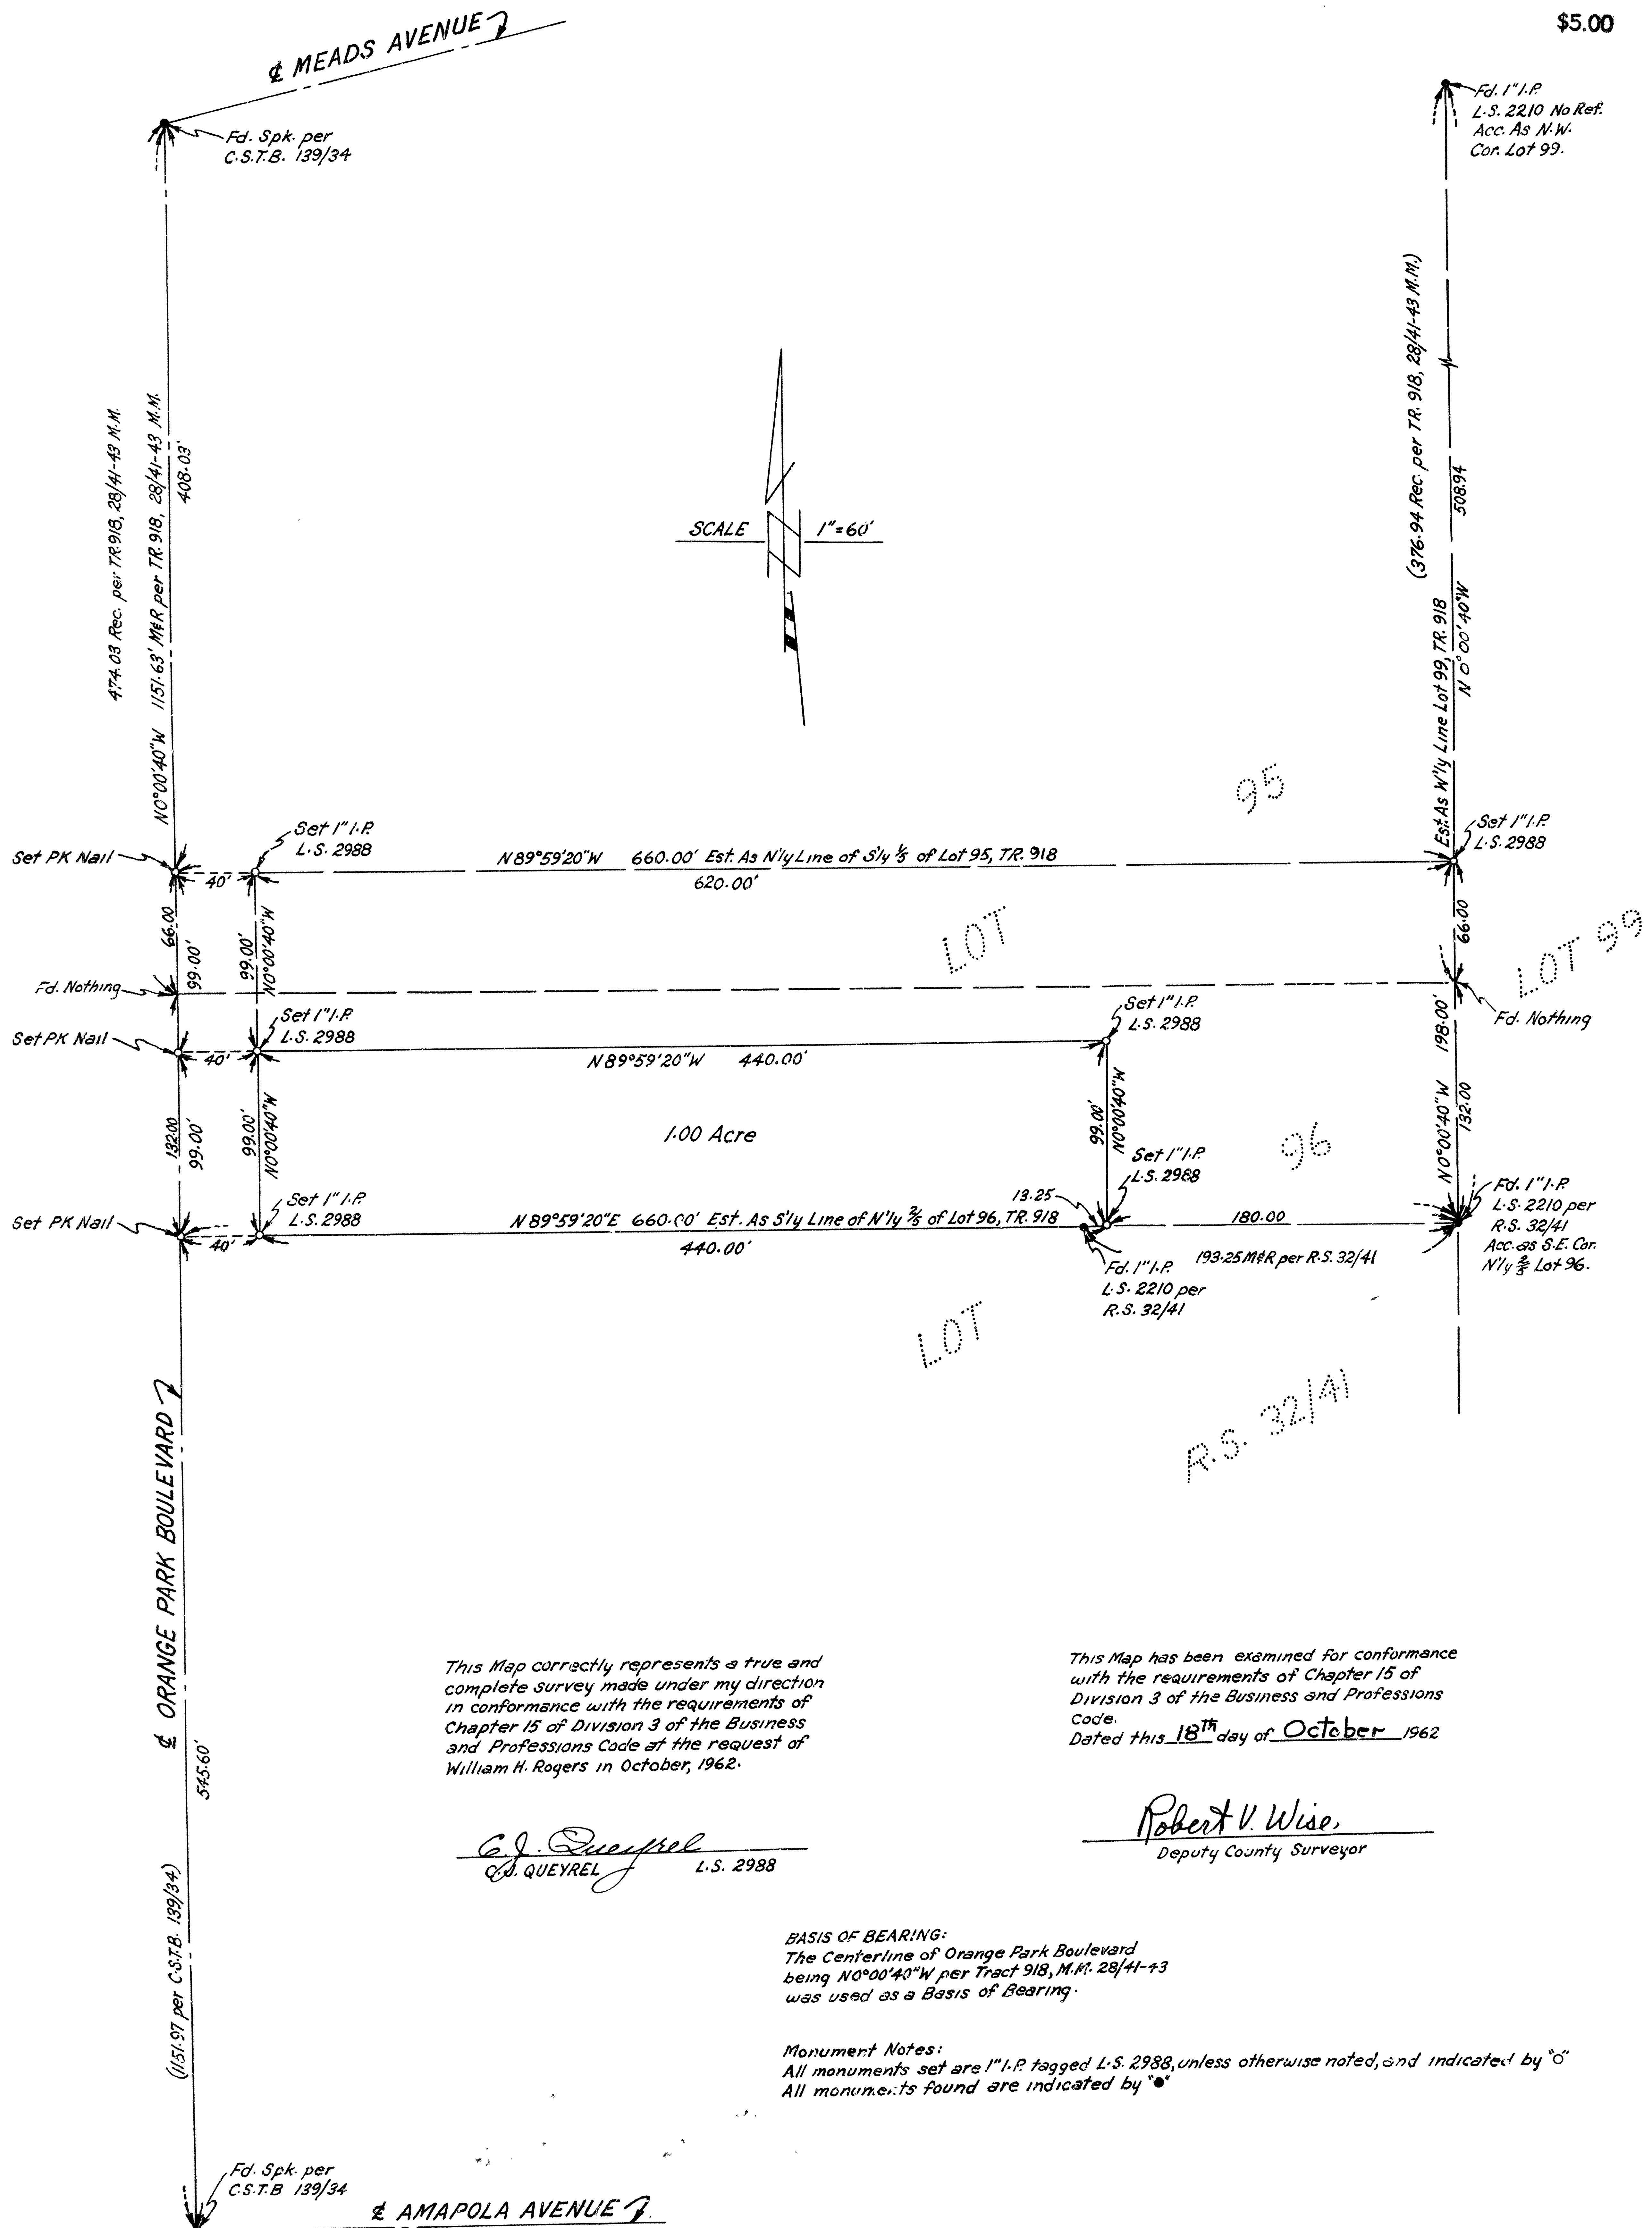

F.B. 4/57