

COUNTY SURVEY NO. 4357

MEADS AVE., RANDALL ST., KENNYMEAD ST.

FROM

ORANGE PARK ACRES RD. to OLD CO. PARK RD.

July 21, 1937

D. Hilliard
E. Hilliard
V. Wilkens

12' spk. - S'ly. end of 150' R. curve.
 59.23 SW. to tack in hub-edge of side road.
 42.21 N. to tack in hub at base of orange tree.

34" I.P.


45.95 W. to N.E.T. P. Pole
 71.44 SW. to N.E.T. Pole - 25' from N. end of row.
 13.3 E. to small Alacado.
 13.9 SW. to N.E.T. P. Pole
 13.98 S.W. to N.E.T. P. Pole

Nail

23.06 N. to N.E.T. P. Pole.
 49.00 NW. to N.E.T. P. Pole.
 65.21 SW. to " " on S.P.

SPK. at Int. 5-11-42
 N.E. to N.E.T. P. Pole.
 23.30 W. " " T. Pole.
 36.57 E. " " + on S.P. "side"
 57.32 S.E. " " " S.P.

480.00
 307.84
 787.84

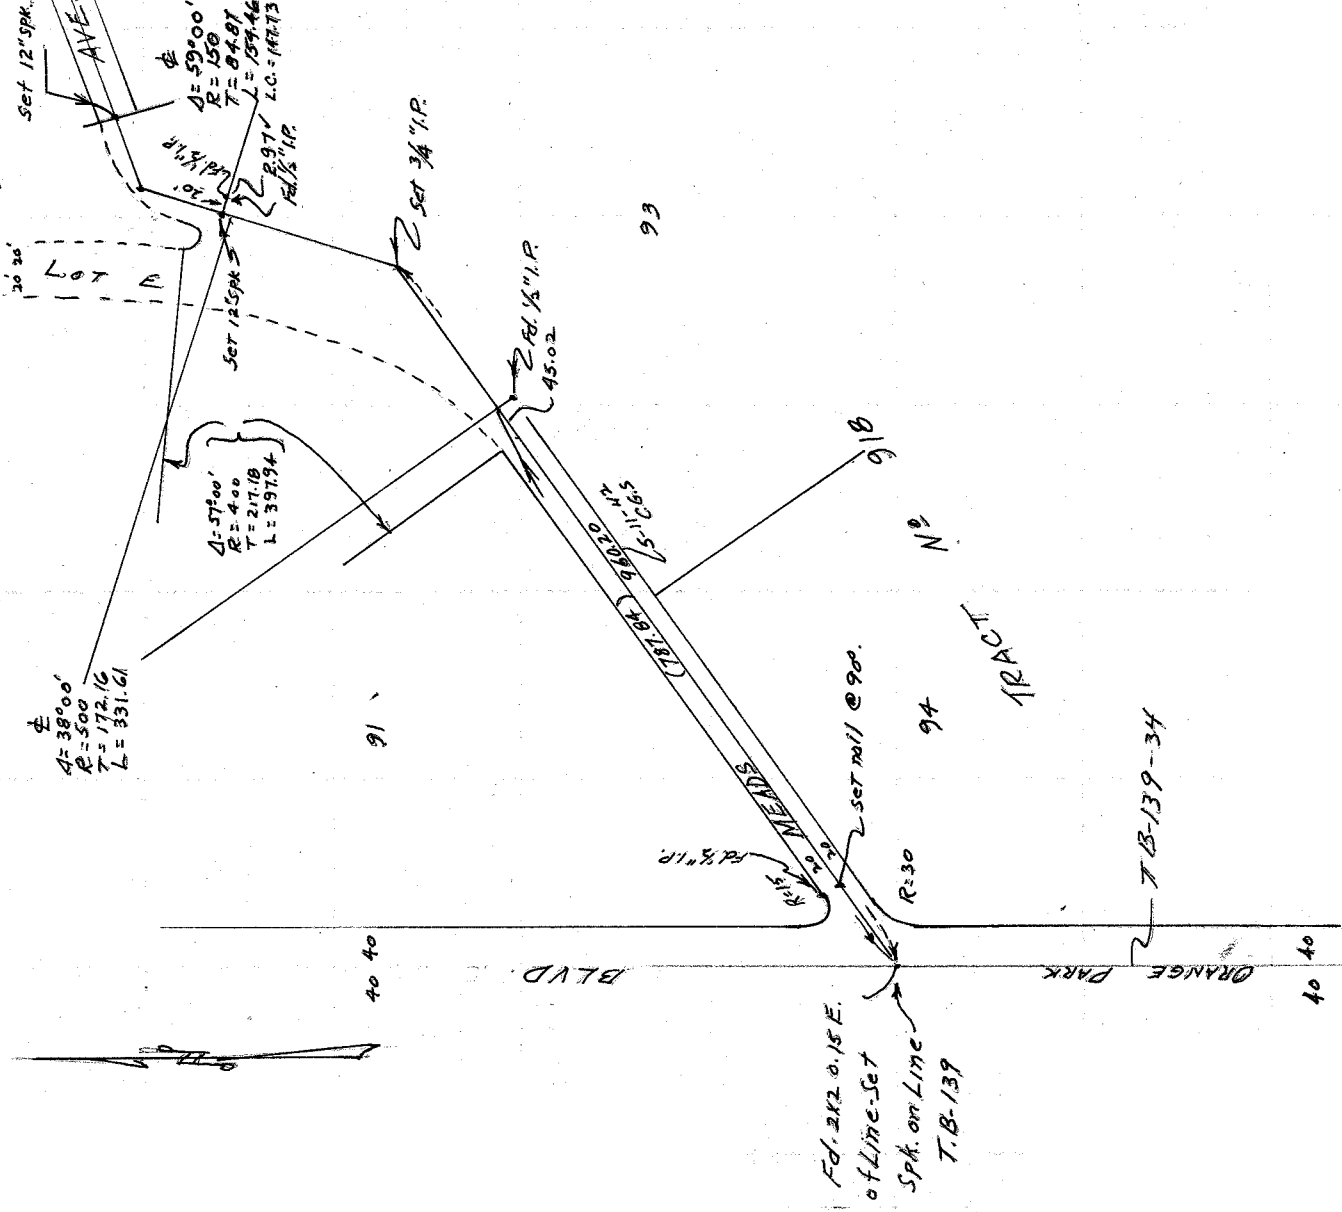

Set 1/2" pipes at points show
in red
12-3-1938
W.O.W. 694 C.S.S.

2" I.R.

53.21 SE to N.E.T. end Gum tree.
47.53 SW to " " on tall S.P.
68.74 S-35° to N.E.T. T. Pole.
22.0 S. to Gum Tow E.
78.41 ESE to N.E.T. T. Pole
84.22 N.W. " " P. "

12" spk.


37.11 W. to handle of valve in standpipe.
51.72 NW " " " "
54.37 NE to N.E.T. Tel. pole.


12" spk.

45.70 NE to center of
26.00 N. to N.E.T. Gum.
86.75 SW to N.E.T. Trans. pole.

3/4" I.R. at P.I.

67.05 NW to N.E.T. R. Pole.
64.36 E-SE to " " on side of pipe for F.H.
30.84 N. to " " N.W. end of 4 1/2" galvert.

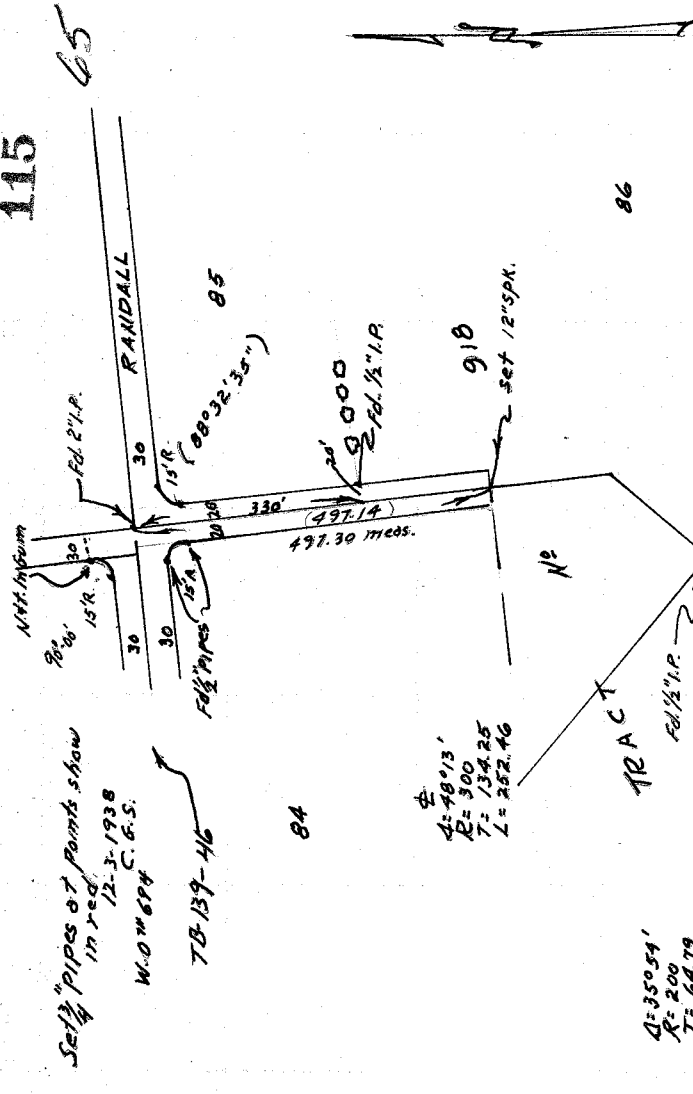

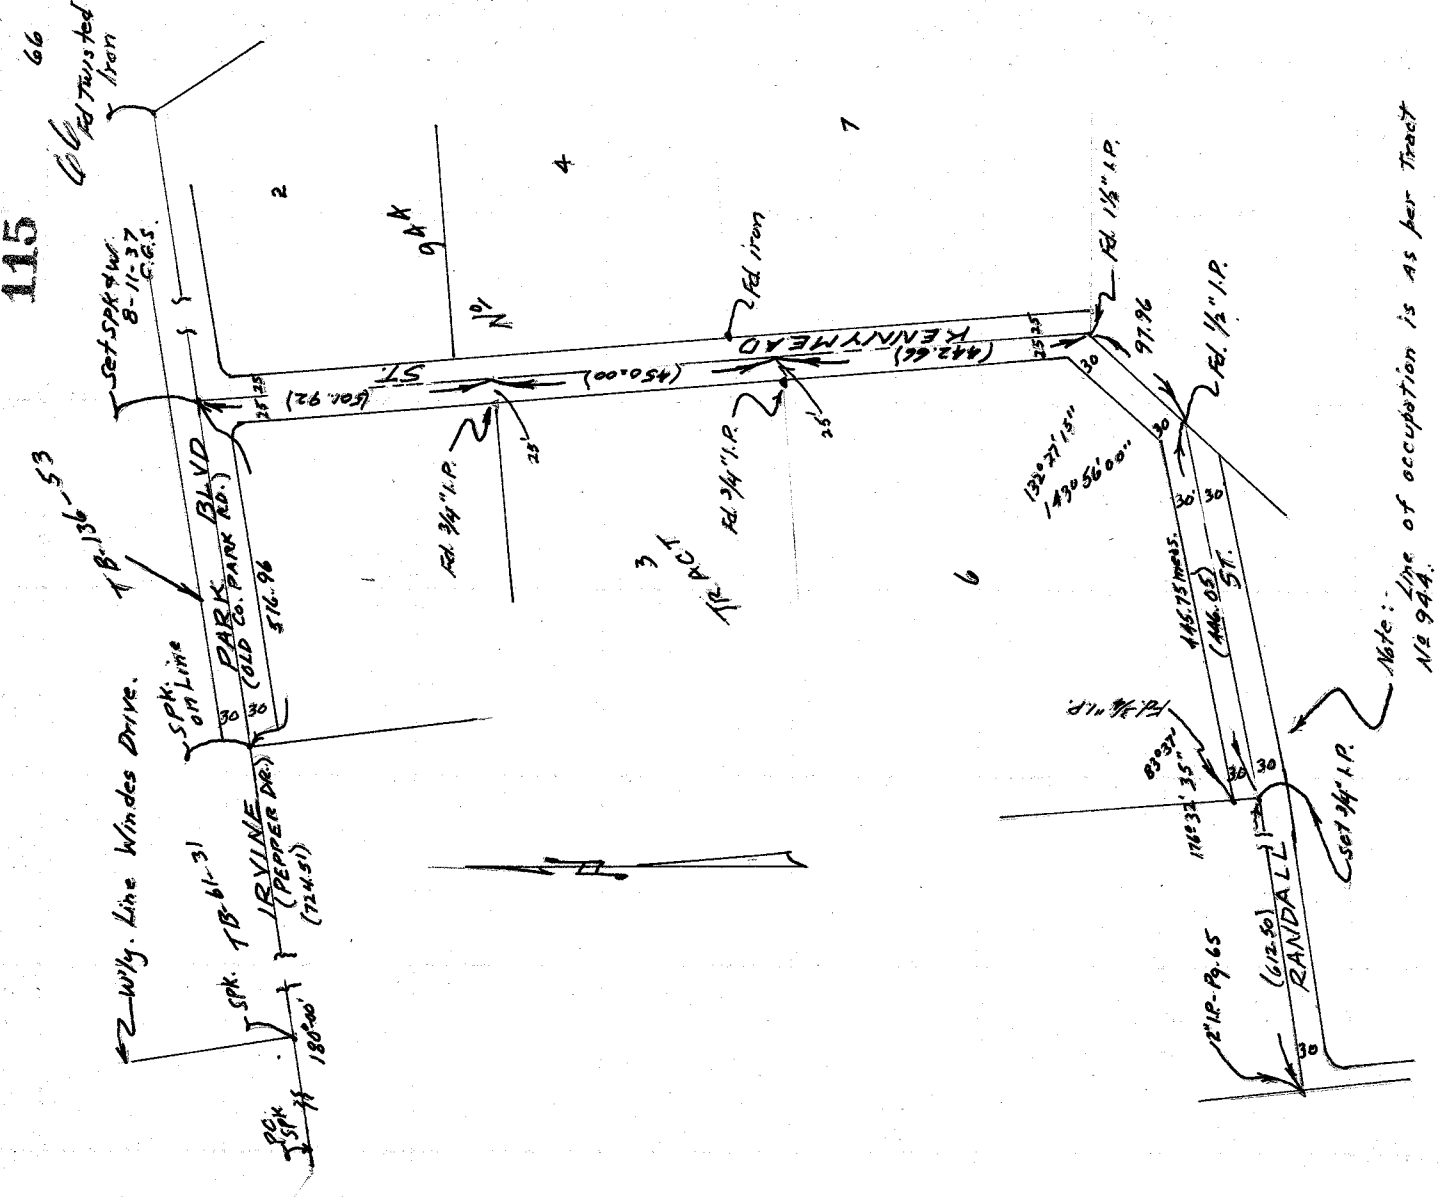

1 1/2" I.P.

33.60 N.E. to N.E.T. Guard post.
55.75 NW. to N.E.T. Gun fire.
50.34 N. to 4" on end of C.P. - North.
30.95 N.E., N.E.T. P. hole

$\frac{1}{2}$ " I.P.
 59.45 NE. to " on Wily. end of C.I.P. - North.
 54.18 E-SE. to N.E.T. Pole.
 55.82 SW. to N.E.T. Gum Tree - 5th
 22.55 NE. " " P. Pole

3 1/4" I.P.

39.85	W. to Center of Valve in S.P.
37.15	W. to N.E.T. Pole
25.36	S. to Short off Valve in S.P.