

CORNER RECORD

Agency Index

Document Number

2022-3009


City of ORANGE

County of ORANGE, California

Brief Legal Description RANDALL STREET & MEADS AVENUE

CORNER TYPE

COORDINATES (Optional)

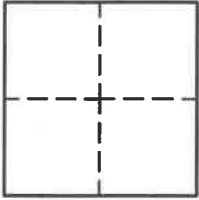

- ☐ Government Corner ☒ Control
☐ Meander ☐ Property
☐ Rancho ☐ Other

N. _____ E. _____

Elevation _____

Units ☐ Metric ☒ U.S. Survey Foot

Horizontal Datum _____

Zone _____ Epoch Date _____

Vertical Datum _____

☐ Complies with Public Resources Code §§8801-8819

☐ Complies with Public Resources Code §§8890-8902

PLS Act Ref: ☐ 8765(d) ☒ 8771 ☐ 8773 ☐ Other:

Corner/
Monument: ☒ Left as found ☐ Established ☐ Rebuilt ☐ Pre-Construction
☐ Found and tagged ☐ Reestablished ☐ Referenced ☒ Post-Construction

Narrative of corner identified and monument as found, set, reset, replaced, or removed:

☒ See sheet #2 for description(s):

SURVEYOR'S STATEMENT

This Corner Record was prepared by me or under my direction in conformance with the Professional Land Surveyors' Act on 10/3/2022

Signed [Signature] P.L.S. or R.C.E. No. 5411



COUNTY SURVEYOR'S STATEMENT

This Corner Record was received _____

and examined and filed _____

Signed _____ P.L.S. or R.C.E. No. _____

Title _____


County Surveyor's Comment _____

REFERENCE NOTES:

R1 = RECORD DATA PER CORNER RECORD 2022-1937
 M = MEASURED
 ϕ = TANGENT OVER

**POST-CONSTRUCTION
CORNER RECORD**

PARCEL LINES/ LOT LINES/
 PARCEL #/ LOT #: ARE SHOWN
 HEREON FOR GRAPHICAL
 REPRESENTATION ONLY.

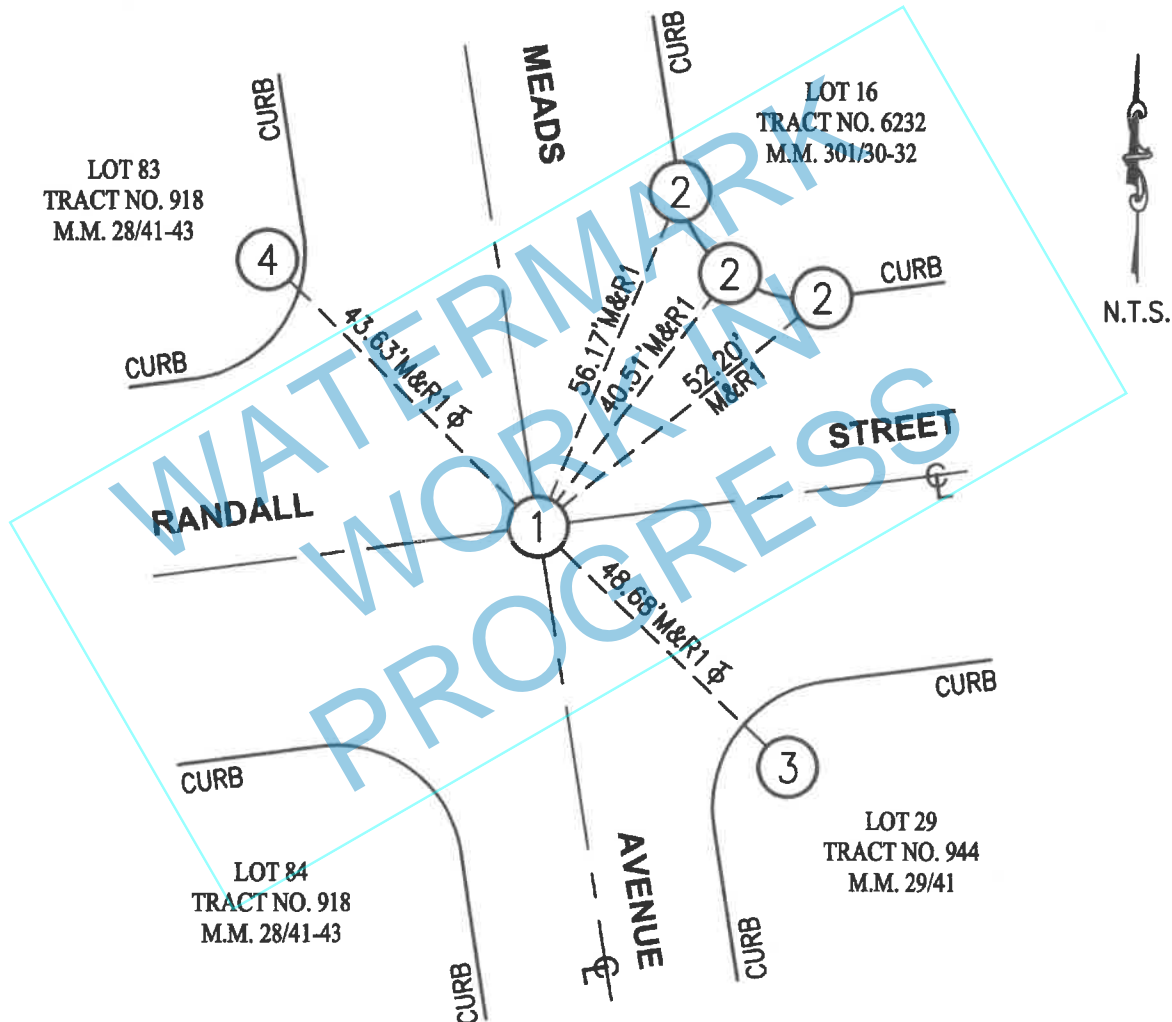**MONUMENT NOTES:**

- ① FD SPIKE & WASHER STAMPED "OCS" PER TIES ON R1, FLUSH, AFTER CONSTRUCTION.
- ② FD LEAD, TACK & TAG "LS 5411" IN TOP OF CURB PER R1.
- ③ FD LEAD, TACK & TAG "OCS TIE" IN CONCRETE PER R1.
- ④ FD 1" IRON PIPE TAGGED "OCS TIE" IN WELL MONUMENT PER R1.

THE PURPOSE OF THIS RECORD IS TO DOCUMENT THE PERPETUATION OF FOUND MONUMENT(S) PURSUANT TO THE PLS ACT SECTION 8771.
 NO CLAIM IS MADE REGARDING THE CORRECTNESS OF THE POSITION(S) OF SAID MONUMENT(S), NOR THE DIMENSIONAL RELATIONSHIP TO
 STREET CENTERLINES OR PROPERTY BOUNDARIES.

22-CTT-584 AT