

30-15

30-15


RECORD OF SURVEY

OF A PORTION OF LOT 36 OF TRACT NO. 440, HEWES PARK TRACT AS SHOWN ON A MAP THEREOF RECORDED IN BOOK 16, PAGES 21 AND 22 OF MISCELLANEOUS MAPS, RECORDS OF ORANGE COUNTY, STATE OF CALIFORNIA.

FILED
Nov 8 - 1955
County of Orange
City of Tustin

FILE
2000

SCALE
1" = 60'
NORTH

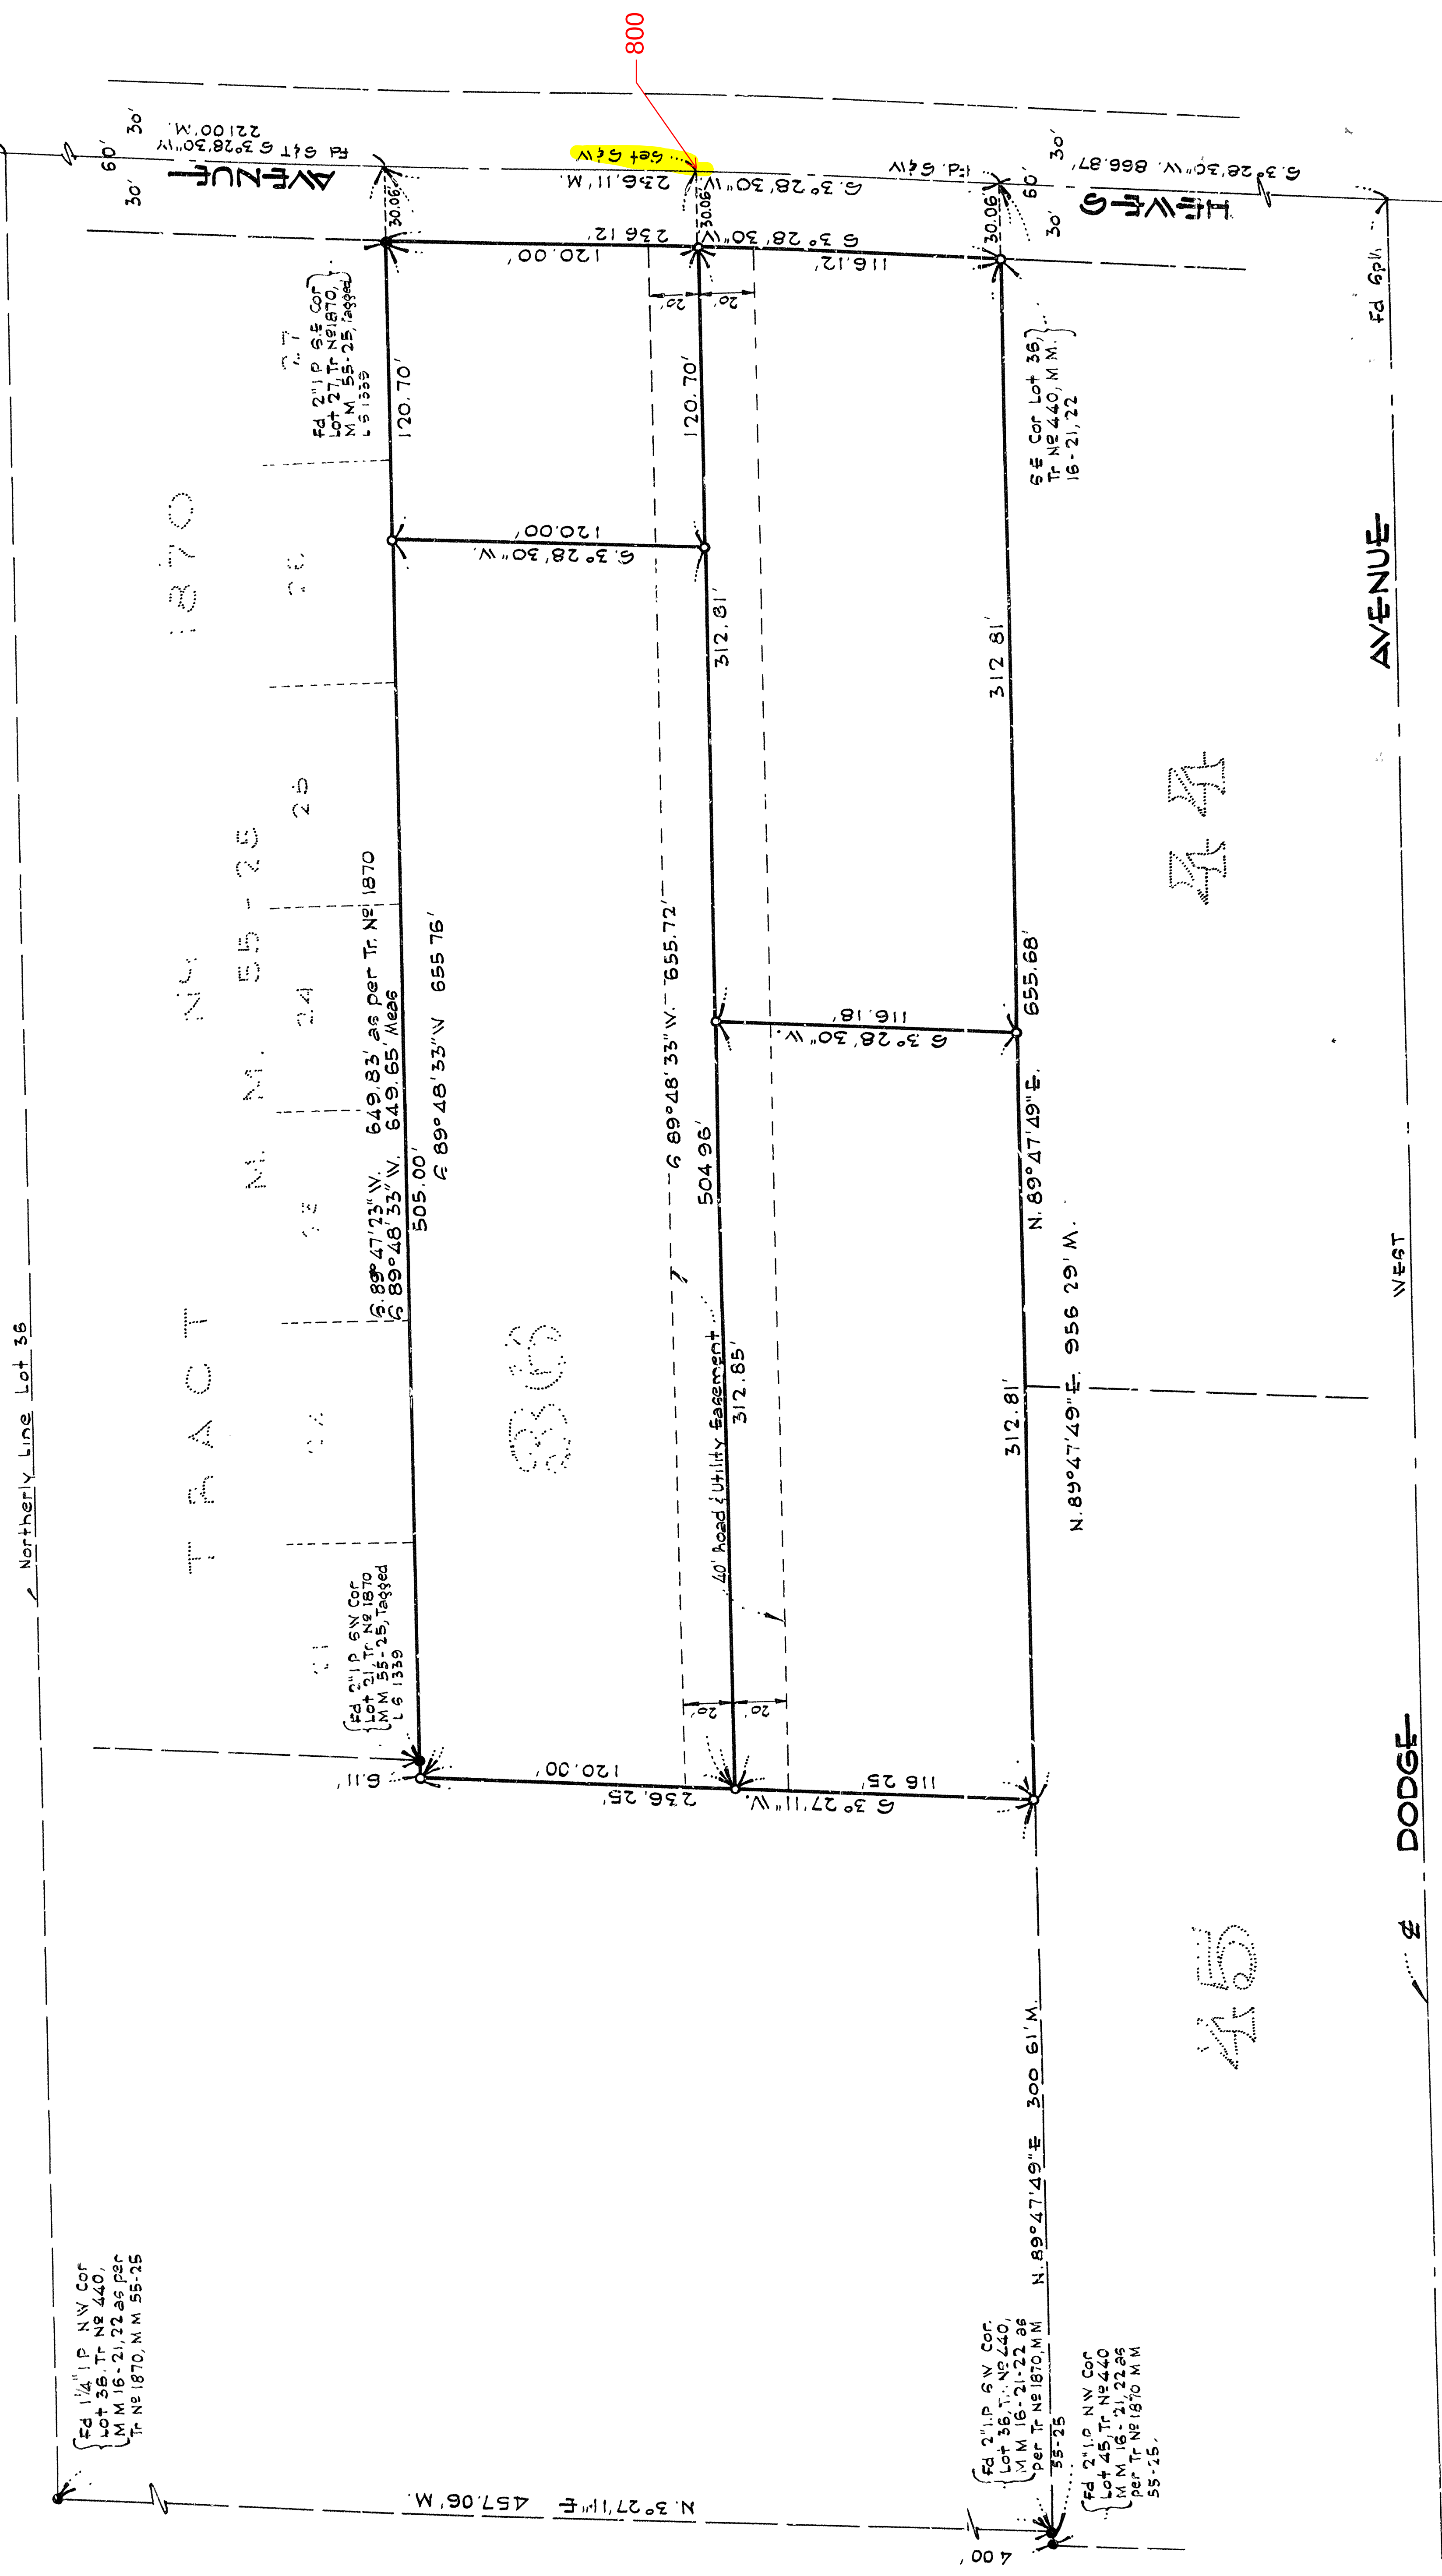

NOTES

The bearings shown on this map are based on the centerline of Hewes Ave. (S 32° 28' 30" W) as shown on a map of Tract No. 440, Hewes Park Tract, recorded in Book 16, Pages 21 and 22 of Miscellaneous Maps, Records of Orange County, California.
Get iron pipe and dish L.S. 2312 at points marked O.
found iron pipe at points marked ●

COUNTY SURVEYOR'S APPROVAL

Examined and approved this 8 day of Nov., 1955.

Alvin A. Horn
COUNTY SURVEYOR

SURVEYOR'S CERTIFICATE

I, JACK G. PAULS, hereby certify that I am a licensed Land Surveyor of the State of California, and that this map, consisting of one sheet, correctly represents a true and complete survey made under my direction in October, 1955; that the monuments are of the character and occupy the positions indicated, and that said monuments are sufficient to enable the survey to be retraced.

Jack S. Pauls

LICENSED LAND SURVEYOR

30-15