


GRID 41 OFFICE SPACE FOR CLEAR ME

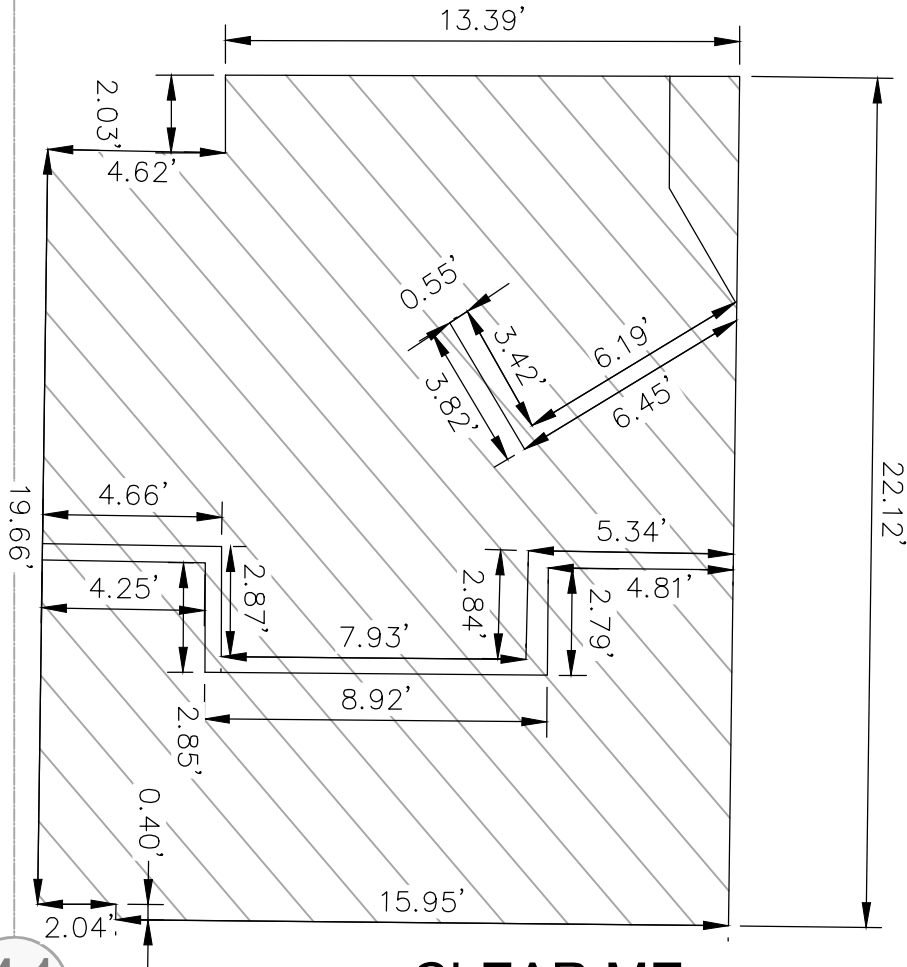


41

CLEAR ME
387 SQ FT.

42

e

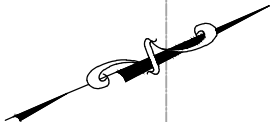

SCALE: 1"=10'

U.S. Survey
Foot
OC Public Works
OC Survey/Field Services
Boundary Analysis & Mapping

EXHIBIT A

PURPOSE:

A GRAPHIC REPRESENTATION OF THE OFFICE SPACE FOR CLEAR ME. SURVEYED, AND VERIFIED IN FIELD ON 7/10/2023. DIMENSIONS ARE BASED ON THE CENTER OF THE INTERIOR WALLS TO THE FACE OF THE EXTERIOR WALL.

COUNTY OF ORANGE
OC PUBLIC WORKS/OC SURVEY/FIELD SERVICES

OFFICE SPACE ADJACENT TO GRID 41 FOR CLEAR ME

| | |
|-------------|-------------------------|
| DATE | 07/10/2023 |
| DRAWN BY: | I. ISLAS |
| CHECKED BY: | E. MEDINA, PLS |
| W.O. # | FILE NO. 2223PW-JWA0021 |



SHEET 1 OF 1