




OC PUBLIC WORKS DEPARTMENT
JAMES TREADAWAY, DIRECTOR OF PUBLIC WORKS
KEVIN HILLS, COUNTY SURVEYOR
JOHN WAYNE AIRPORT
STRUCTURES A2 AND B2 (LEVEL 1)

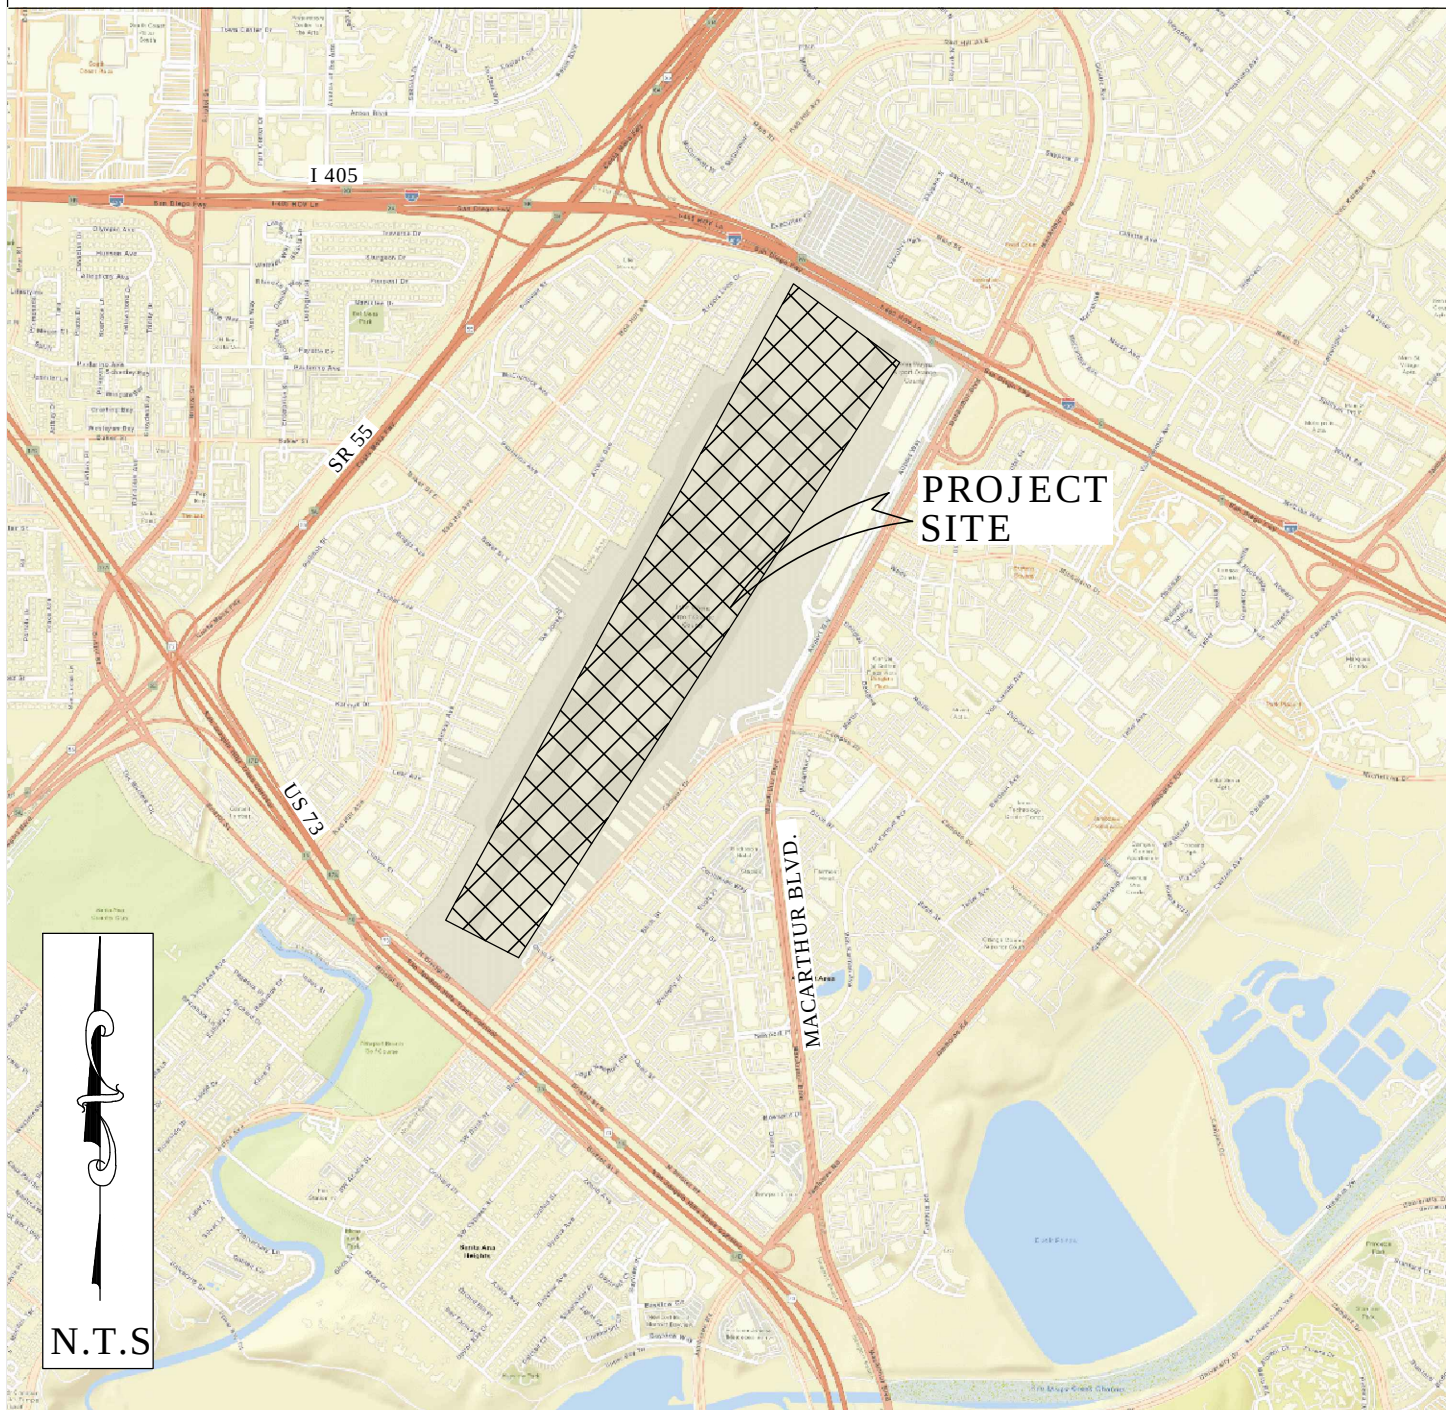

LOCATION MAP



SENIOR LAND SURVEYOR'S CERTIFICATE:

THIS MAP CORRECTLY REPRESENTS A SURVEY MADE BY ME OR UNDER MY DIRECTION IN CONFORMANCE WITH REQUIREMENTS OF THE PROFESSIONAL LAND SURVEYOR'S ACT; THIS 7 DAY OF MARCH, 2022.


ELLIOTT MEDINA, PLS. SENIOR LAND SURVEYOR



DEPUTY COUNTY SURVEYOR'S STATEMENT:

THIS MAP HAS BEEN EXAMINED IN ACCORDANCE WITH THE PROFESSIONAL LAND SURVEYOR'S ACT; THIS 7 DAY OF MARCH, 2022.

WADE WEAVER, PLS. DEPUTY COUNTY SURVEYOR

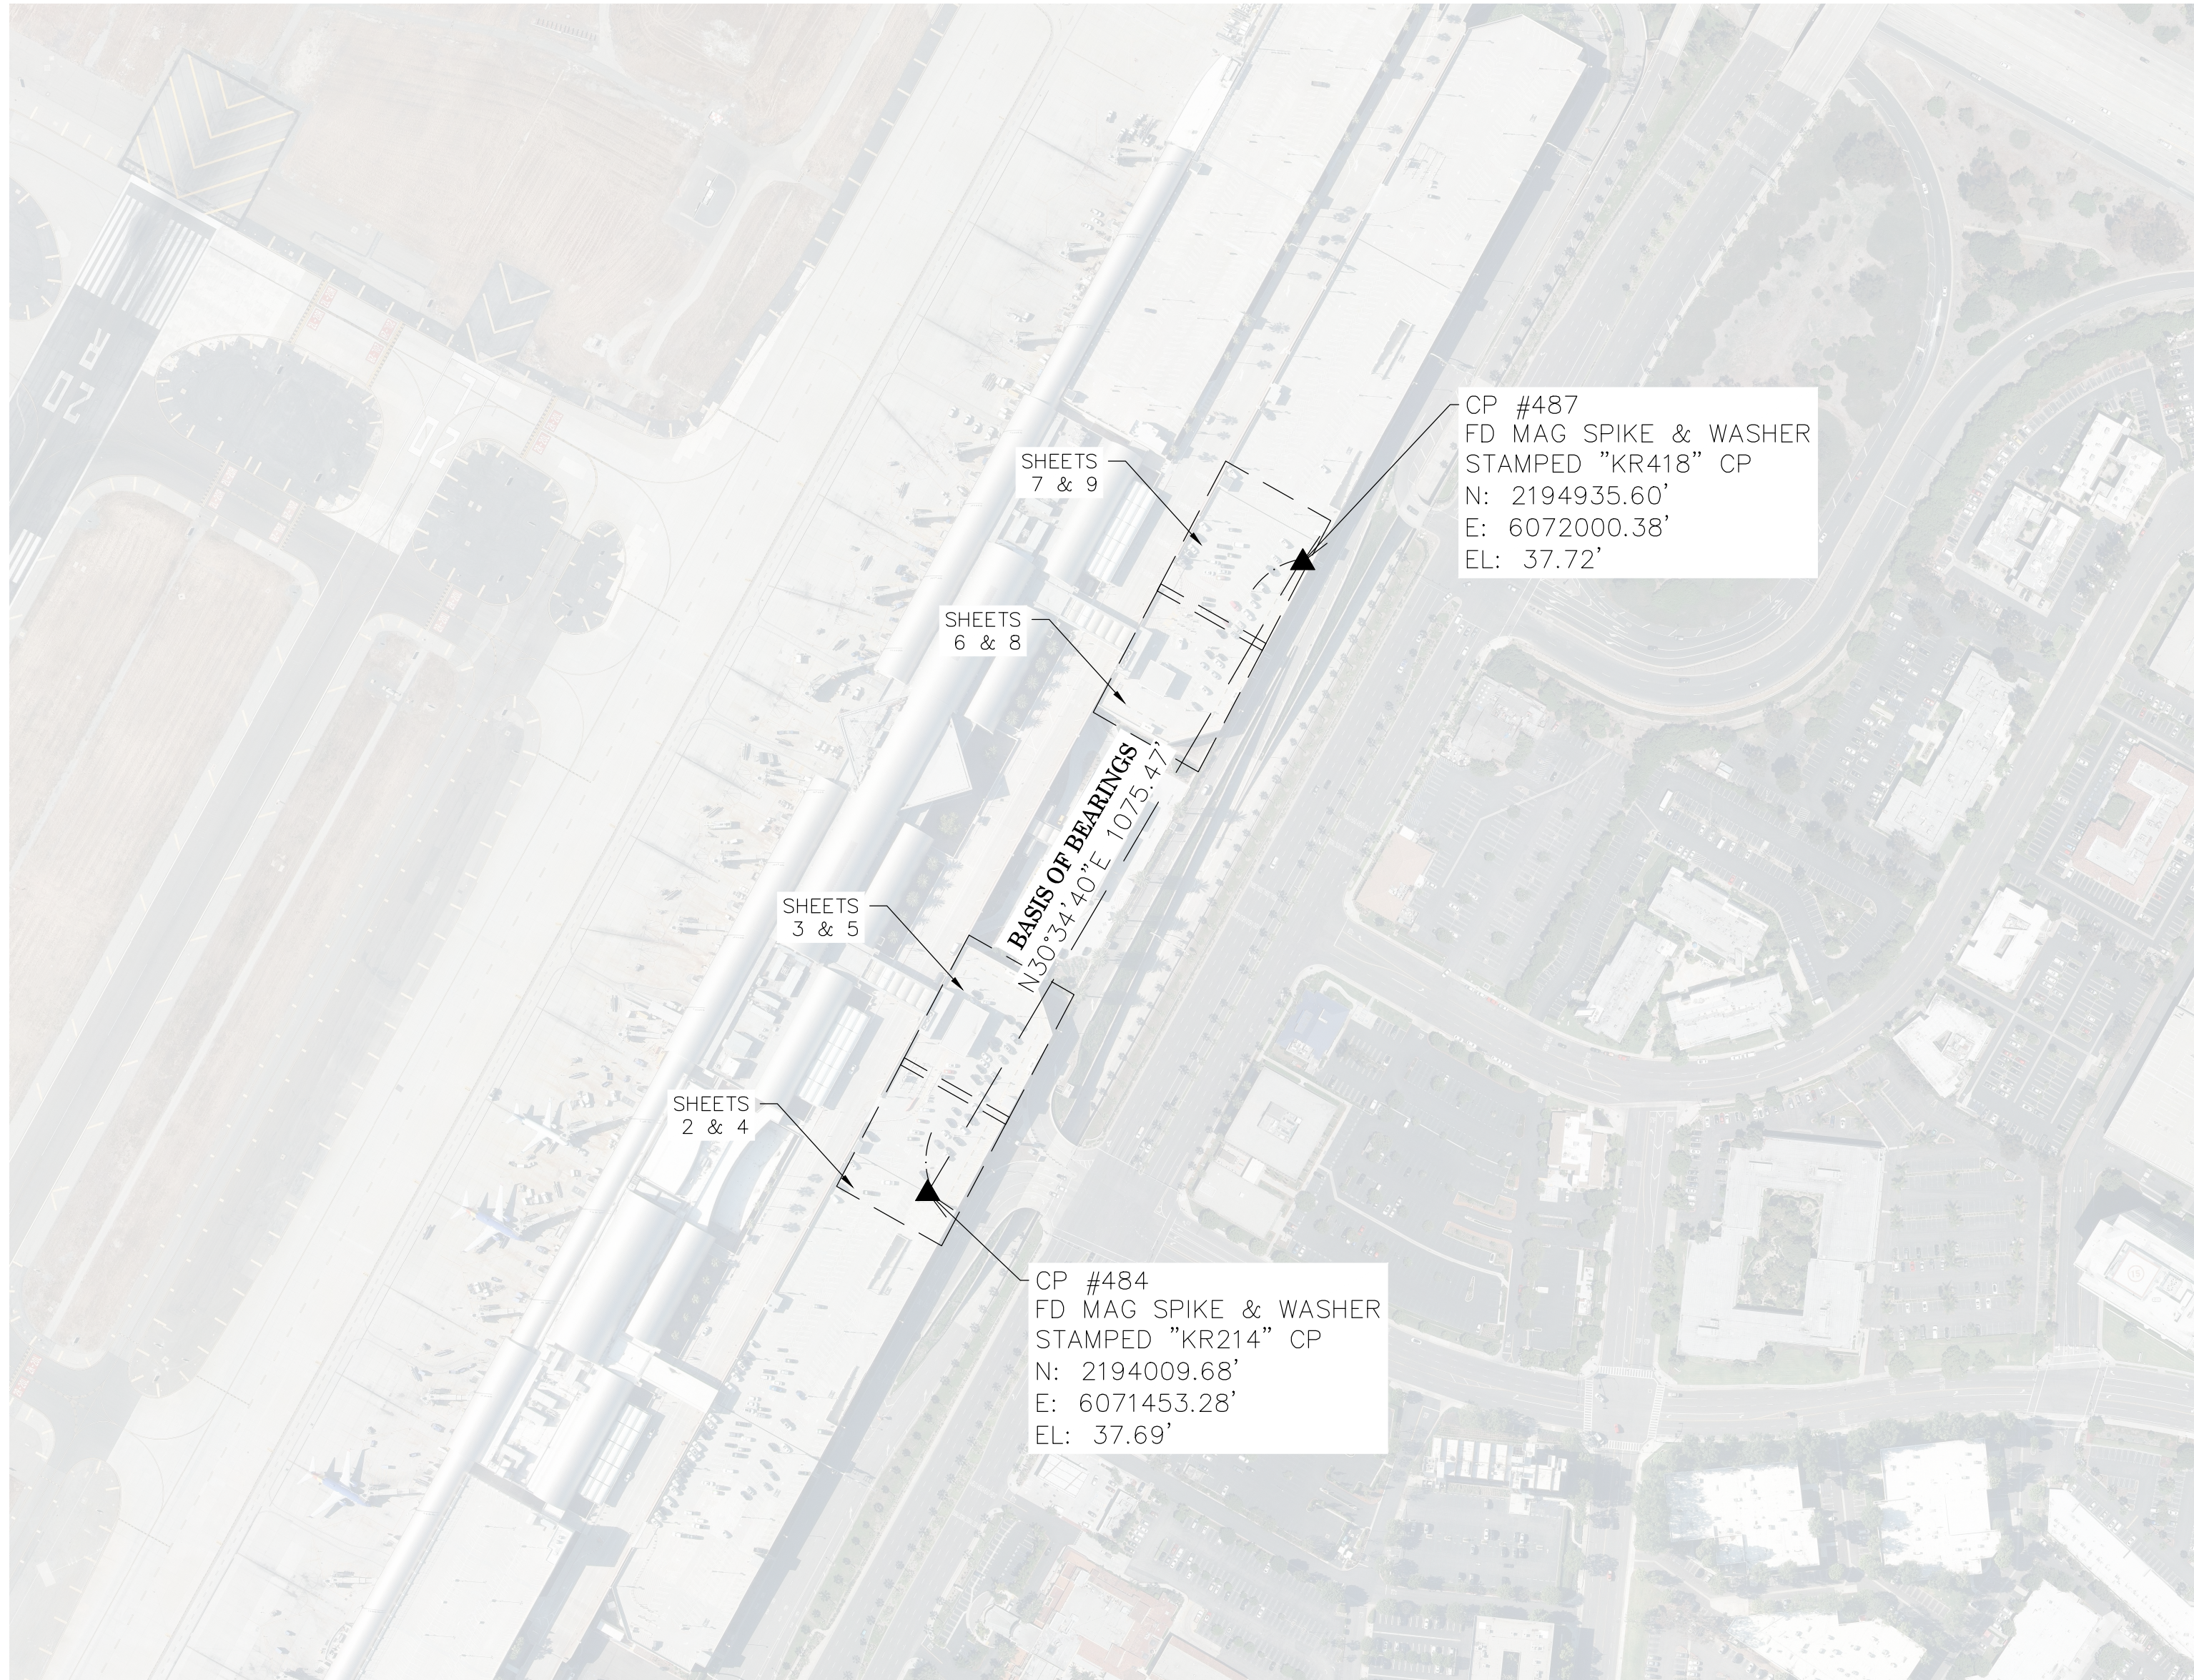

BASIS OF BEARINGS

THE BASIS OF BEARINGS FOR THIS SURVEY IS BASED ON THE CALIFORNIA COORDINATE SYSTEM (CCS83), ZONE VI, NAD 83, OCS (1991.35) EPOCH ADJUSTMENT, AS DETERMINED LOCALLY BY A LINE BETWEEN CONTROL POINTS KR484 AND KR48AS DERIVED FROM THE COORDINATES PROVIDED BY AND ON FILE WITH JWA SURVEY DATED 02-28-2022.

HORIZONTAL AND VERTICAL DATUM

COORDINATES SHOWN ARE BASED ON THE CALIFORNIA COORDINATE SYSTEM (CCS83), ZONE VI, NAD 83, OCS (1991.35) EPOCH ADJUSTMENT.

VERTICAL DATUM: ASSUMED AS SHOWN HEREON.

ALL DISTANCES ARE BASED ON THE U.S. SURVEY FOOT.

SHEET INDEX

SHEET	NO.	DESCRIPTION
SHEET 1	1	TITLE SHEET
SHEET 2-9	2-9	TOPOGRAPHIC MAP

PURPOSE OF SURVEY

THE PURPOSE OF THE SURVEY IS TO PROVIDE A RELATIVE CONTOUR MAP FOR DRAINAGE ANALYSIS FOR A PORTION OF PARKING STRUCTURES A2 AND B2 LEVEL 1.

U.S. Survey Foot


OC Public Works
OC Survey/Field Services
Boundary Analysis & Mapping

TOPOGRAPHIC MAPPING PROJECT



		COUNTY OF ORANGE OC PUBLIC WORKS OC SURVEY/FIELD SERVICES/BOUNDARY ANALYSIS & MAPPING						
		JOHN WAYNE AIRPORT STRUCTURES A2 AND B2 (LEVEL 1)						
		TITLE SHEET						
		PROJECT LIMITS: PARKING STRUCTURE A2 & B2, LEVEL 1						
		DATE OF SURVEY: 03/04/2022		BY: R. MACIAS, PLS	SHEET NO. 1 of 9			
		MAPPING		BY: H. AFTIM, PLS				
		OFFICE CHECK		BY: M. LAFONTAINE, PLS				
		FIELD CHECK		BY: E. MEDINA, PLS				
		MARK	DATE	ITEM	SCALE: N.T.S.		W.O. #EX28P446	FILE # 2122PW-JWA0001
		REVISIONS			FILE: JOHN WAYNE AIRPORT STRUCTURE A2_TOPO_2022.DWG			

PARKING STRUCTURE B2, LEVEL 1

SEE SHEET 3

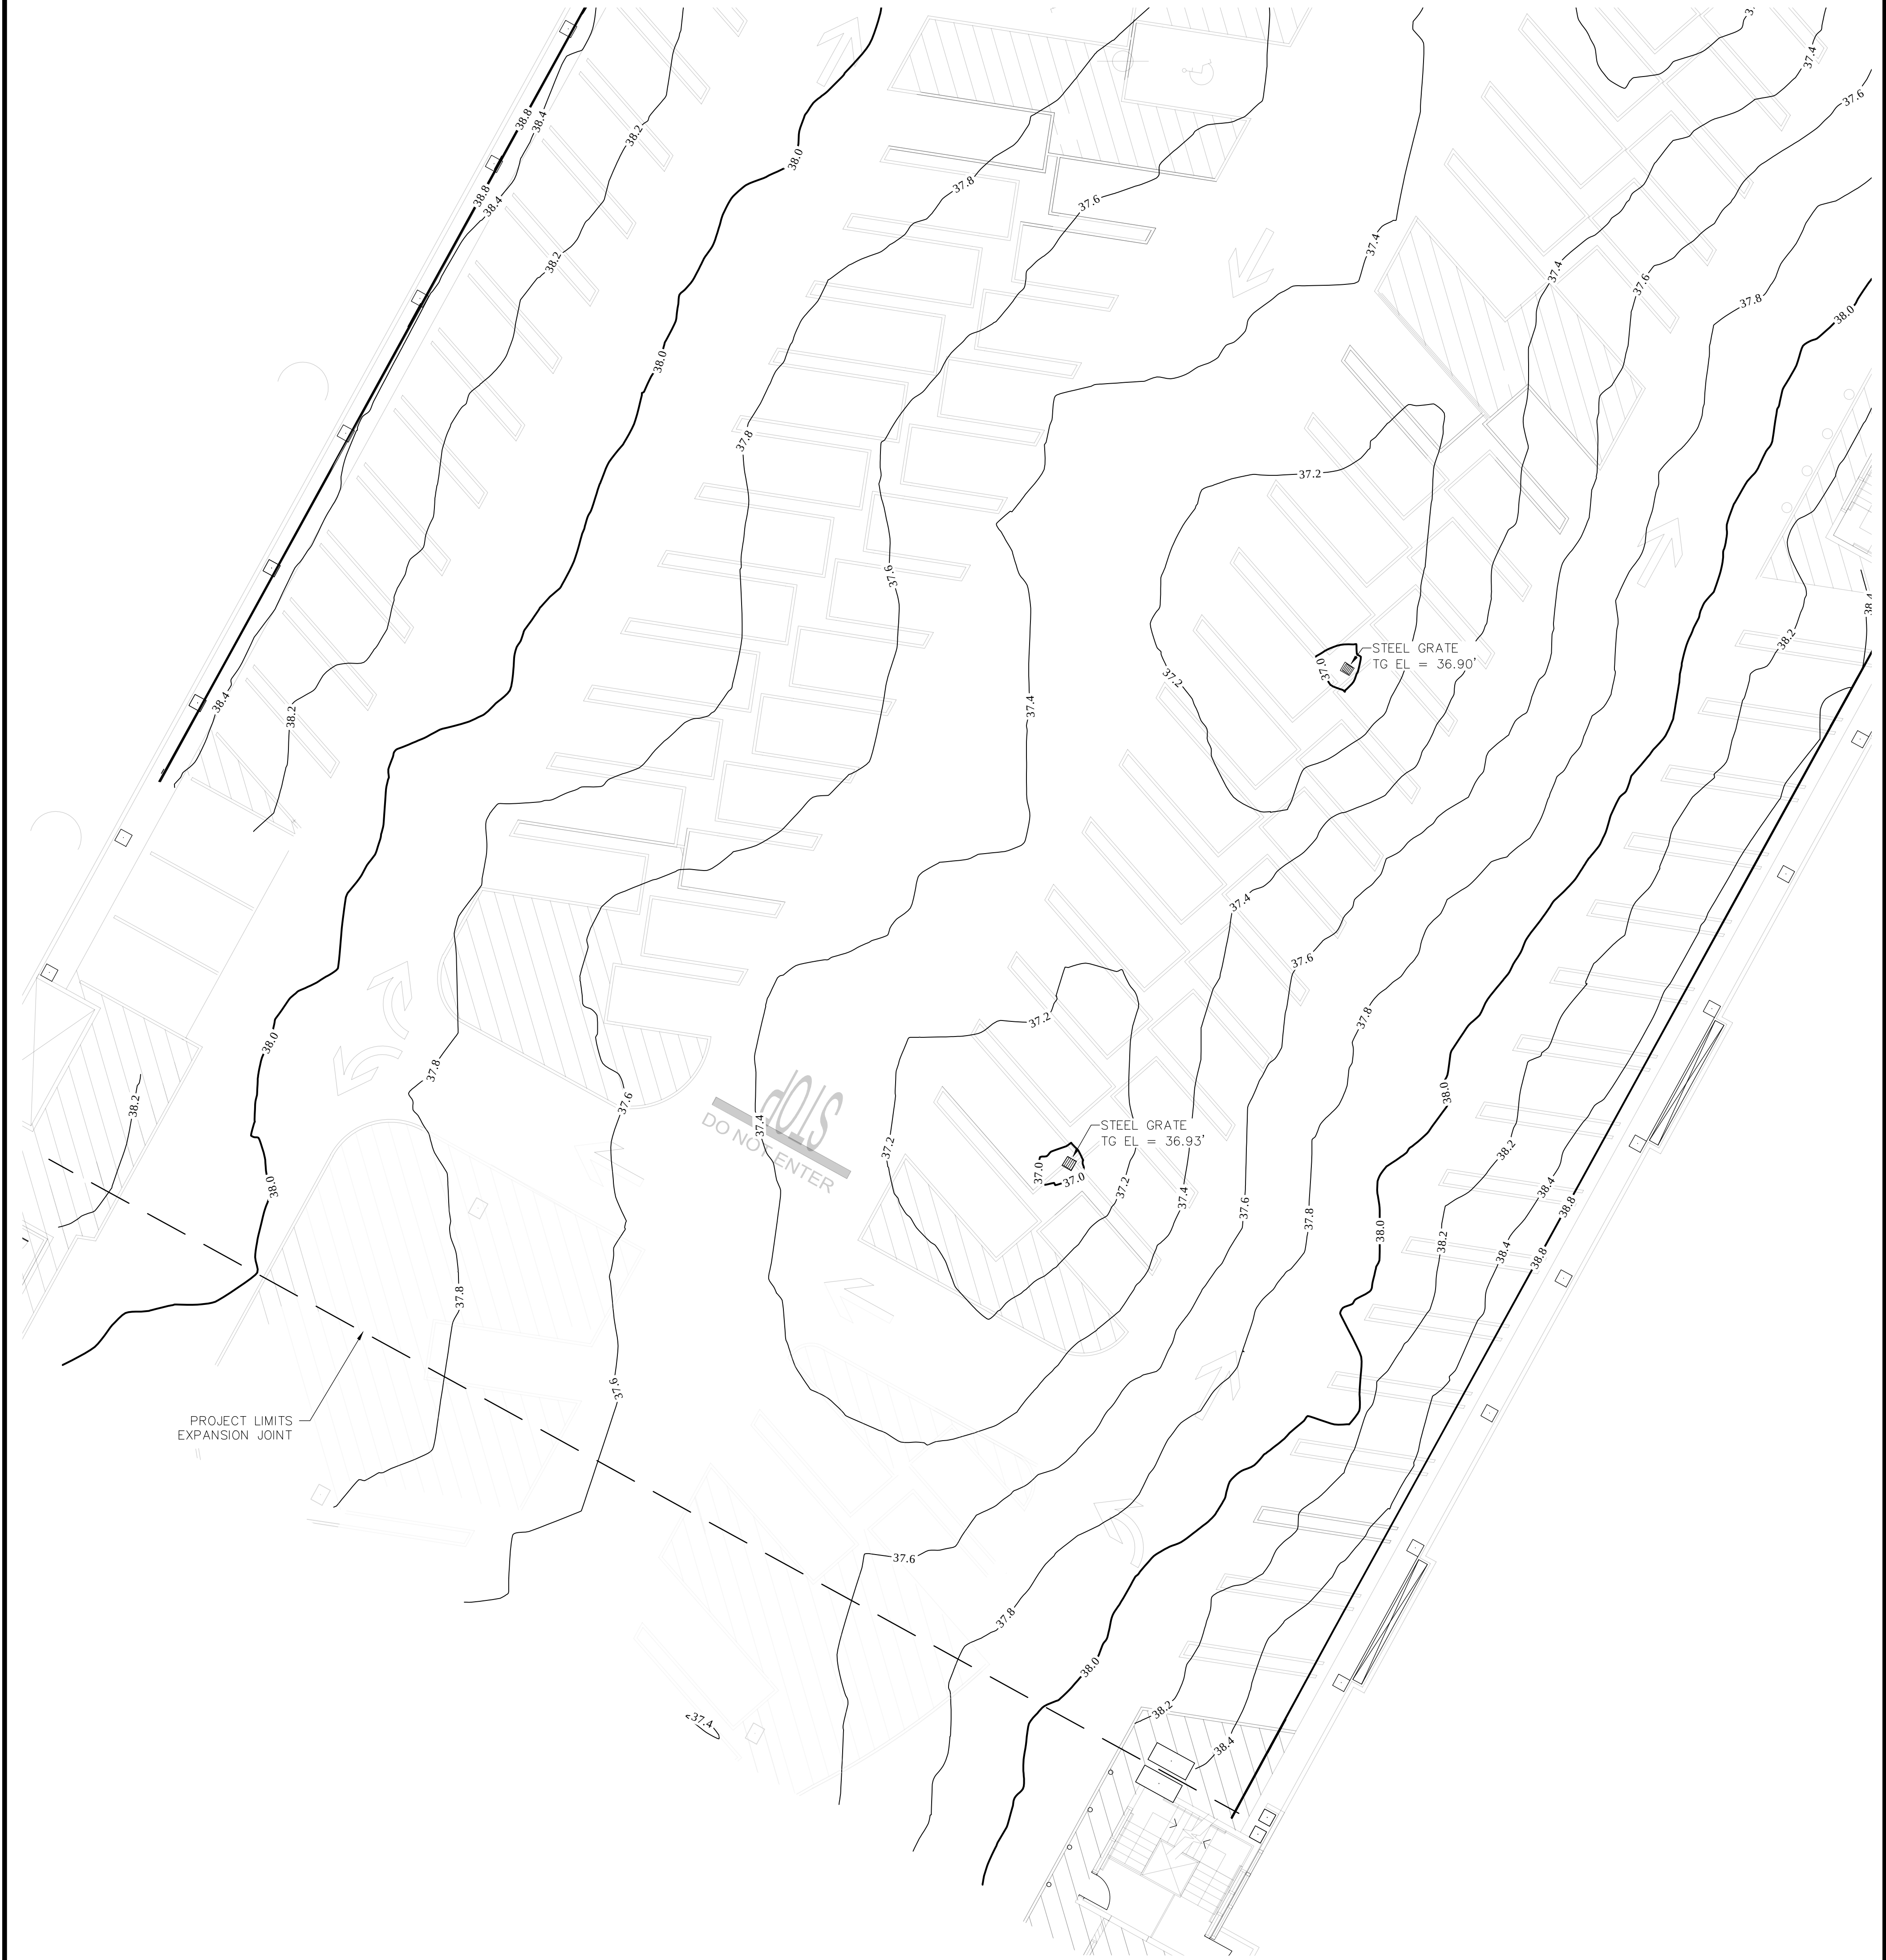

NOTES:
STRIPING AND FLOOR PLAN FEATURES DERIVED FROM SITE PLAN NO 41021-J117 DATED 01/13/2021.
THE TIN SURFACE WITHIN THIS DATA SET HAS BEEN CREATED FROM TERRESTRIAL LASER SCANNING METHODS AND IT SHOULD BE CONSIDERED RELATIVE FOR THE SPECIFIC PURPOSE OF THIS CONTOUR MAP.

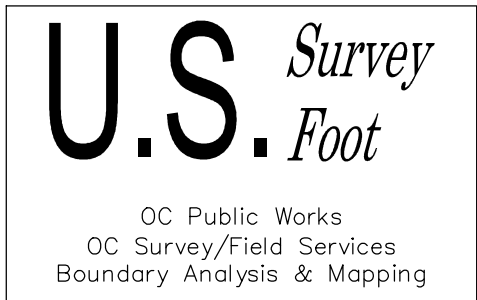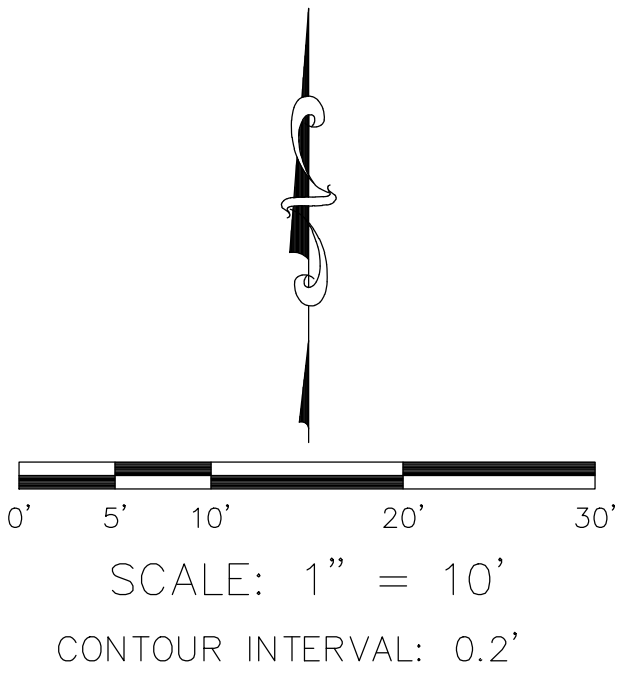

		COUNTY OF ORANGE OC PUBLIC WORKS OC SURVEY/FIELD SERVICES/BOUNDARY ANALYSIS & MAPPING			
JOHN WAYNE AIRPORT STRUCTURES A2 AND B2 (LEVEL 1)					
TOPOGRAPHIC MAP					
PROJECT LIMITS: PARKING STRUCTURE A2 & B2, LEVEL 1					
		DATE OF SURVEY: 03/04/2022		BY: R. MACIAS, PLS	
		MAPPING		BY: H. AFTIM, PLS	
		OFFICE CHECK		BY: M. LAFONTAINE, PLS	
		FIELD CHECK		BY: E. MEDINA, PLS	
MARK	DATE	ITEM		SHEET NO.	
				2	
				of	
REVISIONS				9	
		SCALE: 1" = 10'	W.O. #EX28P446	FILE #2122PW-JWA0001	
		FILE: JOHN WAYNE AIRPORT STRUCTURE A2_TOPO_2022.DWG			

PARKING STRUCTURE B2, LEVEL1



SEE SHEET 2


U.S. *Survey* *Foot*

OC Public Works
OC Survey/Field Services
Boundary Analysis & Mapping

NOTES:

STRIPING AND FLOOR PLAN FEATURES DERIVED FROM SITE PLAN NO 41021-J117 DATED 01/13/2021.

THE TIN SURFACE WITHIN THIS DATA SET HAS BEEN CREATED FROM TERRESTRIAL LASER SCANNING METHODS AND IT SHOULD BE CONSIDERED RELATIVE FOR THE SPECIFIC PURPOSE OF THIS CONTOUR MAP.


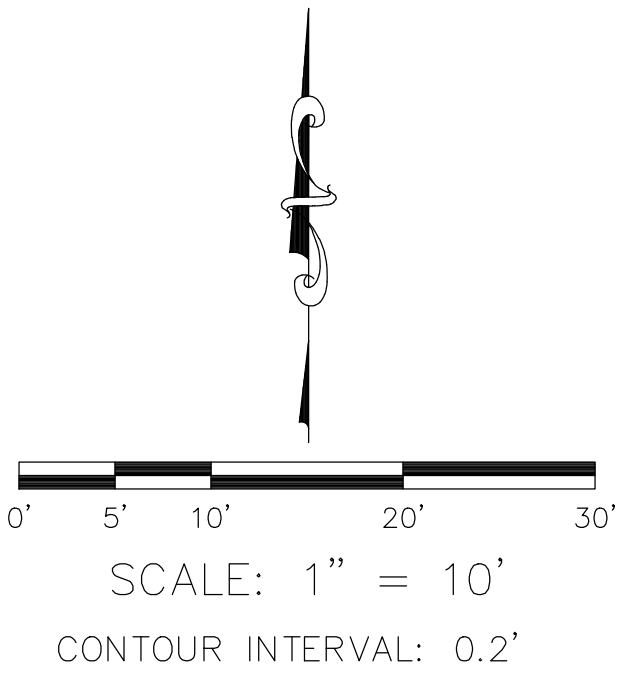


		COUNTY OF ORANGE OC PUBLIC WORKS OC SURVEY/FIELD SERVICES/BOUNDARY ANALYSIS & MAPPING			
JOHN WAYNE AIRPORT STRUCTURES A2 AND B2 (LEVEL 1)					
TOPOGRAPHIC MAP					
PROJECT LIMITS: PARKING STRUCTURE A2 & B2, LEVEL 1					
		DATE OF SURVEY: 03/04/2022		BY: R. MACIAS, PLS	
		MAPPING		BY: H. AFTIM, PLS	
		OFFICE CHECK		BY: M. LAFONTAINE, PLS	
		FIELD CHECK		BY: E. MEDINA, PLS	
MARK		DATE		ITEM	
REVISIONS					
		SCALE: 1" = 10'		W.O. #EX28P446	
		FILE: JOHN WAYNE AIRPORT STRUCTURE A2_TOPO_2022.DWG		FILE #2122PW-JWA0001	
				SHEET NO. 3 of 9	

PARKING STRUCTURE B2, LEVEL 1


ELEVATIONS TABLE			
NUMBER	MINIMUM ELEVATION	MAXIMUM ELEVATION	COLOR
1	36.88	37.22	Red
2	37.22	37.36	Dark Red
3	37.36	37.47	Brown
4	37.47	37.59	Light Brown
5	37.59	37.72	Yellow-Green
6	37.72	37.83	Light Green
7	37.83	37.95	Medium Green
8	37.95	38.07	Dark Green
9	38.07	38.21	Forest Green
10	38.21	39.05	Dark Forest Green

SEE SHEET 5

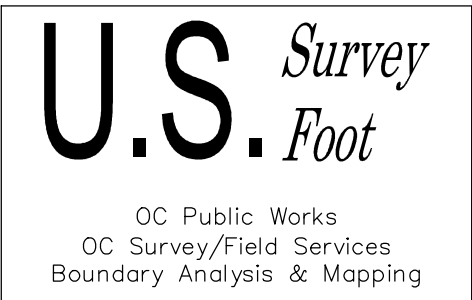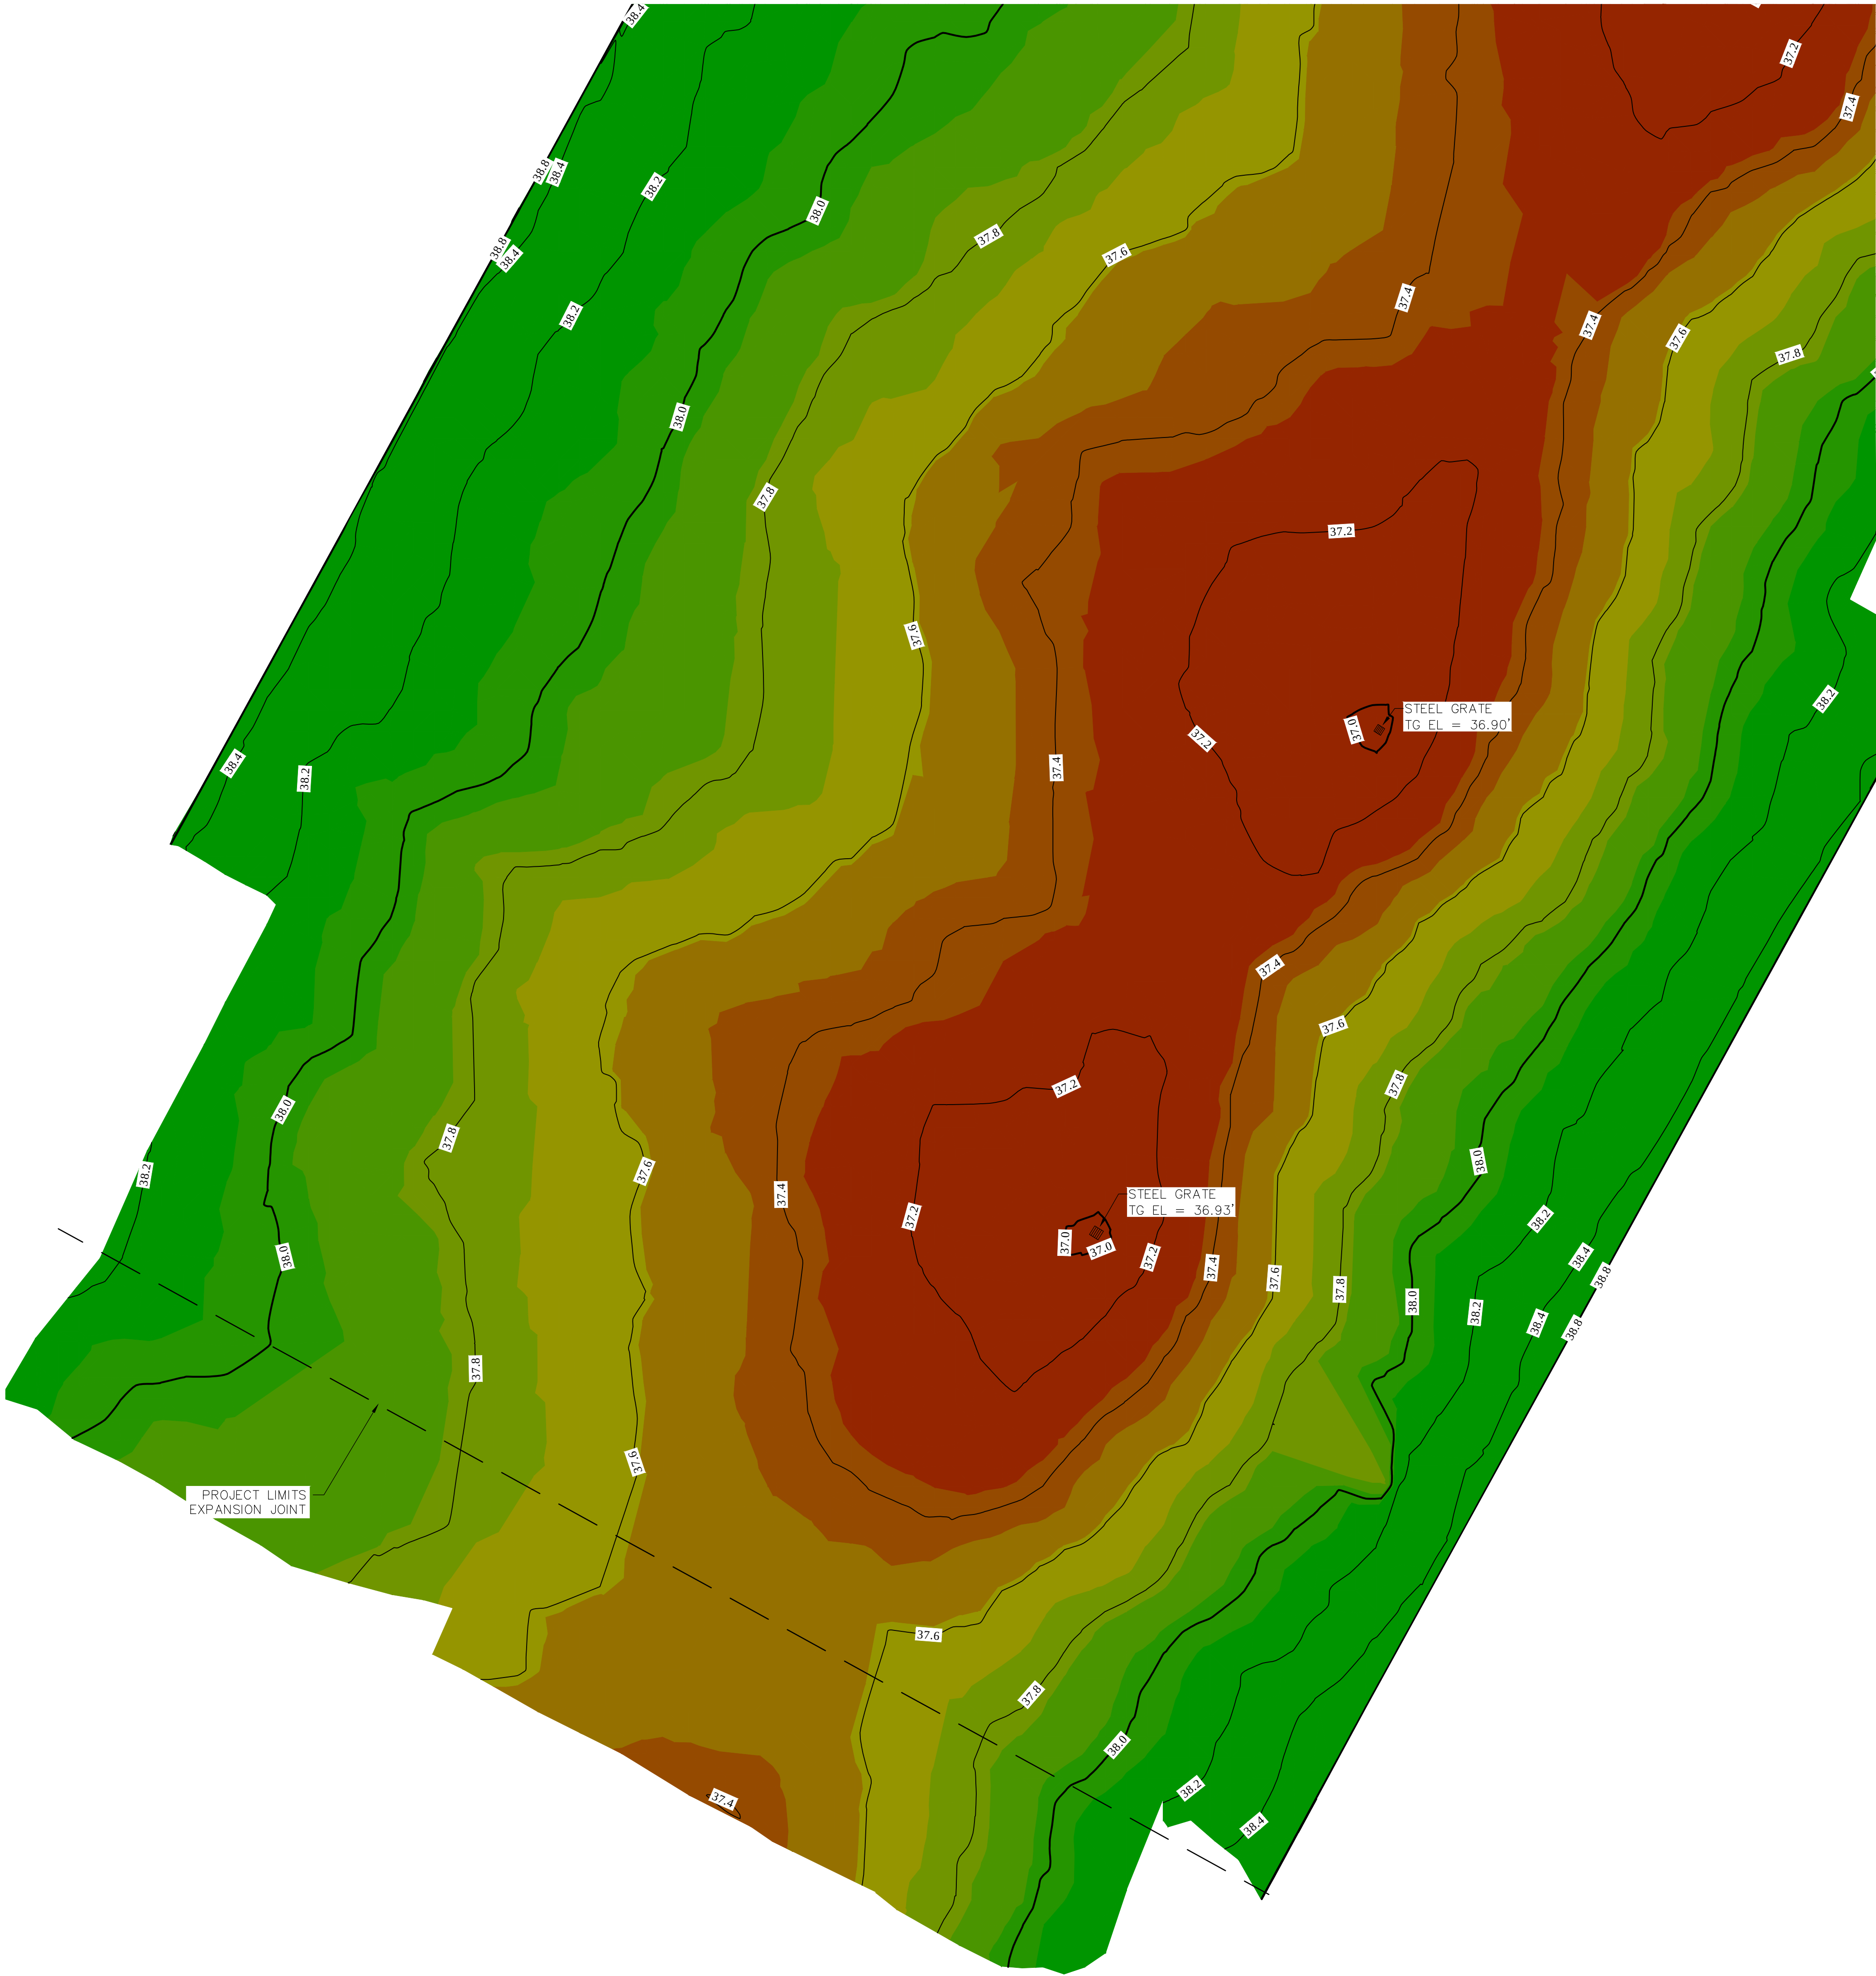

NOTES:


STRIPING AND FLOOR PLAN FEATURES DERIVED FROM SITE PLAN NO 41021-J117 DATED 01/13/2021.
THE TIN SURFACE WITHIN THIS DATA SET HAS BEEN CREATED FROM TERRESTRIAL LASER SCANNING METHODS AND IT SHOULD BE CONSIDERED RELATIVE FOR THE SPECIFIC PURPOSE OF THIS CONTOUR MAP.

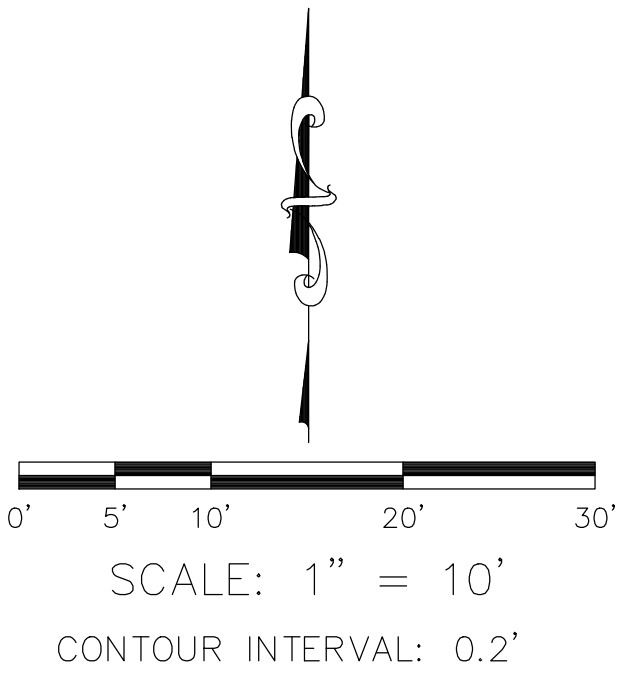

COUNTY OF ORANGE OC PUBLIC WORKS OC SURVEY/FIELD SERVICES/BOUNDARY ANALYSIS & MAPPING			
JOHN WAYNE AIRPORT STRUCTURES A2 AND B2 (LEVEL 1)			
TOPOGRAPHIC MAP			
PROJECT LIMITS: PARKING STRUCTURE A2 & B2, LEVEL 1		SHEET NO.	
DATE OF SURVEY: 03/04/2022		BY: R. MACIAS, PLS	
MAPPING		BY: H. AFTIM, PLS	
OFFICE CHECK		BY: M. LAFONTAINE, PLS	
FIELD CHECK		BY: E. MEDINA, PLS	
SCALE: 1" = 10'		W.O. #EX28P446	
FILE: JOHN WAYNE AIRPORT STRUCTURE A2_TOPO_2022.DWG		FILE #2122PW-JWA0001	
REVISIONS		4 of 9	

PARKING STRUCTURE B2, LEVEL1

ELEVATIONS TABLE			
NUMBER	MINIMUM ELEVATION	MAXIMUM ELEVATION	COLOR
1	36.88	37.22	■
2	37.22	37.36	■
3	37.36	37.47	■
4	37.47	37.59	■
5	37.59	37.72	■
6	37.72	37.83	■
7	37.83	37.95	■
8	37.95	38.07	■
9	38.07	38.21	■
10	38.21	39.05	■

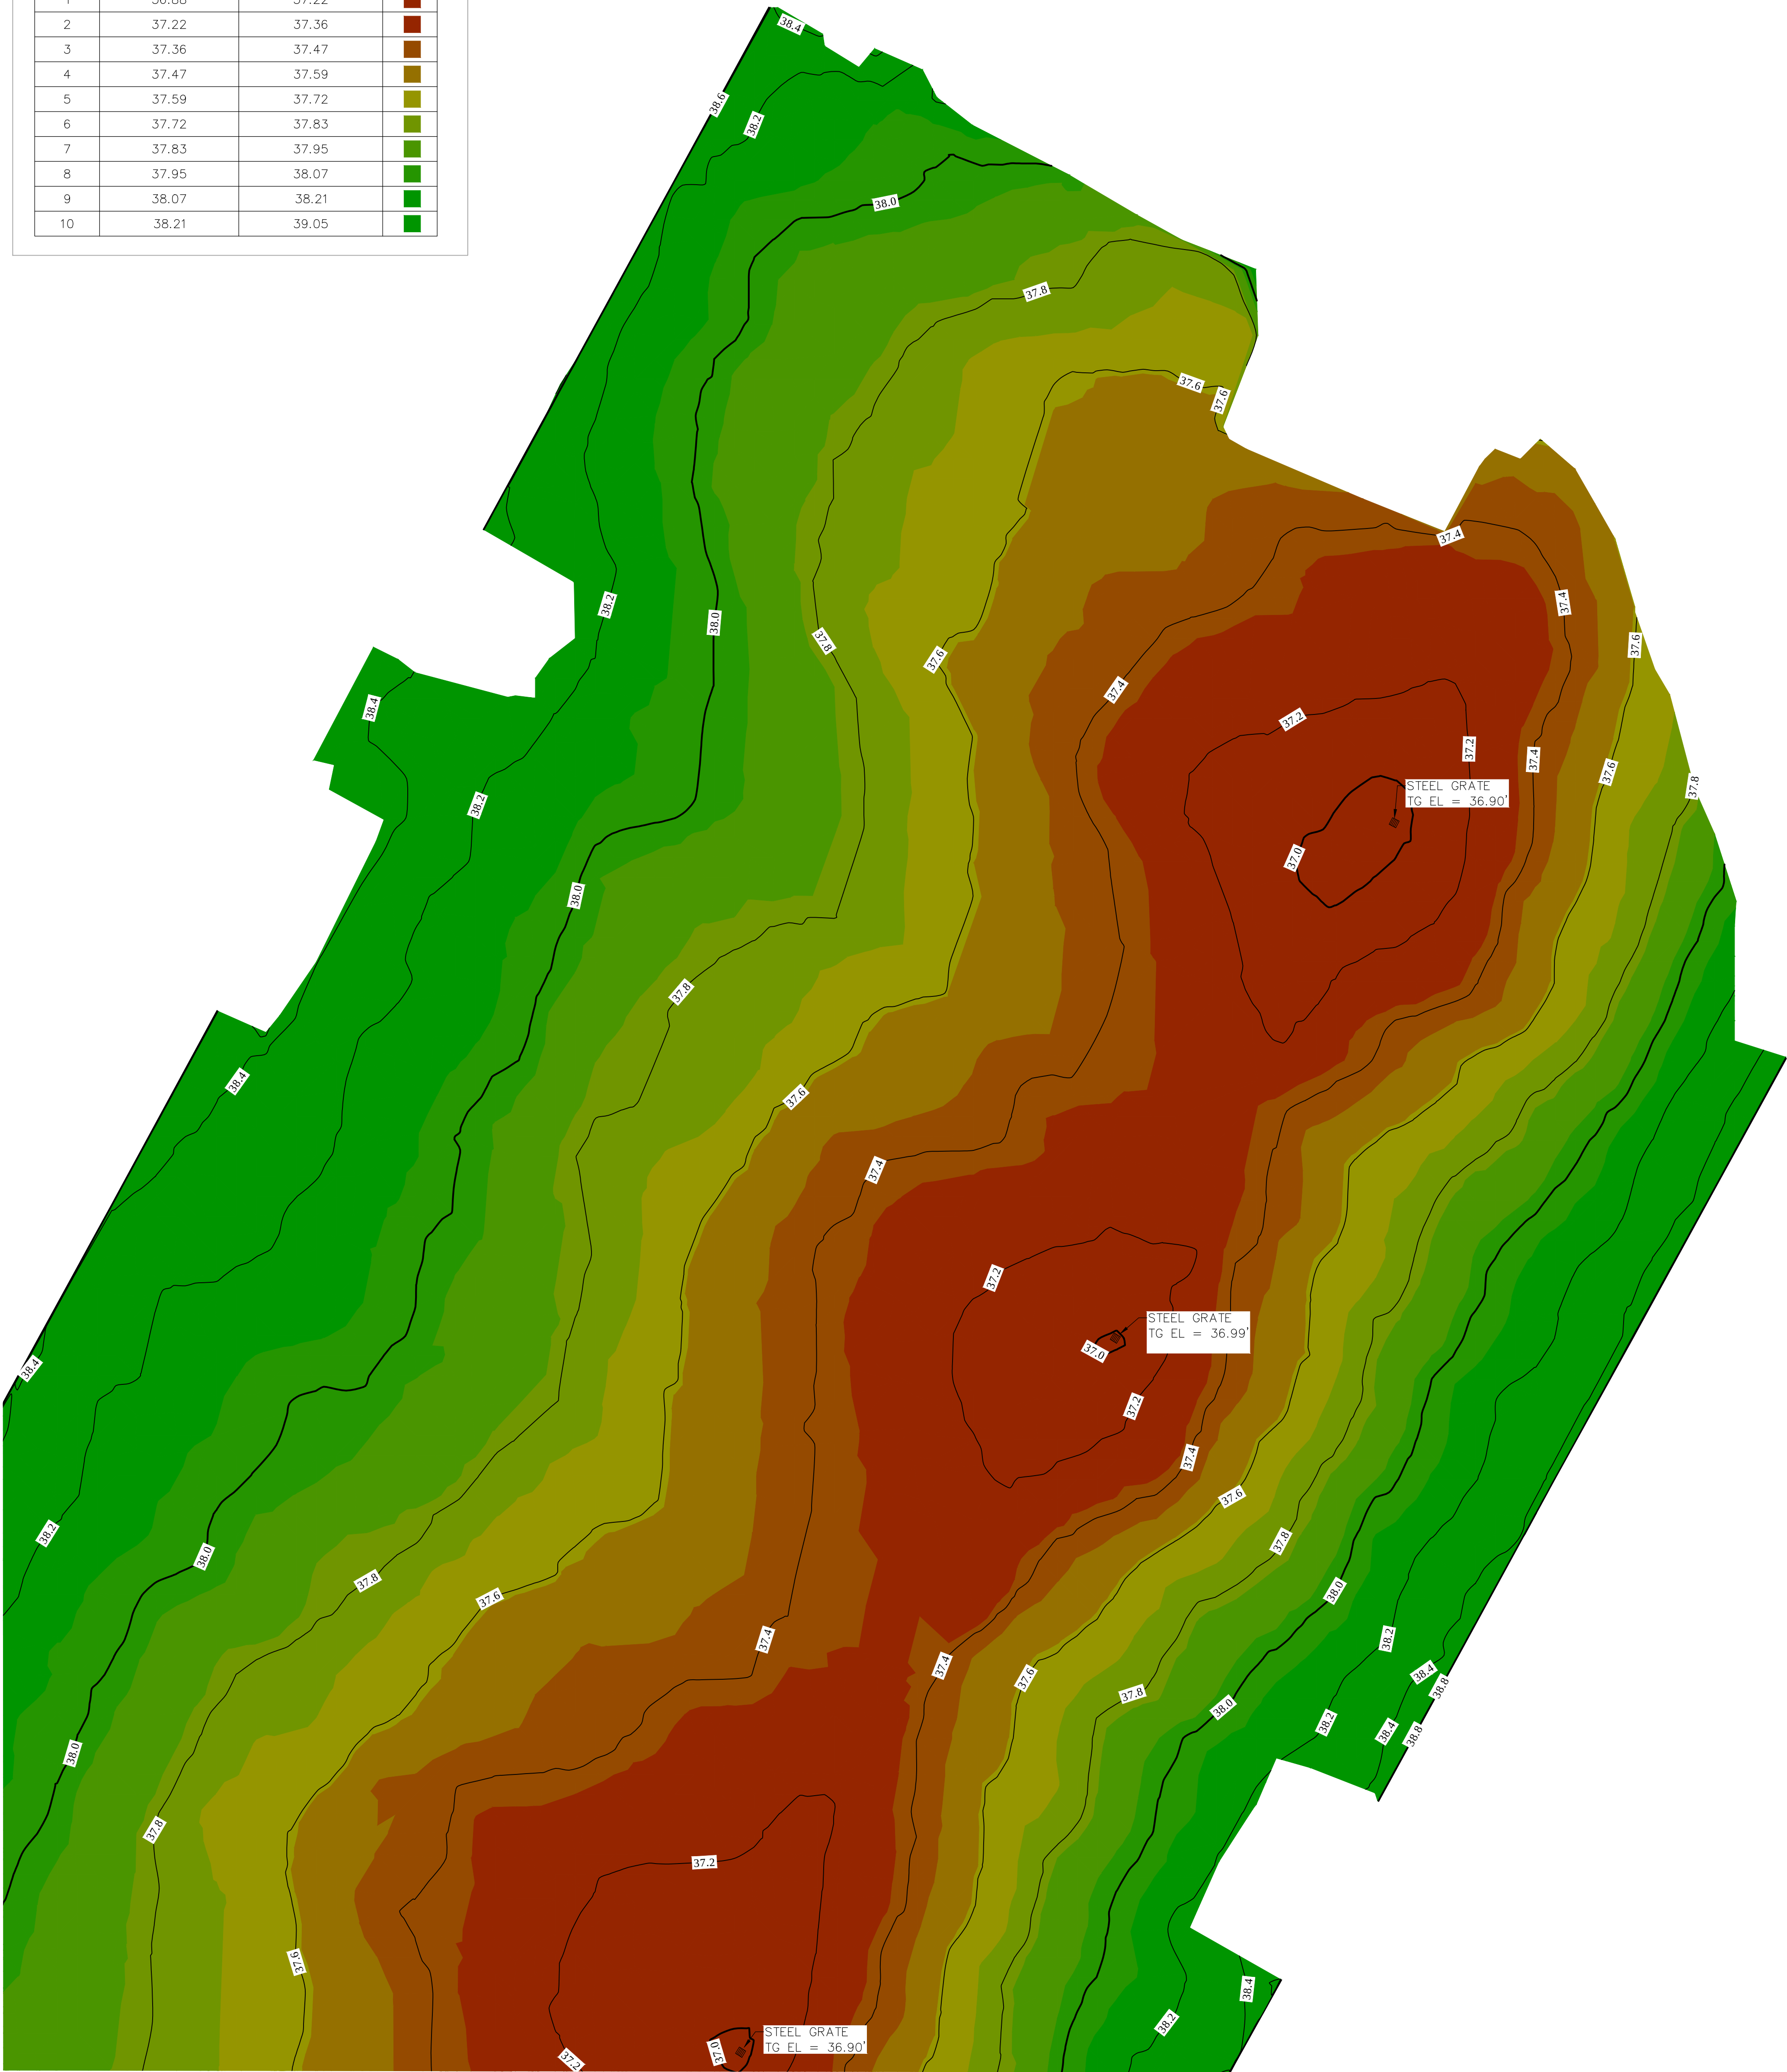

SEE SHEET 4


U.S. *Survey* *Foot*

OC Public Works
OC Survey/Field Services
Boundary Analysis & Mapping

NOTES:

STRIPING AND FLOOR PLAN FEATURES DERIVED FROM SITE PLAN NO 41021-J117 DATED 01/13/2021.


THE TIN SURFACE WITHIN THIS DATA SET HAS BEEN CREATED FROM TERRESTRIAL LASER SCANNING METHODS AND IT SHOULD BE CONSIDERED RELATIVE FOR THE SPECIFIC PURPOSE OF THIS CONTOUR MAP.

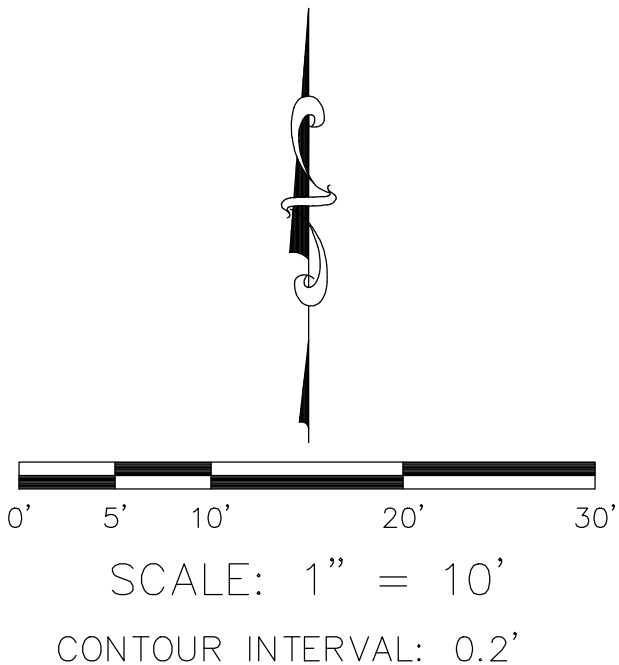

		COUNTY OF ORANGE OC PUBLIC WORKS OC SURVEY/FIELD SERVICES/BOUNDARY ANALYSIS & MAPPING	
JOHN WAYNE AIRPORT STRUCTURES A2 AND B2 (LEVEL 1)			
TOPOGRAPHIC MAP			
PROJECT LIMITS: PARKING STRUCTURE A2 & B2, LEVEL 1			
DATE OF SURVEY: 03/04/2022		BY: R. MACIAS, PLS	SHEET NO. 5 of 9
MAPPING		BY: H. AFTIM, PLS	
OFFICE CHECK		BY: M. LAFONTAINE, PLS	
FIELD CHECK		BY: E. MEDINA, PLS	
MARK	DATE	ITEM	
REVISIONS			
SCALE: 1" = 10'		W.O. #EX28P446	FILE #2122PW-JWA0001
FILE: JOHN WAYNE AIRPORT STRUCTURE A2_TOPO_2022.DWG			


PARKING STRUCTURE A2, LEVEL 1

SEE SHEET 7

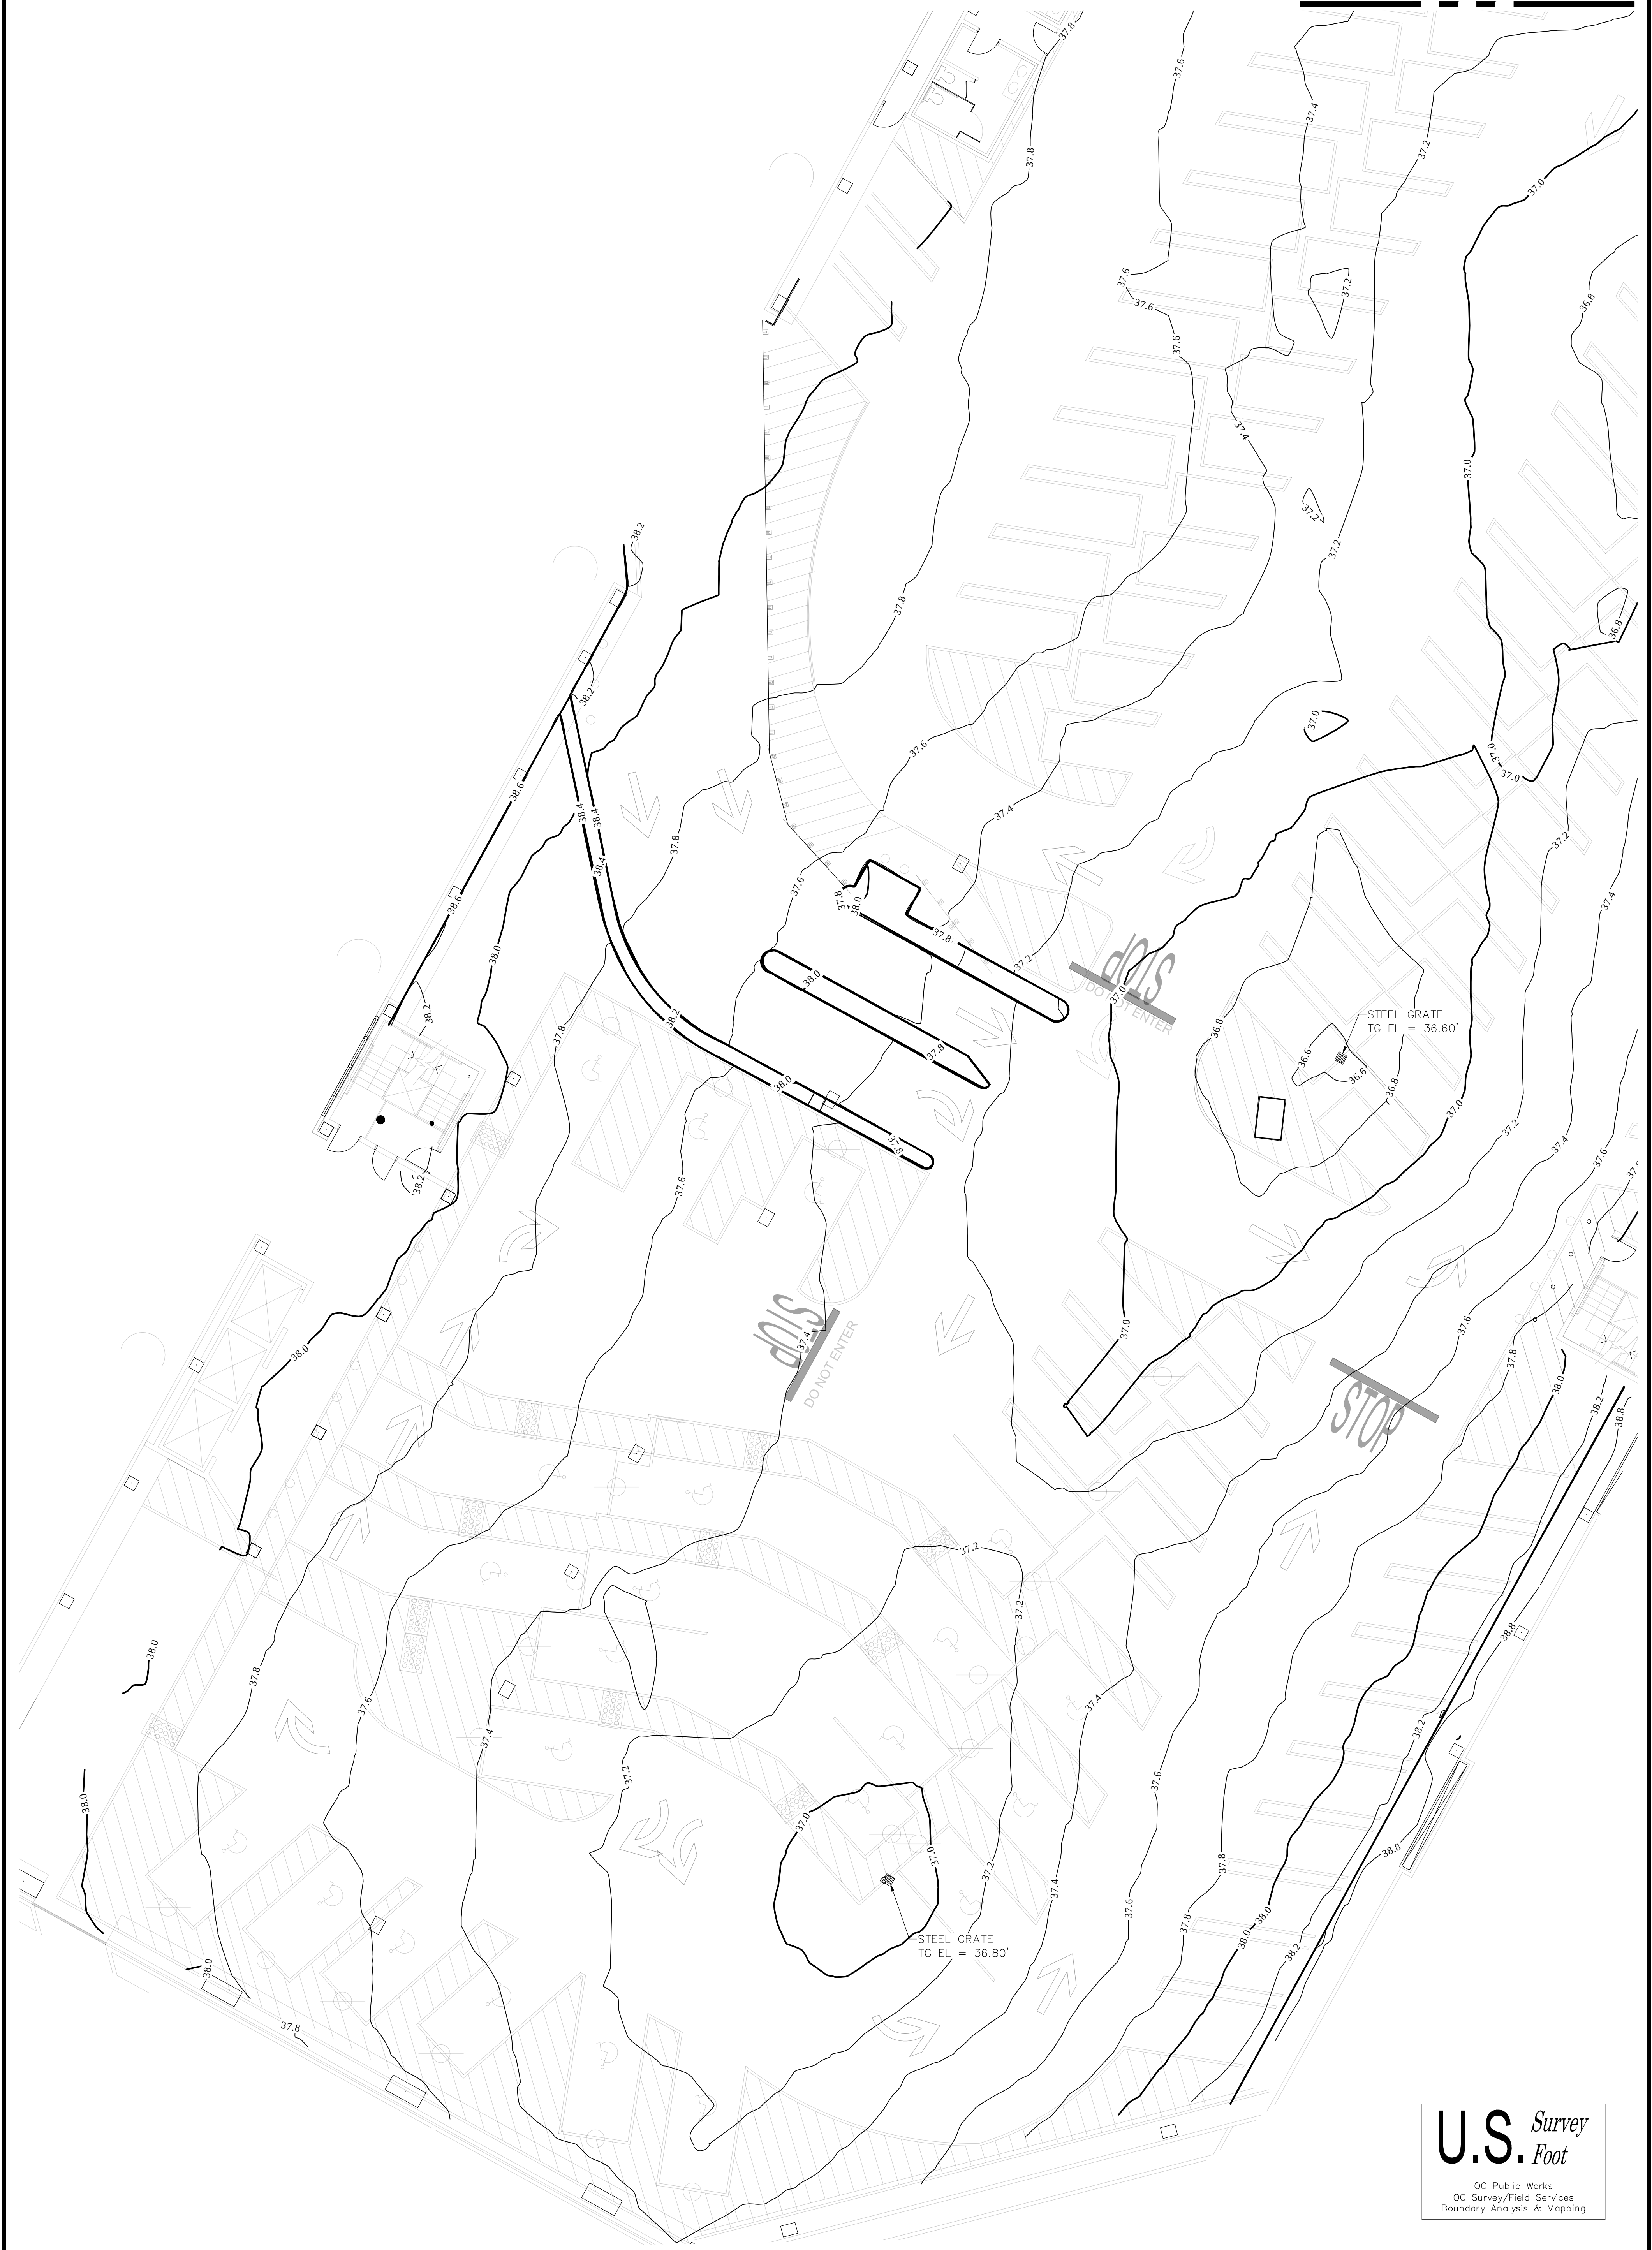


U.S. Survey
Foot
OC Public Works
OC Survey/Field Services
Boundary Analysis & Mapping

NOTES:
STRIPING AND FLOOR PLAN FEATURES DERIVED FROM SITE PLAN NO 41021-J117 DATED 01/13/2021.
THE TIN SURFACE WITHIN THIS DATA SET HAS BEEN CREATED FROM TERRESTRIAL LASER SCANNING METHODS AND IT SHOULD BE CONSIDERED RELATIVE FOR THE SPECIFIC PURPOSE OF THIS CONTOUR MAP.

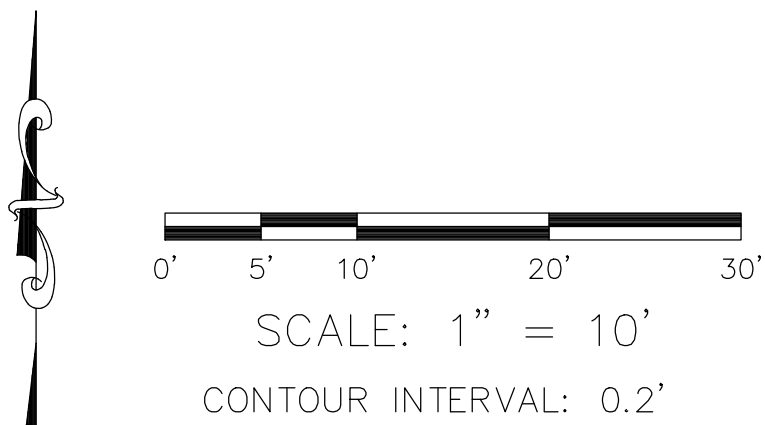

COUNTY OF ORANGE OC PUBLIC WORKS OC SURVEY/FIELD SERVICES/BOUNDARY ANALYSIS & MAPPING		
JOHN WAYNE AIRPORT STRUCTURES A2 AND B2 (LEVEL 1)		
TOPOGRAPHIC MAP		
PROJECT LIMITS: PARKING STRUCTURE A2 & B2, LEVEL 1		SHEET NO. 6 of 9
DATE OF SURVEY: 03/04/2022	BY: R. MACIAS, PLS	
MAPPING	BY: H. AFTIM, PLS	
OFFICE CHECK	BY: M. LAFONTAINE, PLS	
FIELD CHECK	BY: E. MEDINA, PLS	
SCALE: 1" = 10'	W.O. #EX28P446	FILE #2122PW-JWA0001
FILE: JOHN WAYNE AIRPORT STRUCTURE A2_TOPO_2022.DWG		

PARKING STRUCTURE A2, LEVEL 1

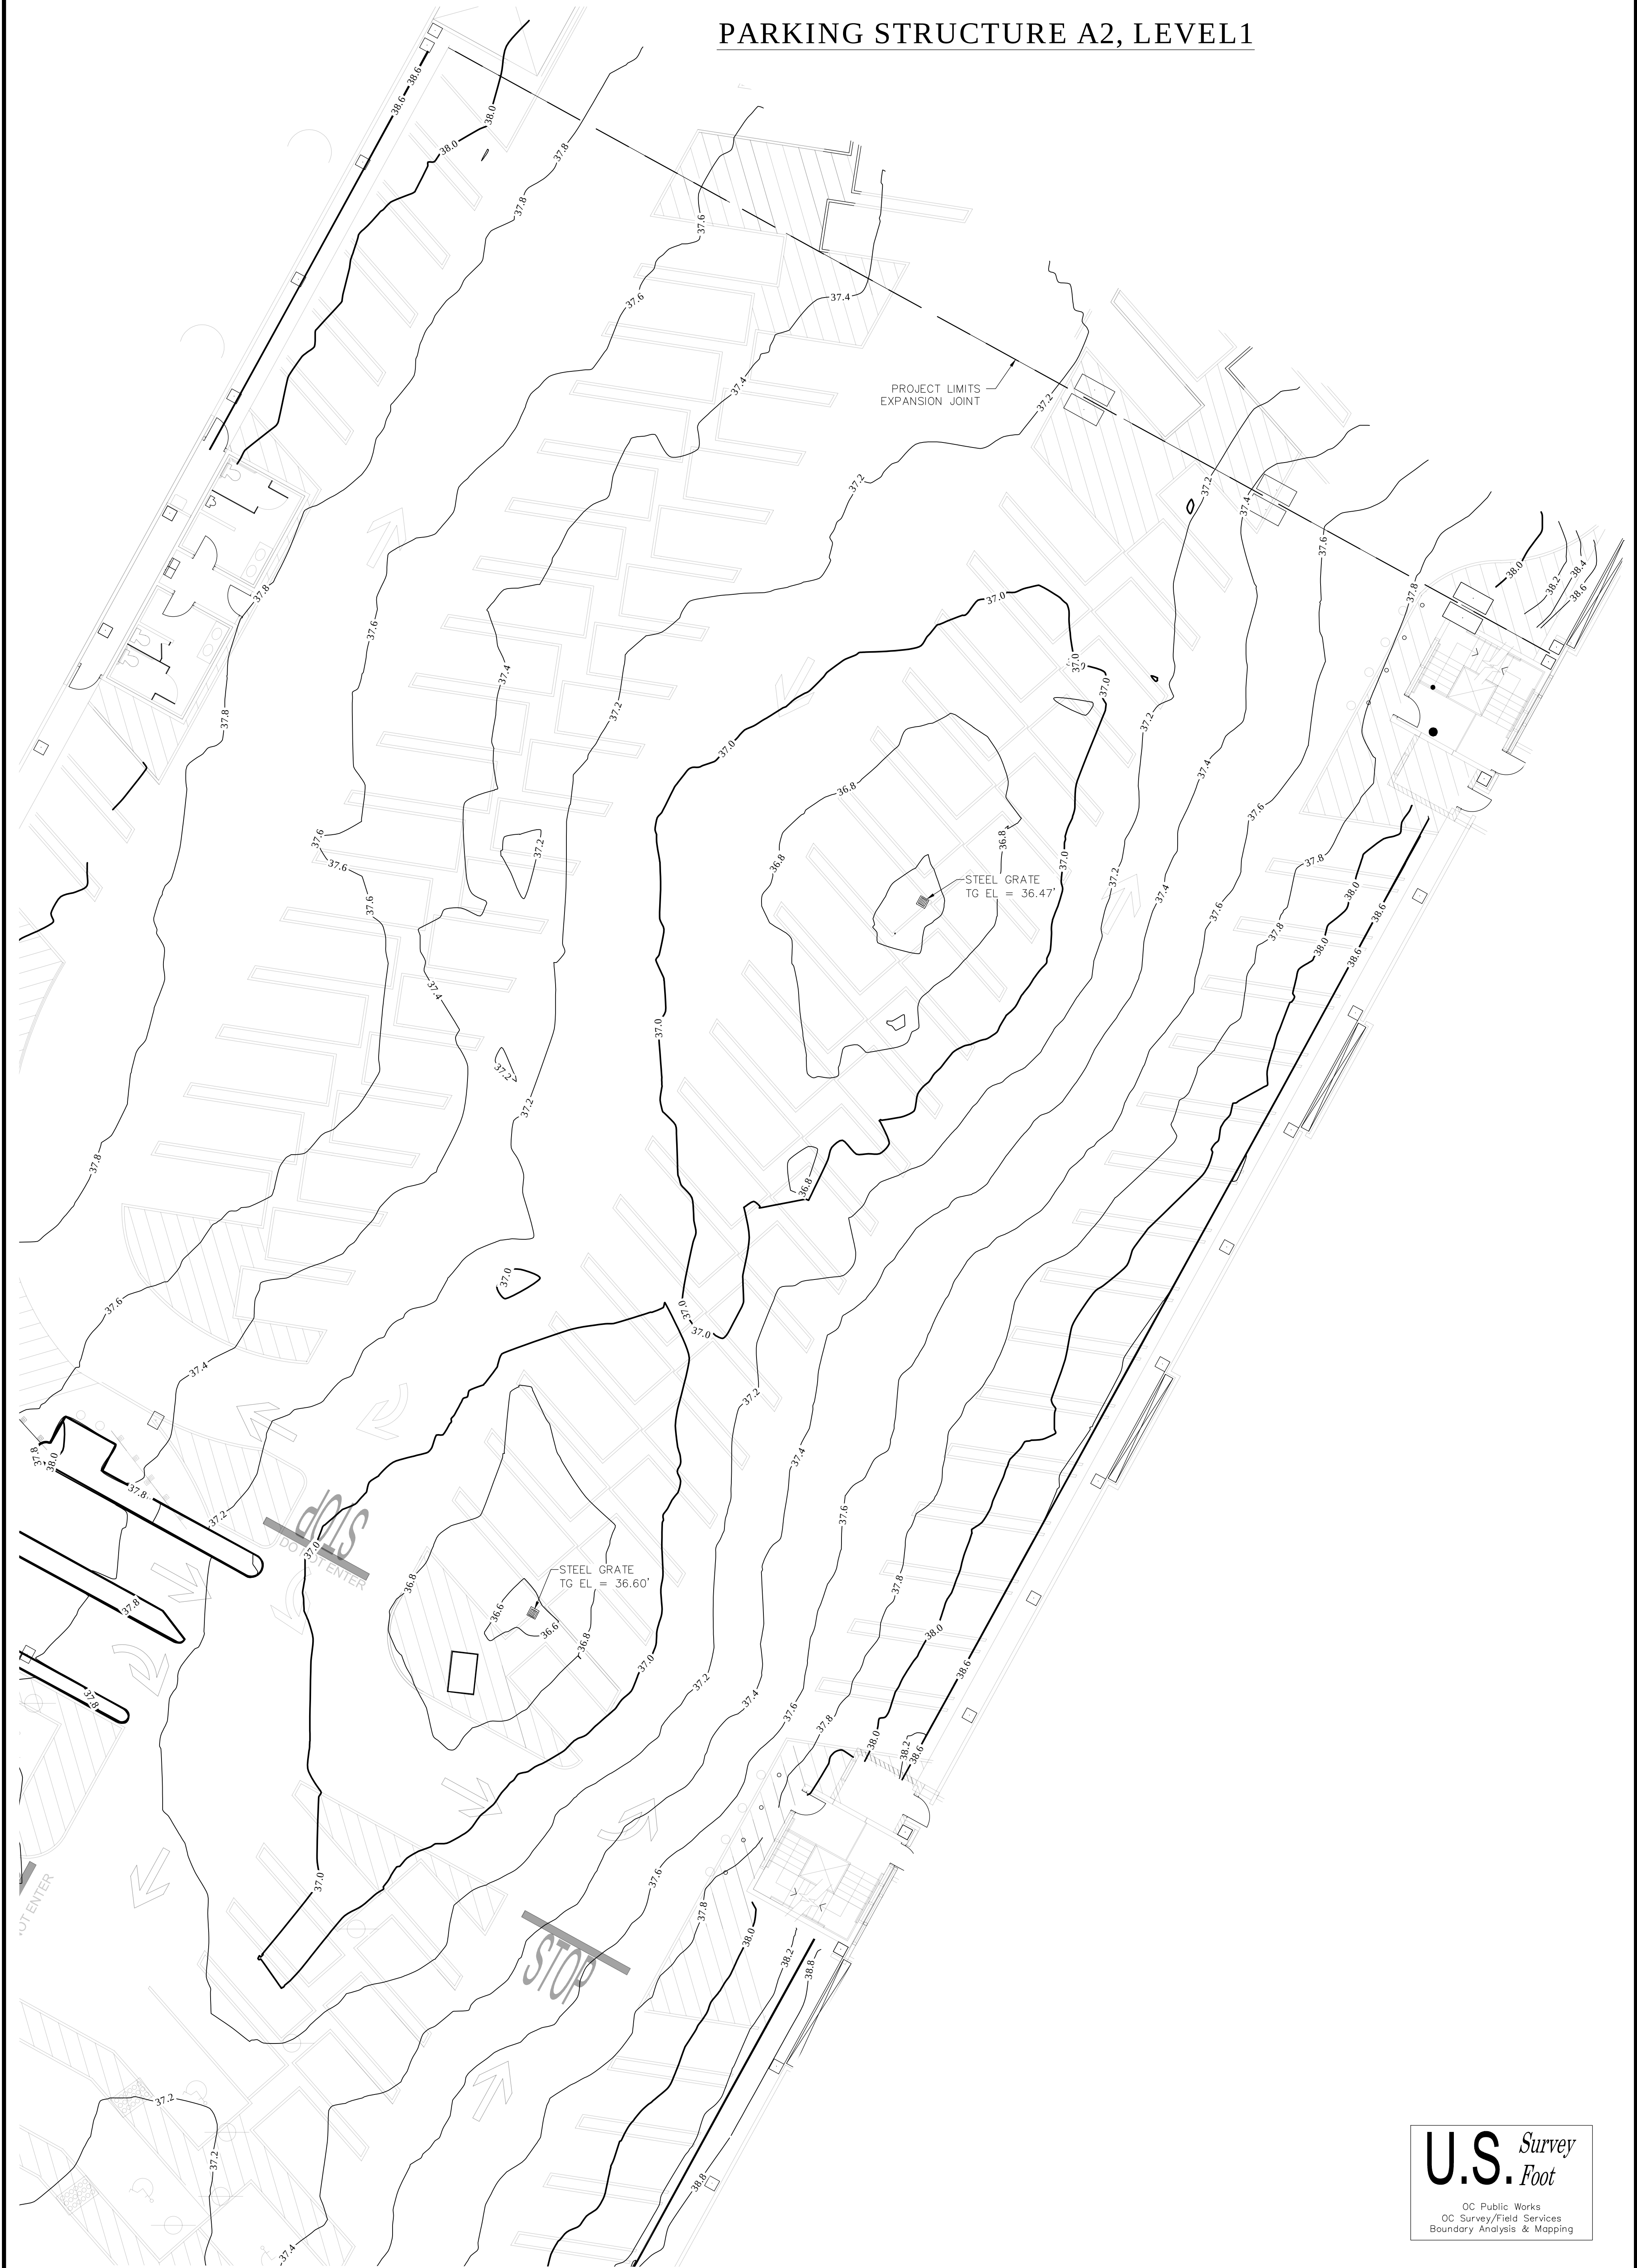


U.S. *Survey* *Foot*

OC Public Works
OC Survey/Field Services
Boundary Analysis & Mapping

SEE SHEET 6

NOTES:
STRIPING AND FLOOR PLAN FEATURES DERIVED FROM SITE PLAN NO 41021-J117 DATED 01/13/2021.
THE TIN SURFACE WITHIN THIS DATA SET HAS BEEN CREATED FROM TERRESTRIAL LASER SCANNING METHODS AND IT SHOULD BE CONSIDERED RELATIVE FOR THE SPECIFIC PURPOSE OF THIS CONTOUR MAP.



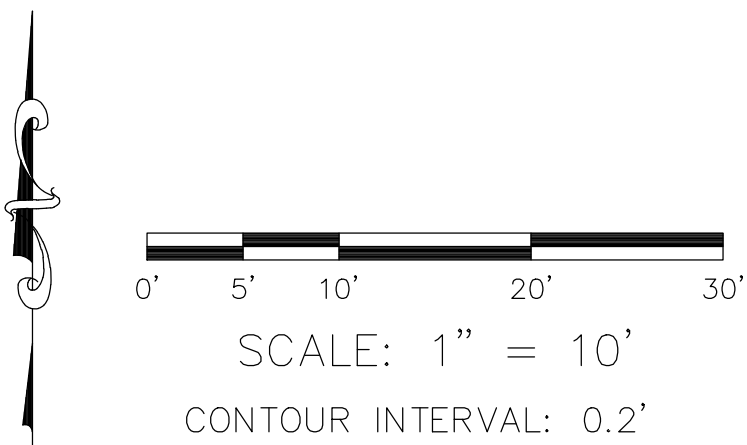


		COUNTY OF ORANGE OC PUBLIC WORKS OC SURVEY/FIELD SERVICES/BOUNDARY ANALYSIS & MAPPING			
JOHN WAYNE AIRPORT STRUCTURES A2 AND B2 (LEVEL 1)					
TOPOGRAPHIC MAP					
PROJECT LIMITS: PARKING STRUCTURE A2 & B2, LEVEL 1					
		DATE OF SURVEY: 03/04/2022		BY: R. MACIAS, PLS	
		MAPPING		BY: H. AFTIM, PLS	
		OFFICE CHECK		BY: M. LAFONTAINE, PLS	
		FIELD CHECK		BY: E. MEDINA, PLS	
MARK		DATE		ITEM	
REVISIONS					
		SCALE: 1" = 10'		W.O. #EX28P446	
		FILE: JOHN WAYNE AIRPORT STRUCTURE A2_TOPO_2022.DWG		FILE #2122PW-JWA0001	
				SHEET NO. 7 of 9	

PARKING STRUCTURE A2, LEVEL 1

SEE SHEET 9

ELEVATIONS TABLE			
NUMBER	MINIMUM ELEVATION	MAXIMUM ELEVATION	COLOR
1	36.88	37.22	
2	37.22	37.36	
3	37.36	37.47	
4	37.47	37.59	
5	37.59	37.72	
6	37.72	37.83	
7	37.83	37.95	
8	37.95	38.07	
9	38.07	38.21	
10	38.21	39.05	

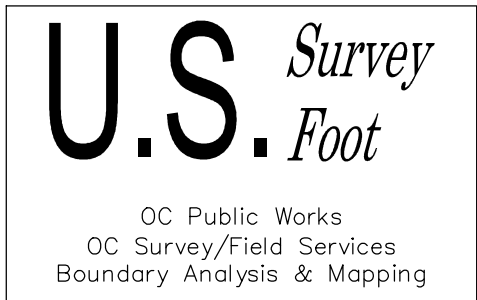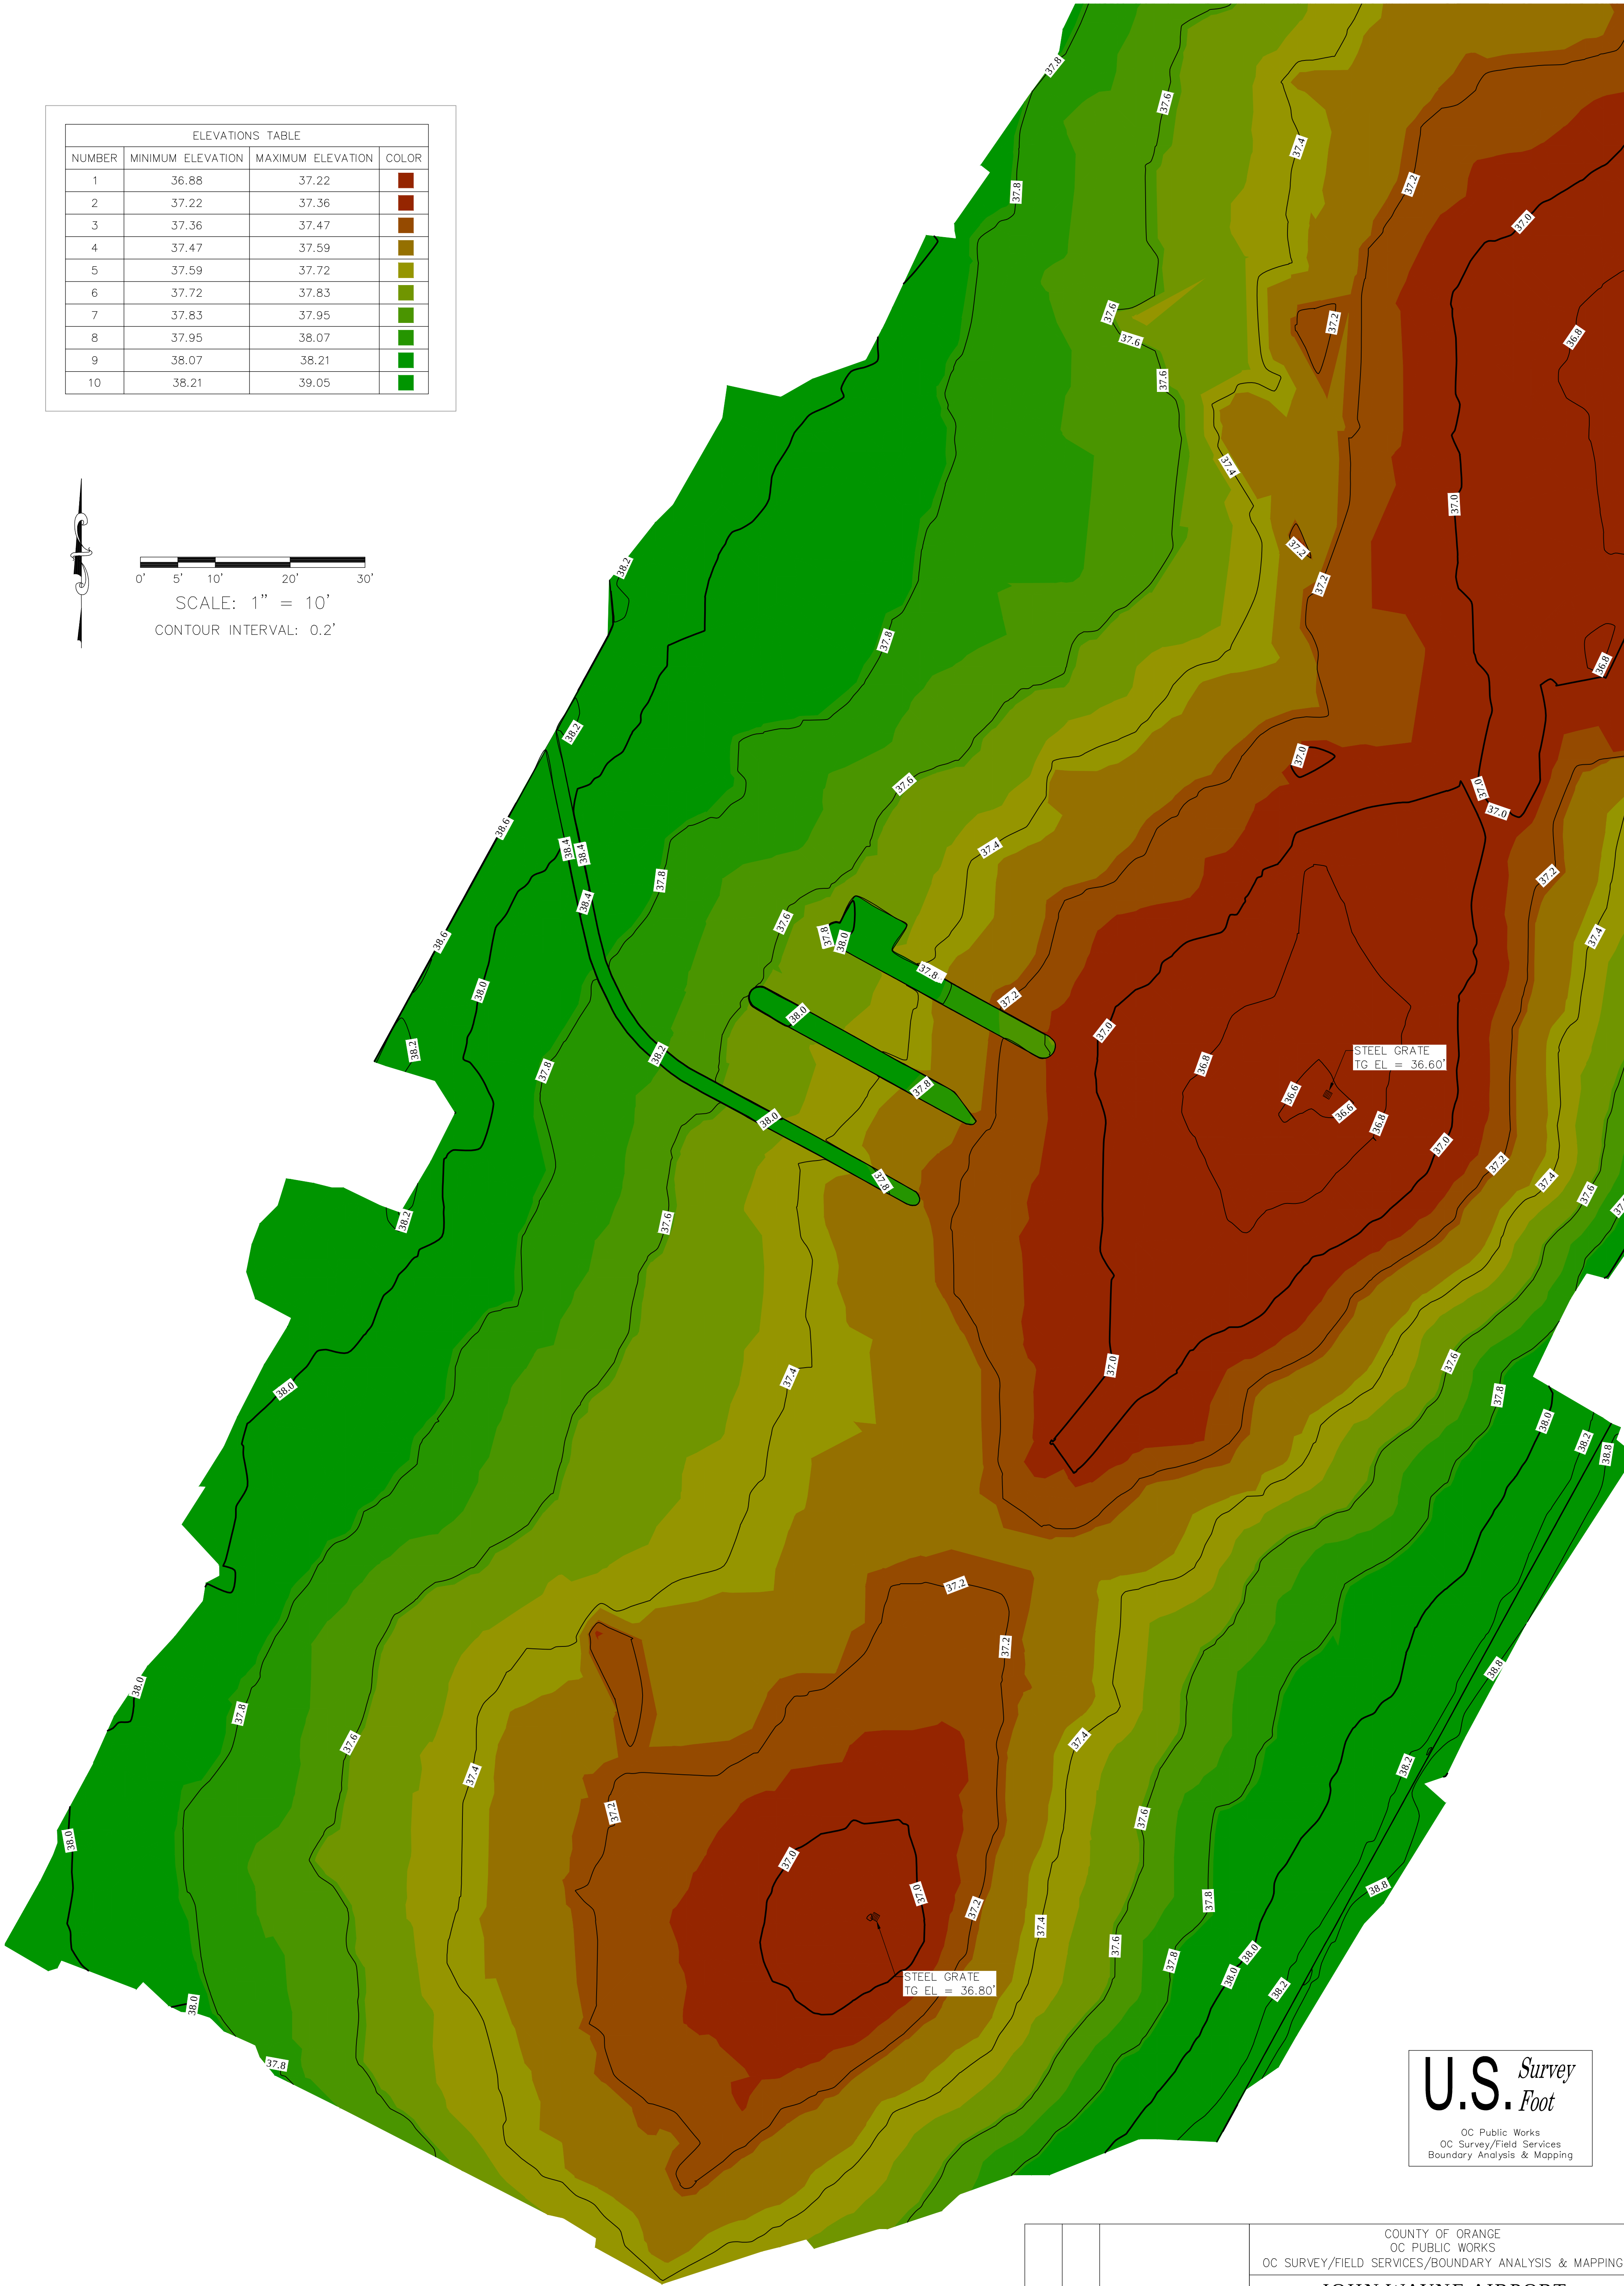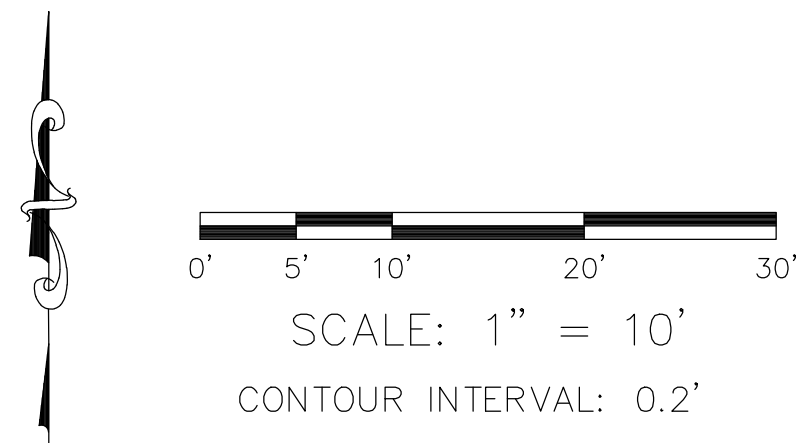

NOTES:
STRIPING AND FLOOR PLAN FEATURES DERIVED FROM SITE PLAN NO 41021-J117 DATED 01/13/2021.
THE TIN SURFACE WITHIN THIS DATA SET HAS BEEN CREATED FROM TERRESTRIAL LASER SCANNING METHODS AND IT SHOULD BE CONSIDERED RELATIVE FOR THE SPECIFIC PURPOSE OF THIS CONTOUR MAP.

			COUNTY OF ORANGE OC PUBLIC WORKS OC SURVEY/FIELD SERVICES/BOUNDARY ANALYSIS & MAPPING	
			JOHN WAYNE AIRPORT STRUCTURES A2 AND B2 (LEVEL 1)	
			TOPOGRAPHIC MAP	
			PROJECT LIMITS: PARKING STRUCTURE A2 & B2, LEVEL 1	SHEET NO. 8 of 9
			DATE OF SURVEY: 03/04/2022	
			MAPPING BY: R. MACIAS, PLS	
			OFFICE CHECK BY: M. LAFONTAINE, PLS	
			FIELD CHECK BY: E. MEDINA, PLS	
MARK	DATE	ITEM	SCALE: 1" = 10' W.O. #EX28P446 FILE #2122PW-JWA0001	
REVISIONS			FILE: JOHN WAYNE AIRPORT STRUCTURE A2_TOPO_2022.DWG	

PARKING STRUCTURE A2, LEVEL 1



ELEVATIONS TABLE			
NUMBER	MINIMUM ELEVATION	MAXIMUM ELEVATION	COLOR
1	36.88	37.22	
2	37.22	37.36	
3	37.36	37.47	
4	37.47	37.59	
5	37.59	37.72	
6	37.72	37.83	
7	37.83	37.95	
8	37.95	38.07	
9	38.07	38.21	
10	38.21	39.05	



0' 5' 10' 20' 30'

SCALE: 1" = 10'

CONTOUR INTERVAL: 0.2'

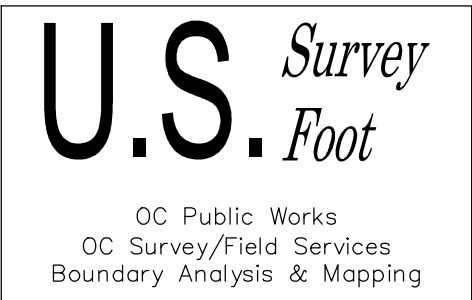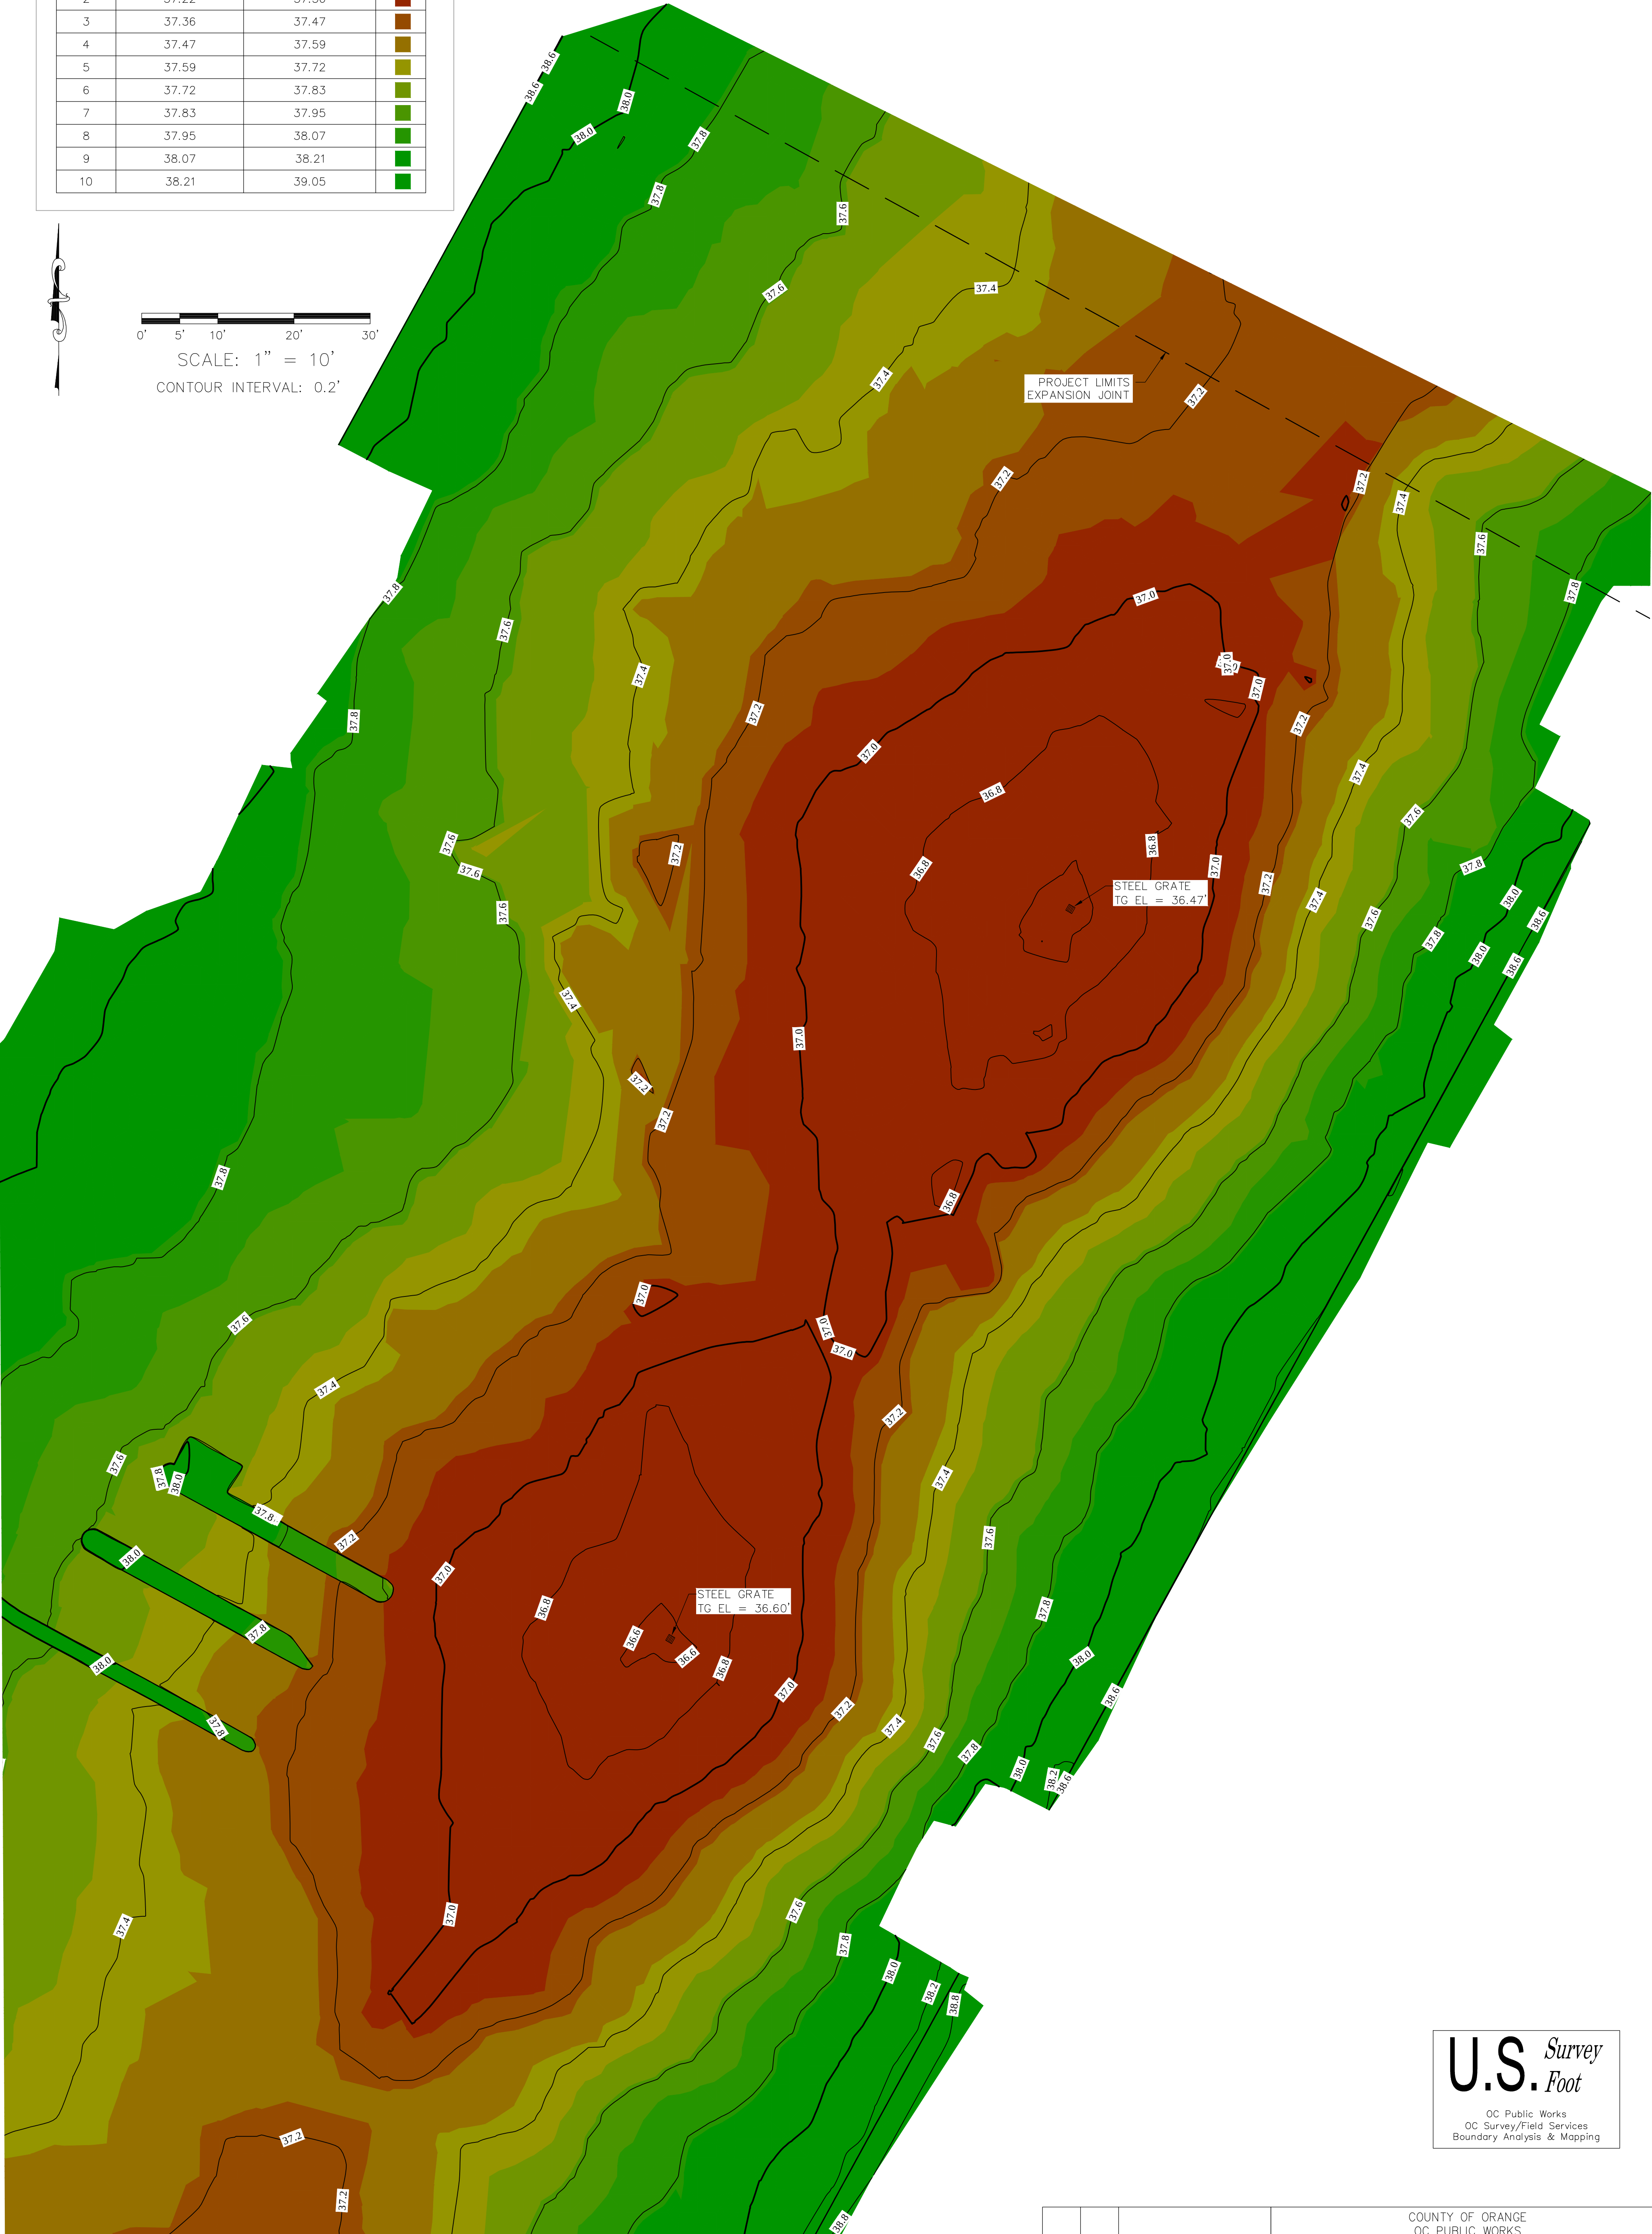

NOTES:

STRIPING AND FLOOR PLAN FEATURES DERIVED FROM SITE PLAN NO 41021-J117 DATED 01/13/2021.

THE TIN SURFACE WITHIN THIS DATA SET HAS BEEN CREATED FROM TERRESTRIAL LASER SCANNING METHODS AND IT SHOULD BE CONSIDERED RELATIVE FOR THE SPECIFIC PURPOSE OF THIS CONTOUR MAP.

SEE SHEET 8

		COUNTY OF ORANGE OC PUBLIC WORKS OC SURVEY/FIELD SERVICES/BOUNDARY ANALYSIS & MAPPING	
JOHN WAYNE AIRPORT STRUCTURES A2 AND B2 (LEVEL 1)			
TOPOGRAPHIC MAP			
PROJECT LIMITS: PARKING STRUCTURE A2 & B2, LEVEL 1			
DATE OF SURVEY: 03/04/2022		BY: R. MACIAS, PLS	
MAPPING		BY: H. AFTIM, PLS	
OFFICE CHECK		BY: M. LAFONTAINE, PLS	
FIELD CHECK		BY: E. MEDINA, PLS	
MARK	DATE	ITEM	SHEET NO. 9 of 9
REVISIONS			
SCALE: 1" = 10'		W.O. #EX28P446	FILE #2122PW-JWA0001
FILE: JOHN WAYNE AIRPORT STRUCTURE		A2_TOPO_2022.DWG	