

Orange County Surveyor

MANHOLE DETAIL:

JOB NO: EX28P440

DATE: 7/24/23

CREW: Joe Kuhl

STREET: AIRPORT WAY



TIME: 10:00 AM / PM

MANHOLE TYPE: SEWER

LID POINT NO: 12038

PHOTO NO: N/A

PIPE MATERIAL: CONCRETE

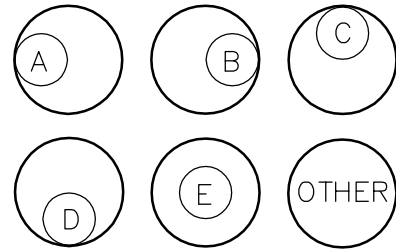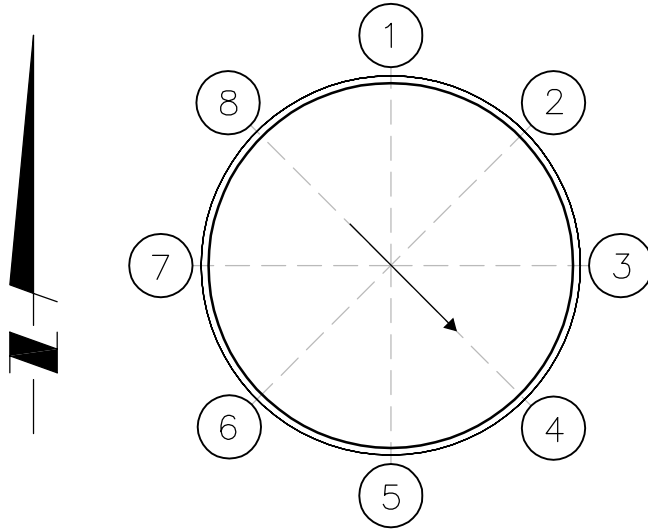

RIM OFFSET TYPE: N/A

NOTE: PIPE DIAMETERS ARE NOT VISIBLE

POINT:	RIM ELEV:	INVERT:	F.L. ELEV:	PIPE DIA:	
1					WET / DRY
2					WET / DRY
3					WET / DRY
4	<u>49.27</u>	<u>-6.97</u>	<u>42.30</u>		WET / DRY
5					WET / DRY
6					WET / DRY
7					WET / DRY
8	<u>49.27</u>	<u>-6.87</u>	<u>42.40</u>		WET / DRY
CNTR:					WET / DRY