

Orange County Surveyor

MANHOLE DETAIL:

JOB NO: EX28P440

DATE: 7/24/23

CREW: Joe Kuhl

STREET: AIRPORT WAY



TIME: 10:00 AM / PM

MANHOLE TYPE: SEWER

LID POINT NO: 12101

PHOTO NO: N/A

PIPE MATERIAL: CONCRETE

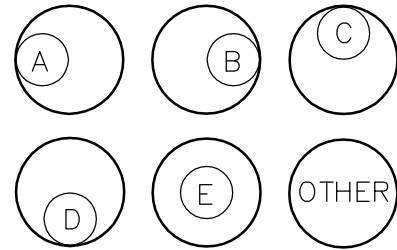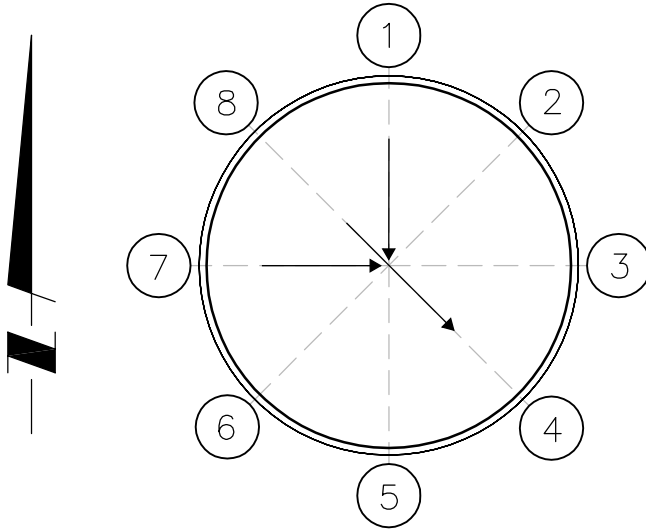

RIM OFFSET TYPE: N/A

NOTE: PIPE DIAMETERS ARE NOT VISIBLE

POINT:	RIM ELEV:	INVERT:	F.L. ELEV:	PIPE DIA:	
1	50.25	-10.40	39.85		WET / DRY
2					WET / DRY
3					WET / DRY
4	50.25	-10.52	39.73		WET / DRY
5					WET / DRY
6					WET / DRY
7	50.25	-10.50	39.75		WET / DRY
8	50.25	-10.45	39.80		WET / DRY
CNTR:					WET / DRY