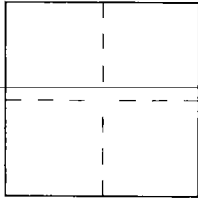


CORNER RECORD

Document Number 2005-0006City of COUNTY OF ORANGECounty of ORANGE, CaliforniaBrief Legal Description CENTERLINE TIES FOR TRACT 16245

CORNER TYPE

Government Corner ☐ Control ☒
Meander ☐ Property ☐
Rancho ☐ Other ☐

Date of Survey DEC. 2004

COORDINATES (Optional)

N. _____
E. _____
Zone _____ NAD27 ☐ NAD83 ☐
NAD83 Epoch _____
Elev. _____
Vert. Datum: NGVD29 ☐ NAVD88 ☐
Meas. Units: Metric ☐ Imperial ☐
U.S. Survey foot ☐

Corner _____ Left as found ☐ Found and tagged ☐ Established ☒ Reestablished ☐ Rebuilt ☐

Identification and type of corner found; Evidence used to identify or procedure used to establish or reestablish the corner:

SET SPIKE, WASHER, R.C.E. 21687 AT THE CENTERLINE
OF STREETS IN THIS TRACT ON COUSTEAU LN., CLYDEDALE DR.
"UNLESS OTHERWISE NOTED"

A description of the physical condition of the monument as found and as set or reset: _____

SURVEYOR'S STATEMENT

This Corner Record was prepared by me or under my direction in conformance with
the Land Surveyor's Act on MARCH 03, 2005

Signed _____ L.S. or R.C.E. No. 21687


COUNTY SURVEYOR'S STATEMENT

This Corner Record was received JAN 04 2005

and examined and filed APR 28 2005Signed _____ L.S. or R.C.E. No. 6185Title COUNTY SURVEYOR

County Surveyor's Comment _____

SEE CORNER RECORD
C.R. 2005-0007

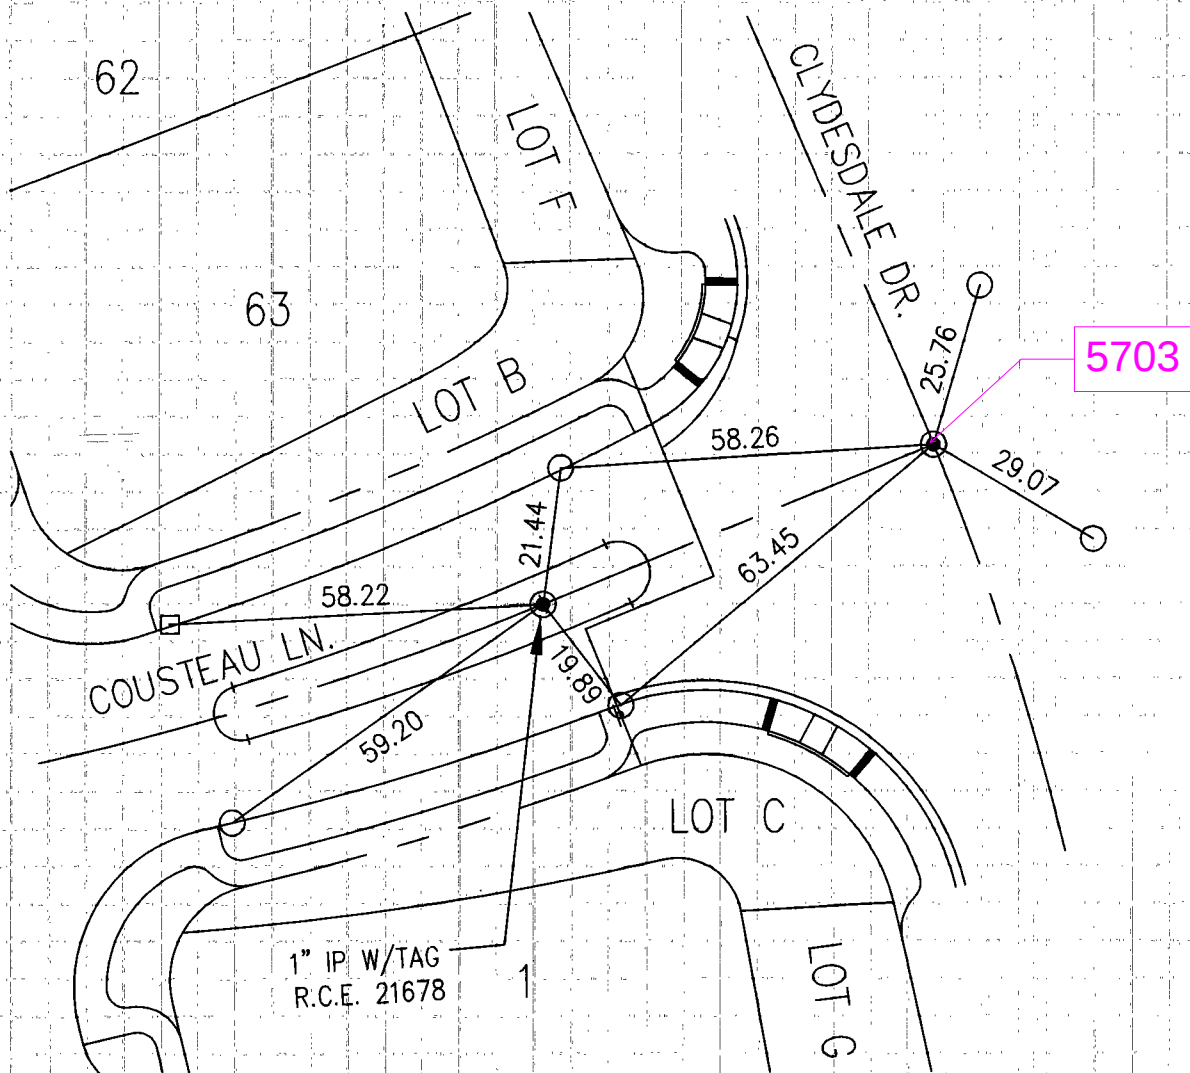

● = FD SPIKE & WASHER RCE 21687
UNLESS OTHERWISE NOTED

□ = SET LEAD AND TAG RCE 21687.
ON PL PROD PER TR. 16245

○ = SET LEAD AND TIE TAG RCE 21687.
SET IN TOP OF CURB

SCALE: 1" = 30'