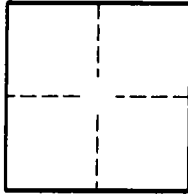


CORNER RECORD

Document Number 2004-1024City of UNINCORPORATED TERRITORY County of ORANGE, CaliforniaBrief Legal Description TRACT NO. 16235, MM 825/30-39

CORNER TYPE

Government Corner ☐ Control ☒
Meander ☐ Property ☐
Rancho ☐ Other ☐
Date of Survey 5-1-04

COORDINATES (OPTIONAL)

N. _____
E. _____
Zone _____ NAD27 ☐ NAD83 ☐
NAD83 Epoch _____
Elev. _____
Vert. Datum: NGVD29 ☐ NAVD88 ☐
Meas. Units: Metric ☐ Imperial ☐

Corner- Left as found ☐ Found and tagged ☐ Established ☒ Reestablished ☐ Rebuilt ☐

Identification and type of corner found: Evidence used to identify or procedure used to establish or reestablish the corner:

THE PURPOSE OF THIS CORNER RECORD IS TO ESTABLISH
THE CENTERLINE OF CLYDESDALE DRIVE.

A description of the physical condition of the monument as found and as set or reset:

1.) SET SPIKE AND WASHER STAMPED "PLS 5557"
2.) SET LEAD, TACT & TAG "PLS 5557 TIE PT."

SURVEYOR'S STATEMENT

This Corner Record was prepared by me or under my direction in conformance with
the Land Surveyors' Act on JUNE 16, 2004

Signed [Signature] P.L.S. or R.C.E. Number 5557

COUNTY SURVEYOR'S STATEMENT


This Corner Record was received JUN 17 2004

and examined and filed JUL 15 2004

Signed [Signature] P.L.S. or R.C.E. Number C.S. 6254

Title DEPUTY COUNTY SURVEYOR

County Surveyor's Comment _____

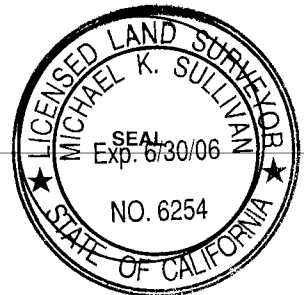

2004-1024

HUITT-ZOLIARS

C/L TIES-TRACT NO. 16235

JAMES F. GILLEN, LS 5557


DATE OF SURVEY

MAY 2004

PARTY

WINKLER

LE BRUN

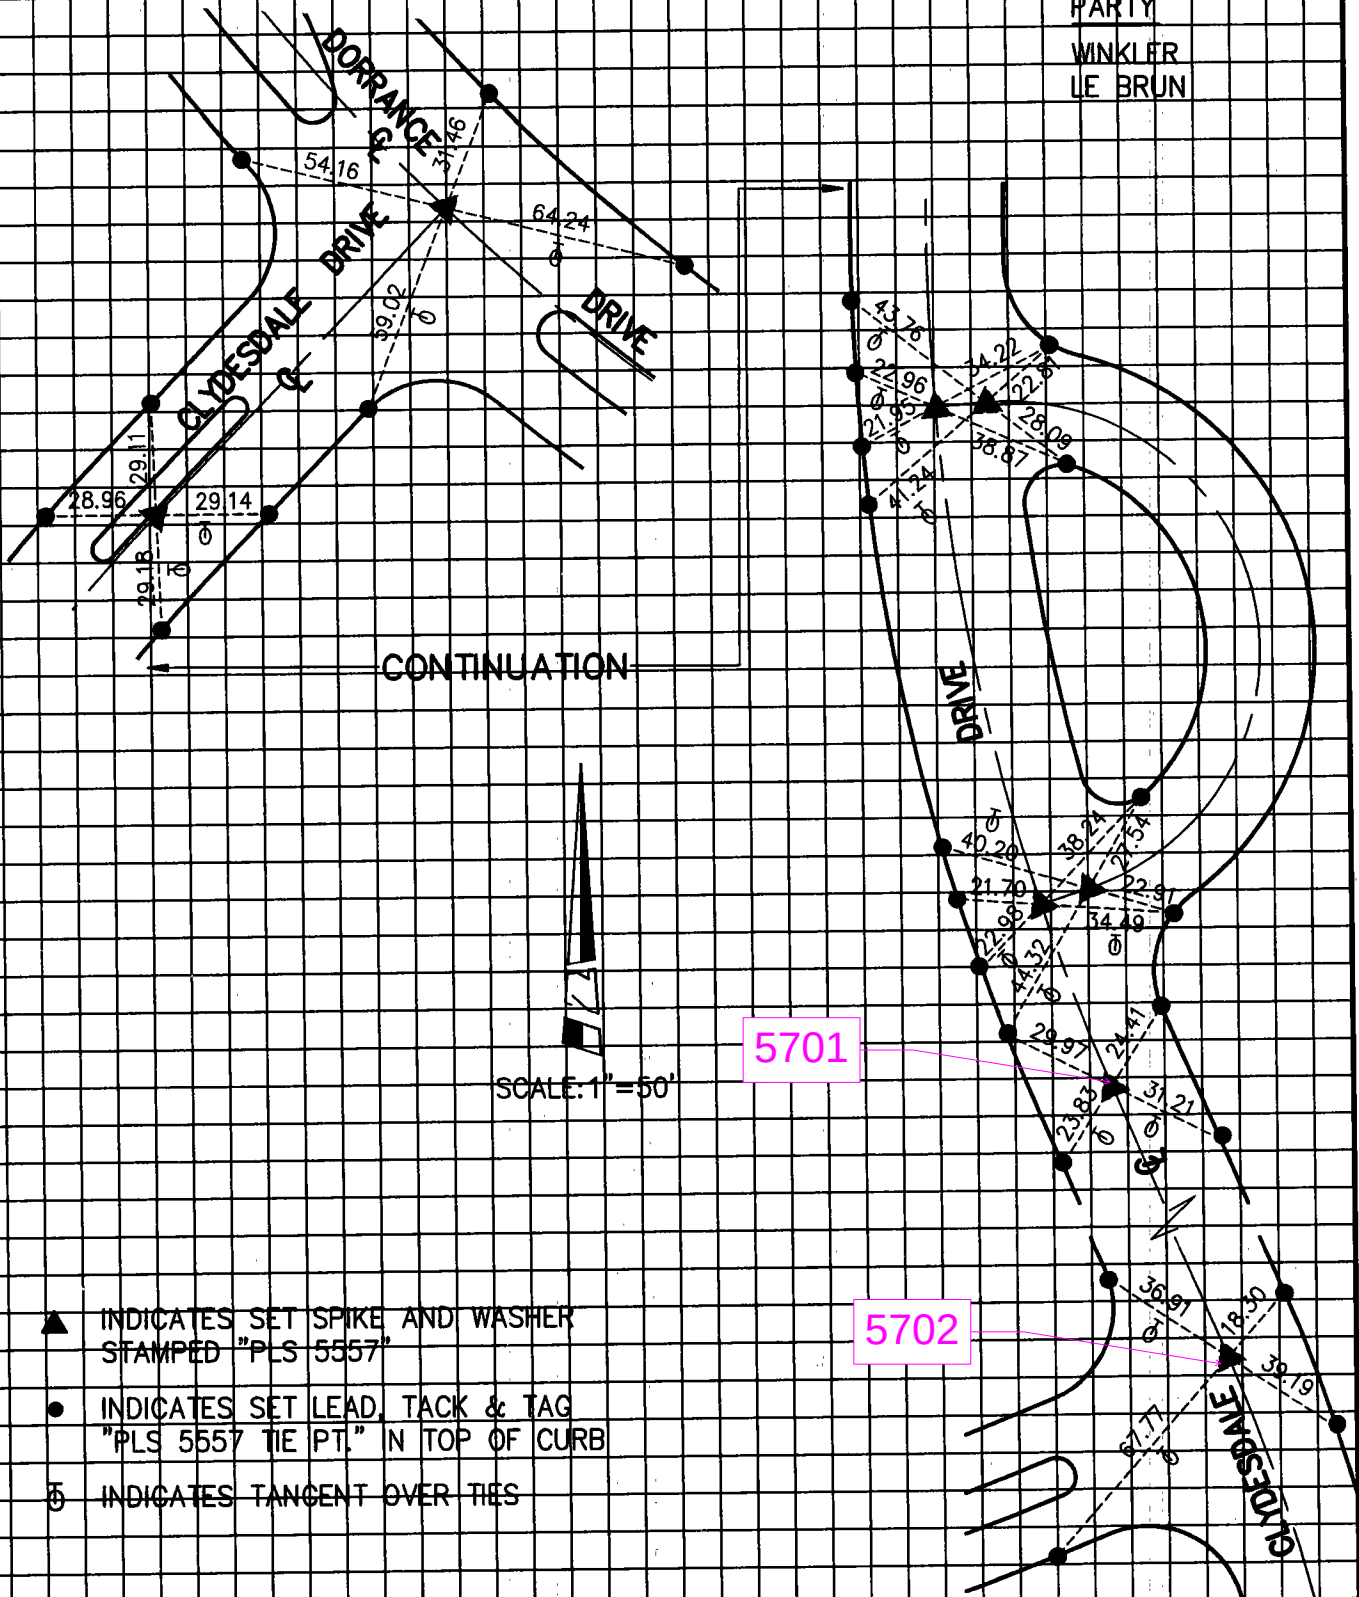

- ▲ INDICATES SET SPIKE AND WASHER
STAMPED "PLS 5557"
- INDICATES SET LEAD, TACK & TAG
"PLS 5557 TIE PT." IN TOP OF CURB
- ⊖ INDICATES TANGENT OVER TIES