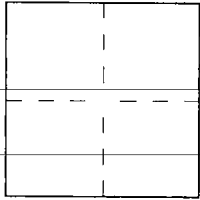


CORNER RECORD

Document Number 2005-0011City of "COUNTY OF ORANGE"County of ORANGE, CaliforniaBrief Legal Description CENTERLINE TIES FOR TRACT 16245

CORNER TYPE

Government Corner ☐ Control ☒
Meander ☐ Property ☐
Rancho ☐ Other ☐

Date of Survey DEC. 2004

COORDINATES (Optional)

N. _____
E. _____
Zone _____ NAD27 ☐ NAD83 ☐
NAD83 Epoch _____
Elev. _____
Vert. Datum: NGVD29 ☐ NAVD88 ☐
Meas. Units: Metric ☐ Imperial ☐
U.S. Survey foot ☐

Corner ☐ Left as found ☐ Found and tagged ☐ Established ☒ Reestablished ☐ Rebuilt ☐


Identification and type of corner found; Evidence used to identify or procedure used to establish or reestablish the corner:

SET SPIKE & WASHER, R.C.E. 21687 AT THE CENTERLINE
OF STREETS IN THIS TRACT ON LA SALLE LANE

A description of the physical condition of the monument as found and as set or reset: _____

SURVEYOR'S STATEMENT

This Corner Record was prepared by me or under my direction in conformance with
the Land Surveyor's Act on MARCH 08, 2005

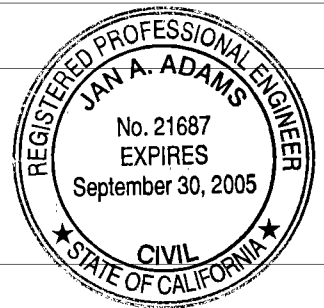
Signed [Signature] L.S. or R.C.E. No. 21687

COUNTY SURVEYOR'S STATEMENT

This Corner Record was received JAN 04 2005and examined and filed APR 28 2005Signed [Signature] (L.S.) or R.C.E. No. 6185Title COUNTY SURVEYOR

County Surveyor's Comment _____

SEE CORNER RECORD
C.R. 2005-0007

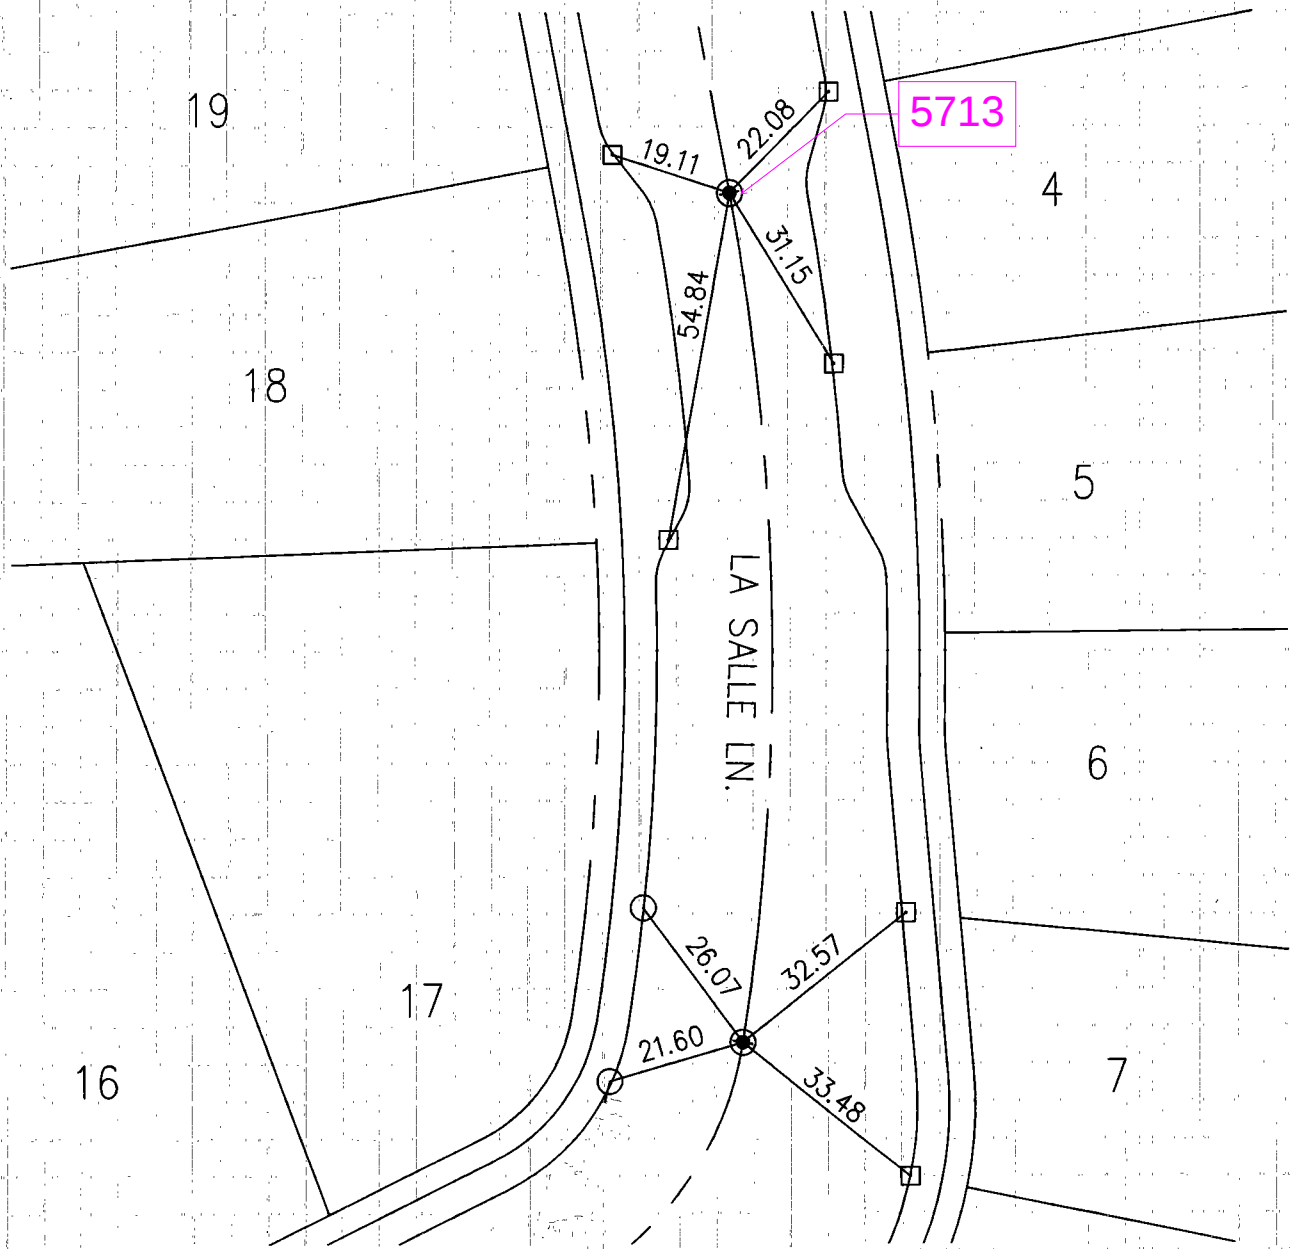

SEE CORNER RECORD
C.R. 2005-0012

- = FD SPIKE & WASHER RCE 21687
- = SET LEAD AND TAG RCE 21687.
ON R PROD PER TR. 16245
- = SET LEAD AND TIE TAG RCE 21687.



SCALE: 1" = 30'