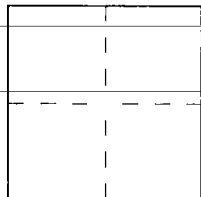


CORNER RECORD

Document Number 2005-0007City of "COUNTY OF ORANGE"County of ORANGE, CaliforniaBrief Legal Description CENTERLINE TIES FOR TRACT 16245

CORNER TYPE

Government Corner ☐ Control ☒
Meander ☐ Property ☐
Rancho ☐ Other ☐

Date of Survey DEC. 2004

COORDINATES (Optional)

N. _____
E. _____
Zone _____ NAD27 ☐ NAD83 ☐
NAD83 Epoch _____
Elev. _____
Vert. Datum: NGVD29 ☐ NAVD88 ☐
Meas. Units: Metric ☐ Imperial ☐
U.S. Survey foot ☐

Corner — Left as found ☐ Found and tagged ☐ Established ☒ Reestablished ☐ Rebuilt ☐

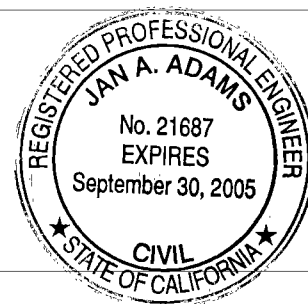
Identification and type of corner found; Evidence used to identify or procedure used to establish or reestablish the corner:

SET SPIKE & WASHER, R.C.E. 21687 AT THE CENTERLINE
OF STREETS IN THIS TRACT ON COUSTEAU LN, LA SALLE LANE.

A description of the physical condition of the monument as found and as set or reset: _____

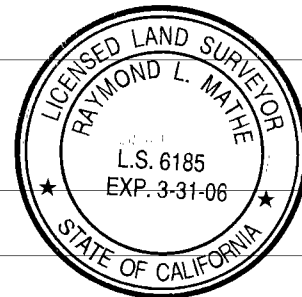
SURVEYOR'S STATEMENT

This Corner Record was prepared by me or under my direction in conformance with
the Land Surveyor's Act on MARCH 08, 2005

Signed _____ L.S. or R.C.E. No. 21687

COUNTY SURVEYOR'S STATEMENT

This Corner Record was received JAN 04 2005
and examined and filed APR 28 2005

Signed _____ L.S. or R.C.E. No. 6185Title COUNTY SURVEYOR

County Surveyor's Comment _____

