


BLOCK 5157
MODULES 14, 24-29, 35-39, 46-49, 59
CORNER RECORD

Document Number 2001-385

City of UNINCORPORATED TERRITORY

County of ORANGE, California

Brief Legal Description TRACT NO. 15615, M.M. 777 / 14-31

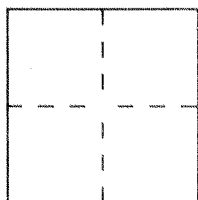

CORNER TYPE

Government Corner ☐ Control ☒
Meander ☐ Property ☐
Rancho ☐ Other ☐
Date of Survey October 2000

COORDINATES
(Optional)

N. _____
E. _____
Zone _____ Datum _____
Elev. _____

Corner — Left as found ☐ Found and tagged ☐ Established ☒ Reestablished ☐ Rebuilt ☐

Identification and type of corner found: Evidence used to identify or procedure used to establish or reestablish the corner:

THE PURPOSE OF THIS CORNER RECORD IS TO PERPETUATE THE
CENTERLINE OF SIENNA PARKWAY, IRON HORSE TRAIL,
SLEEPY HOLLOW LANE, SKYWOOD STREET, AND BLAKEMORE
DRIVE, & Walden Street.


A description of the physical condition of the monument as found and as set or reset: _____

- 1.) SET SPIKE AND WASHER STAMPED "LS 5557" AS NOTED.
- 2.) SET LEAD, TACK AND TAG "LS 5557 TIE PT." AS NOTED
- 3.) SET OCS WELL MONUMENT W/ 2" BRASS CAP
STAMPED "LS 5557" AS NOTED.
- 4.) SET LEAD, TACK AND TAG "PLS 5557" AS NOTED.

SURVEYOR'S STATEMENT

This Corner Record was prepared by me or under my direction in conformance with
the Land Surveyors' Act on FEBRUARY 5 ~~19~~ 2001


Signed James F. Gill L.S. or R.C.E. Number 5557

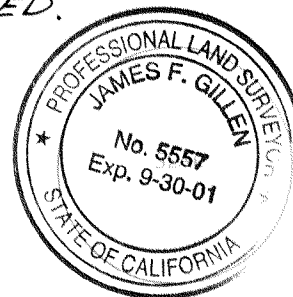

COUNTY SURVEYOR'S STATEMENT
FEB 13 2001

This Corner Record was received _____ and examined
and filed March 29th 2001

Signed Robert Jelinek Title DEPUTY COUNTY SURVEYOR

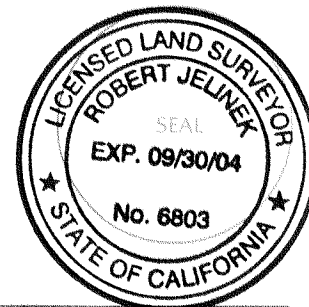

County Surveyor's Comment _____

HUNT-ZOLLARS

C/L TIES-TRACT NO. 15615

JAMES F. GILLEN, LS 5557

C/L LAURELHURST
DRIVE

1454

973

NOT TO SCALE

972

113

112

119

114

118

117

116

115

DATE OF SURVEY

OCTOBER 2000

PARTY

C. BRUSO

B. SANFORD

▲ INDICATES SET SPIKE AND WASHER
STAMPED "LS 5557", UNLESS OTHERWISE
NOTED.

■ INDICATES SET LEAD, TACK & TAG
"LS 5557 TIE PT." IN TOP OF CURB

● INDICATES SET OCS WELL MONUMENT
W/2" BRASS CAP STAMPED "LS 5557"