


CORNER RECORD

Document Number 2006-0257

City of MISSION VIEJO

County of ORANGE, California

Brief Legal Description TR. 8845, MISC. MAP BK. 357, PGS 9-12

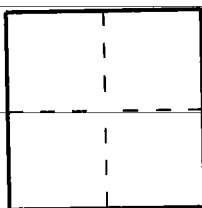

CORNER TYPE

Government Corner ☐ Control ☒
Meander ☐ Property ☐
Rancho ☐ Other ☐
Date of Survey 3/9/06

COORDINATES (Optional)

N. _____
E. _____
Zone _____ Datum _____
Elev. _____

Corner— Left as found ☐ Found and tagged ☐ Established ☐ Reestablished ☒ Rebuilt ☐

Identification and type of corner found; Evidence used to identify or procedure used to establish or reestablish the corner:
THE PURPOSE OF THIS CORNER RECORD IS TO PERPETUATE THE CENTERLINE INTERSECTIONS
OF CROWN VALLEY AND JARDINES, AND THE INTERSECTION OF JARDINES AND TOSSAMAR
AS SHOWN ON TRACT NO. 8845, M. M. 357/ 9-12, AND OCS TIE NOTES A/7- 7, Pg 9


A description of the physical condition of the monument as found and as set or reset:
EXISTING OCS WELL MON, TAG 3109 IN CONC., DN. 1.3 FT. AT JARDINES AND TOSSAMAR

SET SURVEY SPIKE AND 1-1/4" OCS ALUM. TAG AT CROWN VALLEY AND JARDINES AND
BC & EC POINT BETWEEN CROWN VALLEY AND TOSSAMAR

SURVEYOR'S STATEMENT

This Corner Record was prepared by me or under my direction in conformance with
the Land Surveyors' Act on 3/14/06 2006.

Signed [Signature] L.S. or R.C.E. Number 6131

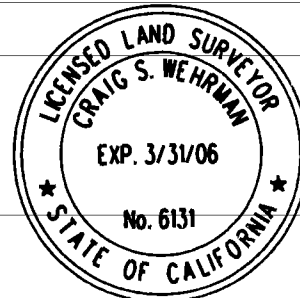

COUNTY SURVEYOR'S STATEMENT

This Corner Record was received 3/24 2006 and examined
and filed MAY 10, 2006.

Signed [Signature] Title DEPUTY COUNTY SURVEYOR



County Surveyor's Comment THIS CORNER RECORD IS PART OF GPS SURVEY " CROWN VALLEY 2 "
CM 580016, EC28120, ZEISSNER & PARTY 3/ 2006

▲ Fd. OCS Well Mon., Tack & 1" Tag LS 3109
in Conc., Dn 1.3'. Per OCS Tie Notes
A/7-7, Page 9

● Fd. Ld. & 1" Tag LS 3109 In TC.
As Per OCS Tie Notes A/7-7, Pg. 9

⊕ Fd. Chis. + In TC. As Per OCS Tie Notes
A/7-7, Pg. 9 Replaced with L & T with 1"
OCS Tie Tag

◇ Set L & T with 1" OCS Tie Tag in TC

○ Set Survey Spk. and 1-1/4" OCS Alum Tag
on Surf. AC.

