
CORNER RECORD Agency Index

• • •			Document Numb	oer <u>20</u>	<u>20-3629</u>	
ity of UN	INCORPORATED TERRITO	DRY	County of	ORANGE	, California	
rief Legal De	escription INTERSECTION	OF ONEILL DR AN	D MCGWIRE RD WEST	ERLY AND MAYWO	OOD DR EASTERLY	
CORNER TYPE				COORDINA	COORDINATES (Optional)	
	Government Corner	Control	N X Elevation		_E	
		_] Property	Units	Metric	U.S. Survey Foot X	
	Rancho	Other	☐ Horizonta	I Datum	, _	
					Date	
	Date of Survey <u>Septer</u>	mber 24, 2020	Vertical D	atum		
					ces Code §§8801-8819 ces Code §§8890-8902	
LS Act Ref:	□ 8765(d) 🗵	8771	□ 8773		Other:	
orner/ onument:		Established	Rebuilt		Pre-Construction	
onument.	☐ Found and tagged ☒	Reestablished	Referenced	X F	Post-Construction	
] NOTES:						
	SUDVEV	OD'S STATEME!	NI T		CS IN D. FRANCES	
		OR'S STATEMEI		nce with	SAN D. FRANKER	
This Corr	ner Record was prepared by	me or under my	direction in conforma	nce with	P.L.S. 7172	
This Corr	ner Record was prepared by ssional Land Surveyors' Act	me or under my onJanuary	direction in conforma 29, 2021		P.L.S. 71/2	
This Corr	ner Record was prepared by ssional Land Surveyors' Act	me or under my onJanuary	direction in conforma		P.L.S. 7172 P.L.S. 7172 P.L.S. 7172	
This Corr	ner Record was prepared by ssional Land Surveyors' Act	me or under my onJanuary	direction in conforma 29, 2021 Sor R.C.E. No.	7172	P.L.S. 11/2	
This Corr the Profe Signed	ner Record was prepared by ssional Land Surveyors' Act	me or under my on January P.I	direction in conforma 29, 2021 Sor R.C.E. No.	7172	P.L.S. 11/2	
This Corr the Profe Signed	ner Record was prepared by ssional Land Surveyors' Act COUNTY SUR	me or under my on January P.I	direction in conforma 29, 2021 Sor R.C.E. No.	7172	P.L.S. 11/2	
This Corr the Profe Signed This Corr and exam	county sure Record was prepared by ssional Land Surveyors' Act COUNTY SUR Record was received	me or under my on January P.I EVEYOR'S STAT FEBRUA APRIL	direction in conforma 29, 2021 Sor R.C.E. No. EMENT RY 2, 2021 26, 2021	7172	P.L.S. 71/2 AND SUPLIN R. HILLSOOP	
This Corr the Profe Signed This Corr and exam Signed	county sure Record was prepared by ssional Land Surveyors' Act COUNTY SUR Record was received	me or under my on January P.I EVEYOR'S STAT FEBRUA APRIL P.I	direction in conformate 29, 2021 Sor R.C.E. No. EMENT RY 2, 2021	7172	P.L.S. 11/2 OF CALIFORNIA OF CALIF	
This Corr the Profe Signed This Corr and exam	county sure Record was prepared by ssional Land Surveyors' Act COUNTY SUR Record was received	me or under my on January P.I EVEYOR'S STAT FEBRUA APRIL P.I	direction in conforma 29, 2021 Sor R.C.E. No. EMENT RY 2, 2021 26, 2021	7172	P.L.S. 11/2 OF CALLFORNIA OF CALLF	
This Correction of the Professigned This Correction and exame Signed Title	county sure Record was prepared by ssional Land Surveyors' Act COUNTY SUR Record was received	me or under my January P.I EVEYOR'S STAT FEBRUA APRIL EYOR	direction in conforma 29, 2021 Sor R.C.E. No. EMENT RY 2, 2021 26, 2021 Sor R.C.E. No.	7172 	P.L.S. M/2 P.L.S.	

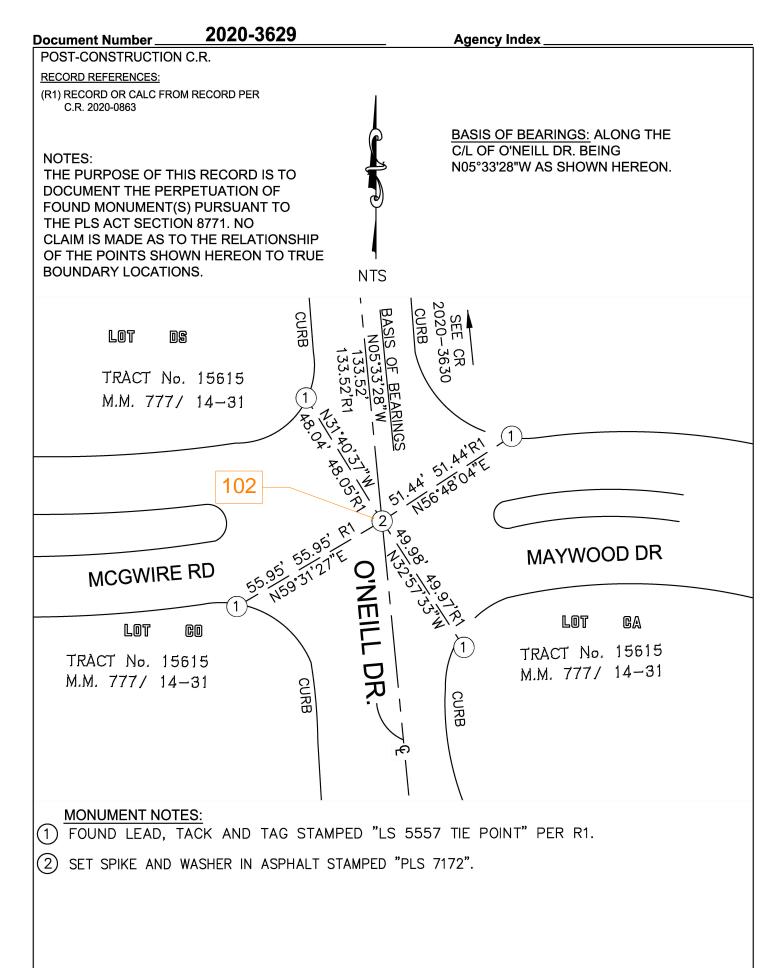

NOTES:

