CORNER RECORD Agency Index

	, <u> </u>		Document Number		<u> 2020-3635</u>
ity of UNINCO	ORPORATED TERR	RITORY	County of	ORANGE	, California
rief Legal Descr	iption END OF A CL	JRVE ON O'NEILL DR A	PPROXIMATELY 429' NOR	THEASTERL	Y OF MAYBECK LN
CORNER TYPE			NE		NATES (Optional)
	Government Corne Meander Rancho Date of Survey Se	Property Other	Vertical Datun	Epocl	U.S. Survey Foot X h Date purces Code §§8801-8819 purces Code §§8890-8902
LS Act Ref:	8765(d)	X 8771	☐ 8773		Other:
orner/ 🔲	Left as found	Established Reestablished	Rebuilt Referenced	X	Pre-Construction Post-Construction
onument:		ument as found, set, r	reset, replaced, or remov	ed:	
onument:		ument as found, set, r	reset, replaced, or remov	red:	ONAL LAND
arrative of corner	identified and monu	ument as found, set, r		red:	SIND. FRANKE
arrative of corner NOTES:	identified and monu	/EYOR'S STATEMEN d by me or under my	NT direction in conformance		SONAL LAND SOLAT D. FRANKER
arrative of corner NOTES:	identified and monu	/EYOR'S STATEMEN d by me or under my Act on	NT direction in conformance	e with	P.L.S. 7172 P.L.S. 7172 P.L.S. 7172
This Corner F	SURV Record was prepared	/EYOR'S STATEMEN d by me or under my Act on P.L SURVEYOR'S STATE	NT direction in conformance 29, 2021 Sor R.C.E. No. 717	e with	P.L.S. 1112
arrative of corner NOTES: This Corner F the Professio Signed	SURV Record was prepared	/EYOR'S STATEMEN d by me or under my Act onP.L SURVEYOR'S STATE GFEBRUAR	NT direction in conformance 29, 2021 Sor R.C.E. No. 717	e with	P.L.S. 1112
arrative of corner NOTES: This Corner F the Professio Signed	SURV Record was prepared nal Land Surveyors' COUNTY S	/EYOR'S STATEMEN d by me or under my Act on January P.L SURVEYOR'S STATE FEBRUAR APRIL	NT direction in conformance 29, 2021 Sor R.C.E. No. 717	e with 72	P.L.S. 71/2

POST-CONSTRUCTION C.R.

RECORD REFERENCES:

(R1) RECORD OR CALC FROM RECORD PER C.R. 2020-0869


NOTES:

THE PURPOSE OF THIS RECORD IS TO DOCUMENT THE PERPETUATION OF FOUND MONUMENT(S) PURSUANT TO THE PLS ACT SECTION 8771. NO CLAIM IS MADE AS TO THE RELATIONSHIP OF THE POINTS SHOWN HEREON TO TRUE BOUNDARY LOCATIONS.



BASIS OF BEARINGS: ALONG THE C/L OF O'NEILL DR. BEING N36°55'01"E AS SHOWN HEREON.

NTS

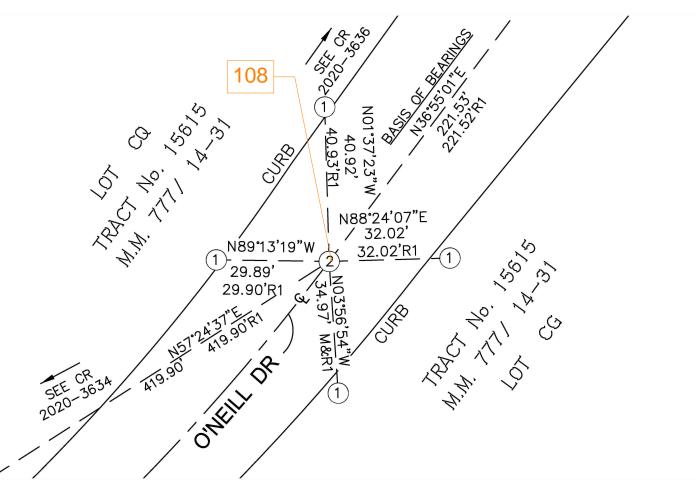

MONUMENT NOTES:

- 1) FOUND LEAD, TACK AND TAG STAMPED "LS 5557 TIE POINT" PER R1.
- 2 SET SPIKE AND WASHER IN ASPHALT STAMPED "PLS 7172".

NOTES:

BEARINGS SHOWN HEREON ARE ASSUMED AND ARE DISPLAYED FOR ANGULAR RELATIONSHIP ONLY.