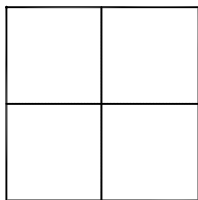


CORNER RECORD

Agency Index

Document Number

2020-0878City of **UNINCORPORATED TERRITORY**County of **ORANGE**, CaliforniaBrief Legal Description **INTERSECTION OF SIENNA PKWY AND CROWN VALLEY PKWY****CORNER TYPE**

Government Corner ☐ Control ☒
Meander ☐ Property ☐
Rancho ☐ Other ☐

Date of Survey January 10, 2020**COORDINATES (Optional)**

N. _____ E. _____
Elevation _____
Units Metric ☐ U.S. Survey Foot ☒
Horizontal Datum _____
Zone _____ Epoch Date _____
Vertical Datum _____

☐ Complies with Public Resources Code §§8801-8819
☐ Complies with Public Resources Code §§8890-8902

PLS Act Ref: ☐ 8765(d) ☒ 8771 ☐ 8773 ☐ Other:

Corner/Monument: ☒ Left as found ☐ Established ☐ Rebuilt ☒ Pre-Construction
☐ Found and tagged ☐ Reestablished ☐ Referenced ☐ Post-Construction

Narrative of corner identified and monument as found, set, reset, replaced, or removed:

☒ NOTES:**SURVEYOR'S STATEMENT**

This Corner Record was prepared by me or under my direction in conformance with
the Professional Land Surveyors' Act on April 17, 2020

Signed  (P.L.S.) or R.C.E. No. 7172**COUNTY SURVEYOR'S STATEMENT**This Corner Record was received APRIL 20, 2020and examined and filed JUNE 23, 2020Signed  (P.L.S.) or R.C.E. No. 6617Title COUNTY SURVEYOR

County Surveyor's Comment _____

PRE-CONSTRUCTION CORNER RECORD

RECORD REFERENCES:


- R1 RECORD OR CALC FROM RECORD PER
C.R. 2001-0383
- R2 RECORD OR CALC FROM RECORD PER
TR. NO. 15615, M.M. 777/14-31
- R3 RECORD OR CALC FROM RECORD PER
TR. NO. 15813, M.M. 795/1-16

NOTES:

THE PURPOSE OF THIS RECORD IS TO DOCUMENT THE PERPETUATION OF FOUND MONUMENT(S) PURSUANT TO THE PLS ACT SECTION 8771. NO CLAIM IS MADE AS TO THE RELATIONSHIP OF THE POINTS SHOWN HEREON TO TRUE BOUNDARY LOCATIONS.

LINE TABLE			
LINE #	BEARING	MEASURED DISTANCE	RECORD DISTANCE
L1	N15°52'55"W	2.61'	2.65' R1
L2	N72°31'43"E	2.33'	2.32' R1
L3	N88°59'29"E	12.61'	13.67' R1
L4	N31°34'56"W	14.03'	15.03' R1
L5	N64°20'46"W	59.35'	59.44' R1
L6	N64°18'46"W	58.81'	58.83' R1

ALL MEASURED TIE DISTANCES THAT EXCEED 0.04 FEET DIFFERENCE FROM RECORD WERE VERIFIED BY STEEL TAPE ON JANUARY 10, 2020.

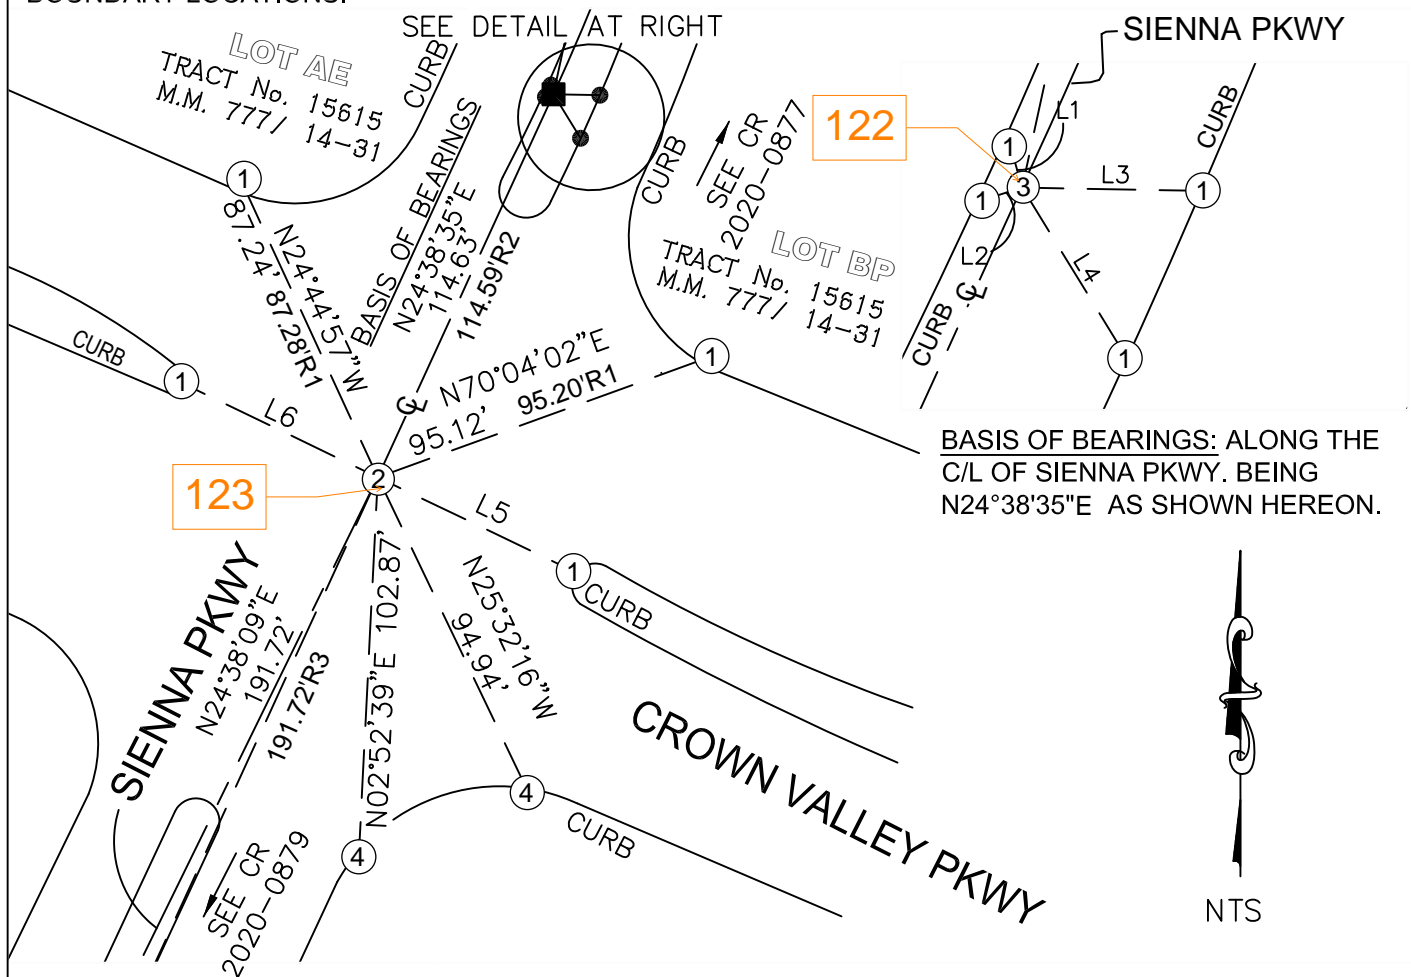

NOTES:

- BEARINGS SHOWN HEREON ARE ASSUMED AND ARE DISPLAYED FOR ANGULAR RELATIONSHIP ONLY.