


BLOCK 5157
MODULES 14, 24-29, 35-39, 46-49, 59
CORNER RECORD

Document Number 2001-382

City of UNINCORPORATED TERRITORY

County of ORANGE, California

Brief Legal Description TRACT NO. 15615, M.M. 777 / 14-31

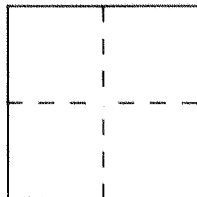

CORNER TYPE

Government Corner ☐ Control ☒
Meander ☐ Property ☐
Rancho ☐ Other ☐
Date of Survey February 2000

COORDINATES
(Optional)

N. _____
E. _____
Zone _____ Datum _____
Elev. _____

Corner — Left as found ☐ Found and tagged ☐ Established ☒ Reestablished ☐ Rebuilt ☐

Identification and type of corner found: Evidence used to identify or procedure used to establish or reestablish the corner:

THE PURPOSE OF THIS CORNER RECORD IS TO PERPETUATE THE
CENTERLINE OF BENJAMIN DRIVE, ARTISAN STREET, CHANTILLY
LANE, AND THORNHILL STREET, AS SHOWN ON TRACT NO.
15615, M.M. 777 / 14-31


A description of the physical condition of the monument as found and as set or reset:

- 1.) SET SPIKE AND WASHER STAMPED "LS 5557" AS NOTED.
- 2.) SET LEAD, TACK, AND TAG "LS 5557 TIE PT." AS NOTED.
- 3.) SET 2" I.P. W/ TAG

SURVEYOR'S STATEMENT

This Corner Record was prepared by me or under my direction in conformance with
the Land Surveyors' Act on FEBRUARY 8 ¹⁹2001

Signed [Signature] L.S. or R.C.E. Number 5557

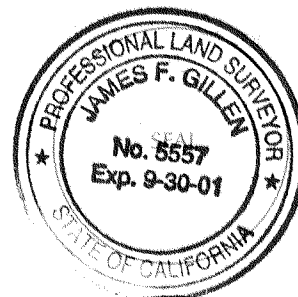

COUNTY SURVEYOR'S STATEMENT

This Corner Record was received FEB 13 2001 and examined

and filed March 30th 2001

Signed [Signature] Title DEPUTY COUNTY SURVEYOR



County Surveyor's Comment _____

HUITT-ZOLLARS

C/L TIES-TRACT NO. 15615

JAMES F. GILLEN, LS 5557


DATE OF SURVEY

FEB 2000

PARTY

C. BRUSO

B. SANFORD

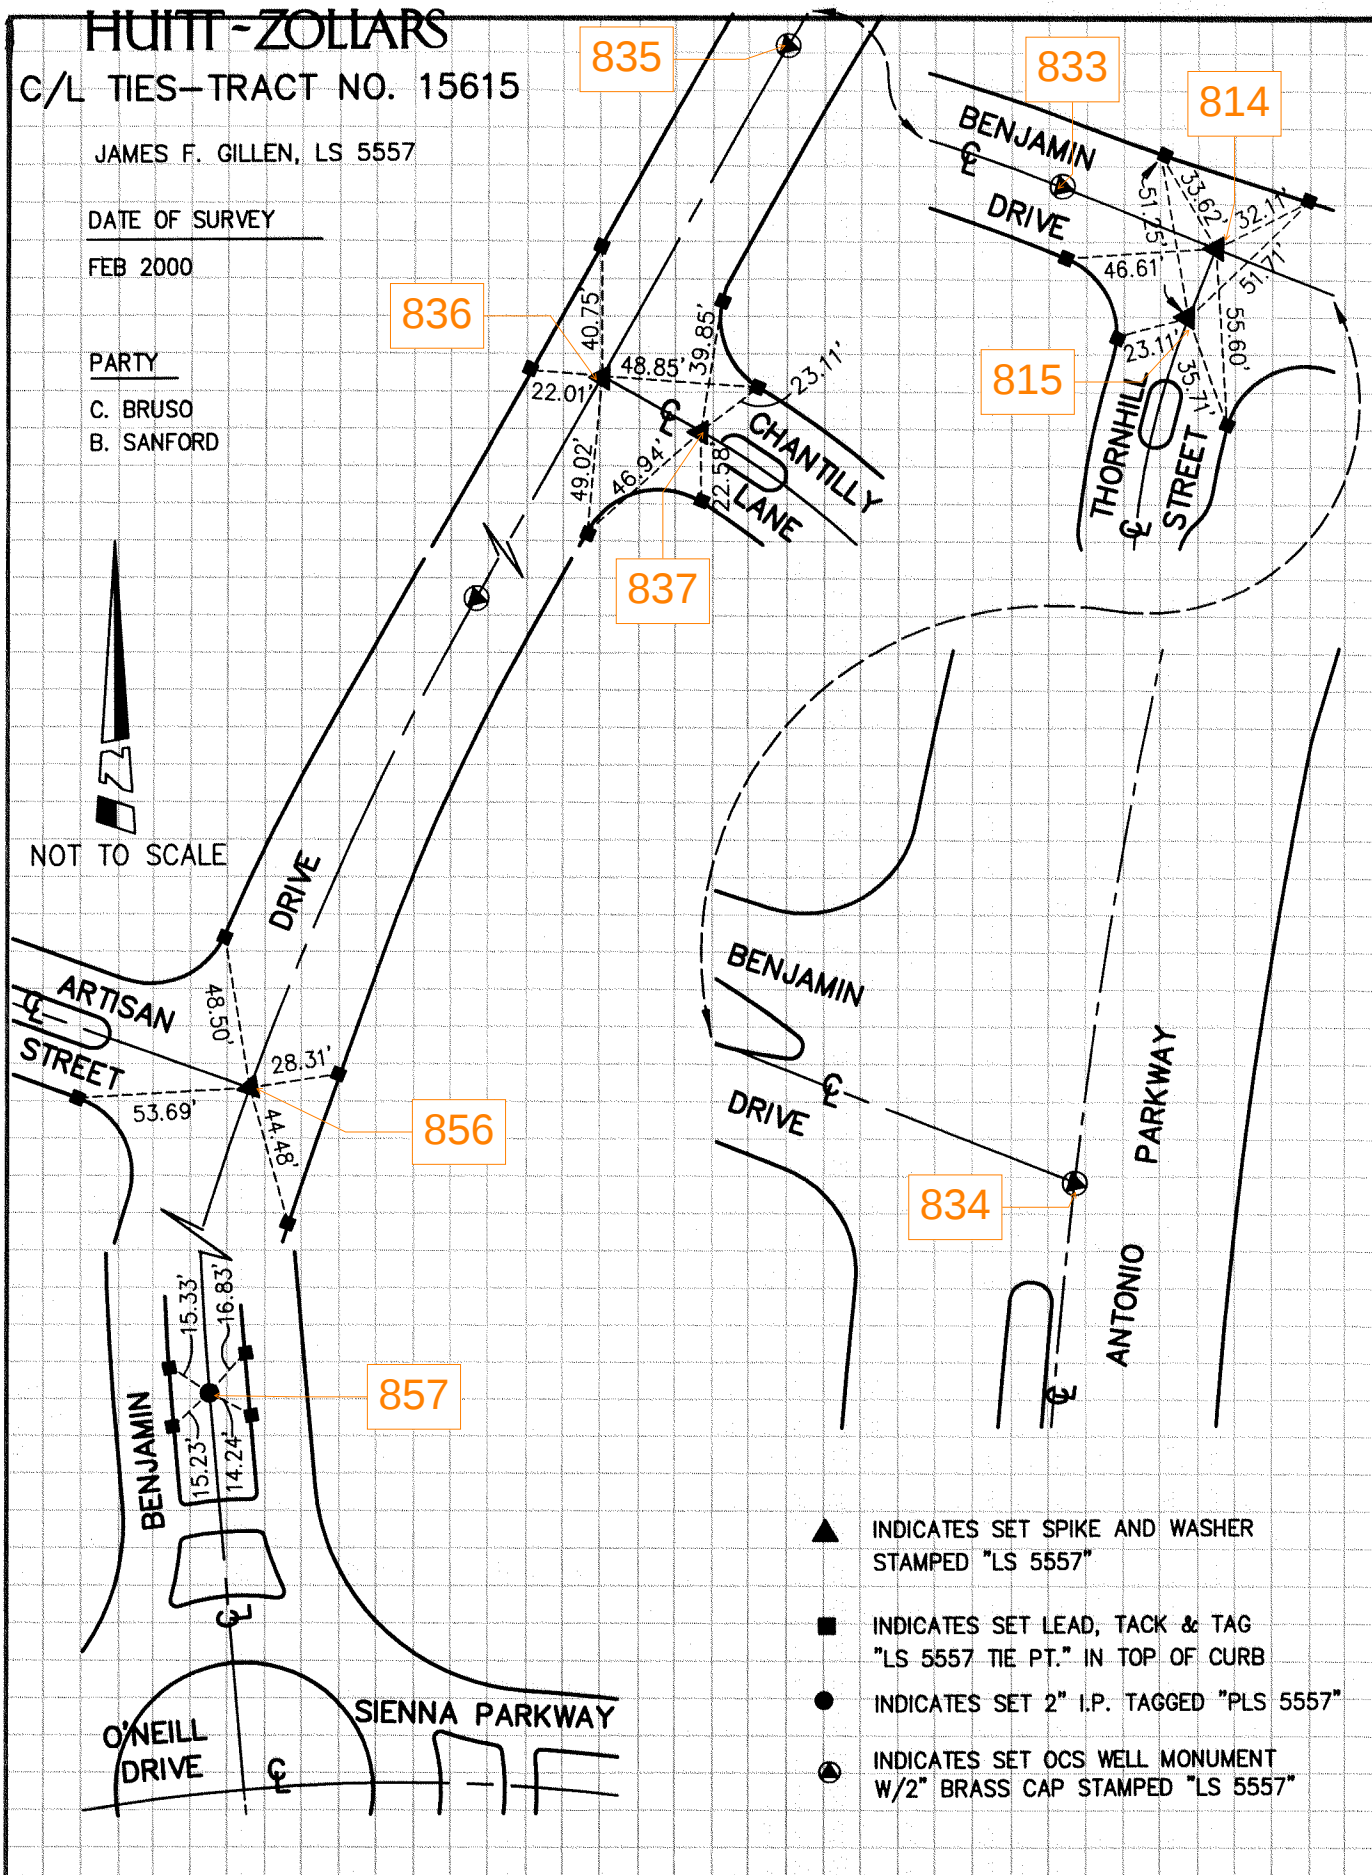

- ▲ INDICATES SET SPIKE AND WASHER STAMPED "LS 5557"
- INDICATES SET LEAD, TACK & TAG "LS 5557 TIE PT." IN TOP OF CURB
- INDICATES SET 2" I.P. TAGGED "PLS 5557"
- INDICATES SET OCS WELL MONUMENT W/2" BRASS CAP STAMPED "LS 5557"