
CORNER RECO	RD	Document Numb	Document Number 2001- 379		
City of UNINCORP	ORATED TERRITORY		RANGE		
Brief Legal Description _	TRACT NO. 1562	3, MM. 784	1/19-21		
	CORNER T	YPE Control	(Op:	DINATES tional)	
	Meander □ Rancho □ Date of Survey NOV,	Property  Other  2000	E D	atum	
Corner — Left as fo	ound  Found and tagged	☐ Established 🔀	Reestablished	Rebuilt []	
THE CENTER	OF THIS CORNE LINE OF CHANT PACT NO. 15623,	ILLY LANES L	VAVERLY PLA	CE, A5	
1) SET SPIKE 2.) SET LEAD, :	ical condition of the monumen  AND WASHER 5  TACK, AND TAG "2  TACK, AND TAG "	TAMPED "LS LS 5557 TIE ,	5557" AS NOTE		
	SURVEYOR'S STATEMEN			SUNAL LAND SUNES F. GILLES	
This Corner Record was re	ceived FEB 1 3 2		amined <b>(6</b>	SEC LAND SURVEY SECRET JELINE	
and filed Mairch Signed Libert	29th Ja 20		ITY SURVEYOR	EXP: 09/30/04  No. 6803	
County Surveyor's Comm				No. 6803	

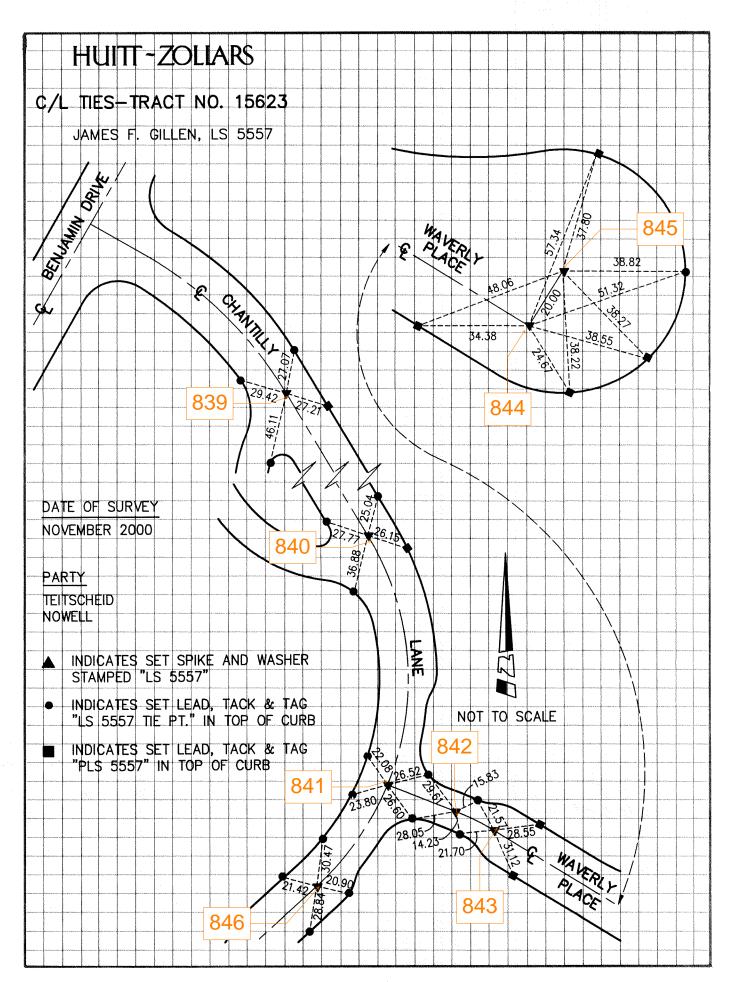

Page 2 of 2