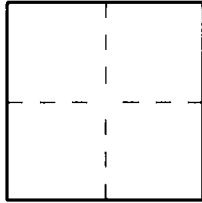


CORNER RECORD

Document Number 2002-2068City of (UNINCORPORATED)County of ORANGE, CaliforniaBrief Legal Description CENTERLINE TIE NOTES FOR TRACT NO. 15625

CORNER TYPE

Government Corner ☐ Control ☐
Meander ☐ Property ☒
Rancho ☐ Other ☐

Date of Survey OCTOBER, 2002

COORDINATES (Optional)

N. _____
E. _____
Zone _____ NAD27 ☐ NAD83 ☐
NAD83 Epoch _____
Elev. _____
Vert. Datum: NGVD29 ☐ NAVD88 ☐
Meas. Units: Metric ☐ Imperial ☐
U.S. Survey foot ☐


Corner — Left as found ☐ Found and tagged ☐ Established ☒ Reestablished ☐ Rebuilt ☐

Identification and type of corner found; Evidence used to identify or procedure used to establish or reestablish the corner:

CENTERLINE TIE NOTES FOR TRACT NO. 15625, M.M. 782/38-44A description of the physical condition of the monument as found and as set or reset: SEE PAGE 2

SURVEYOR'S STATEMENT

This Corner Record was prepared by me or under my direction in conformance with
the Land Surveyor's Act on DECEMBER 10, 2002

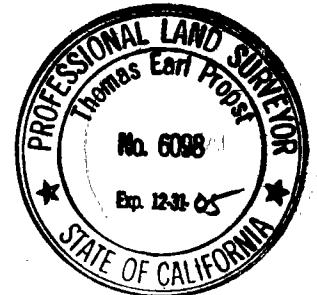
Signed *Thomas Earl Probst* L.S. or R.C.E. No. 6098

COUNTY SURVEYOR'S STATEMENT

This Corner Record was received DEC 17 2002and examined and filed 01-08-03Signed *Michael K. Bull* L.S. or R.C.E. No. 6254Title DEPUTY COUNTY SURVEYOR

County Surveyor's Comment _____

FUSCO ENGINEERING, INC.
LAND SURVEYOR: THOMAS EARL PROPST, P.L.S. 6098

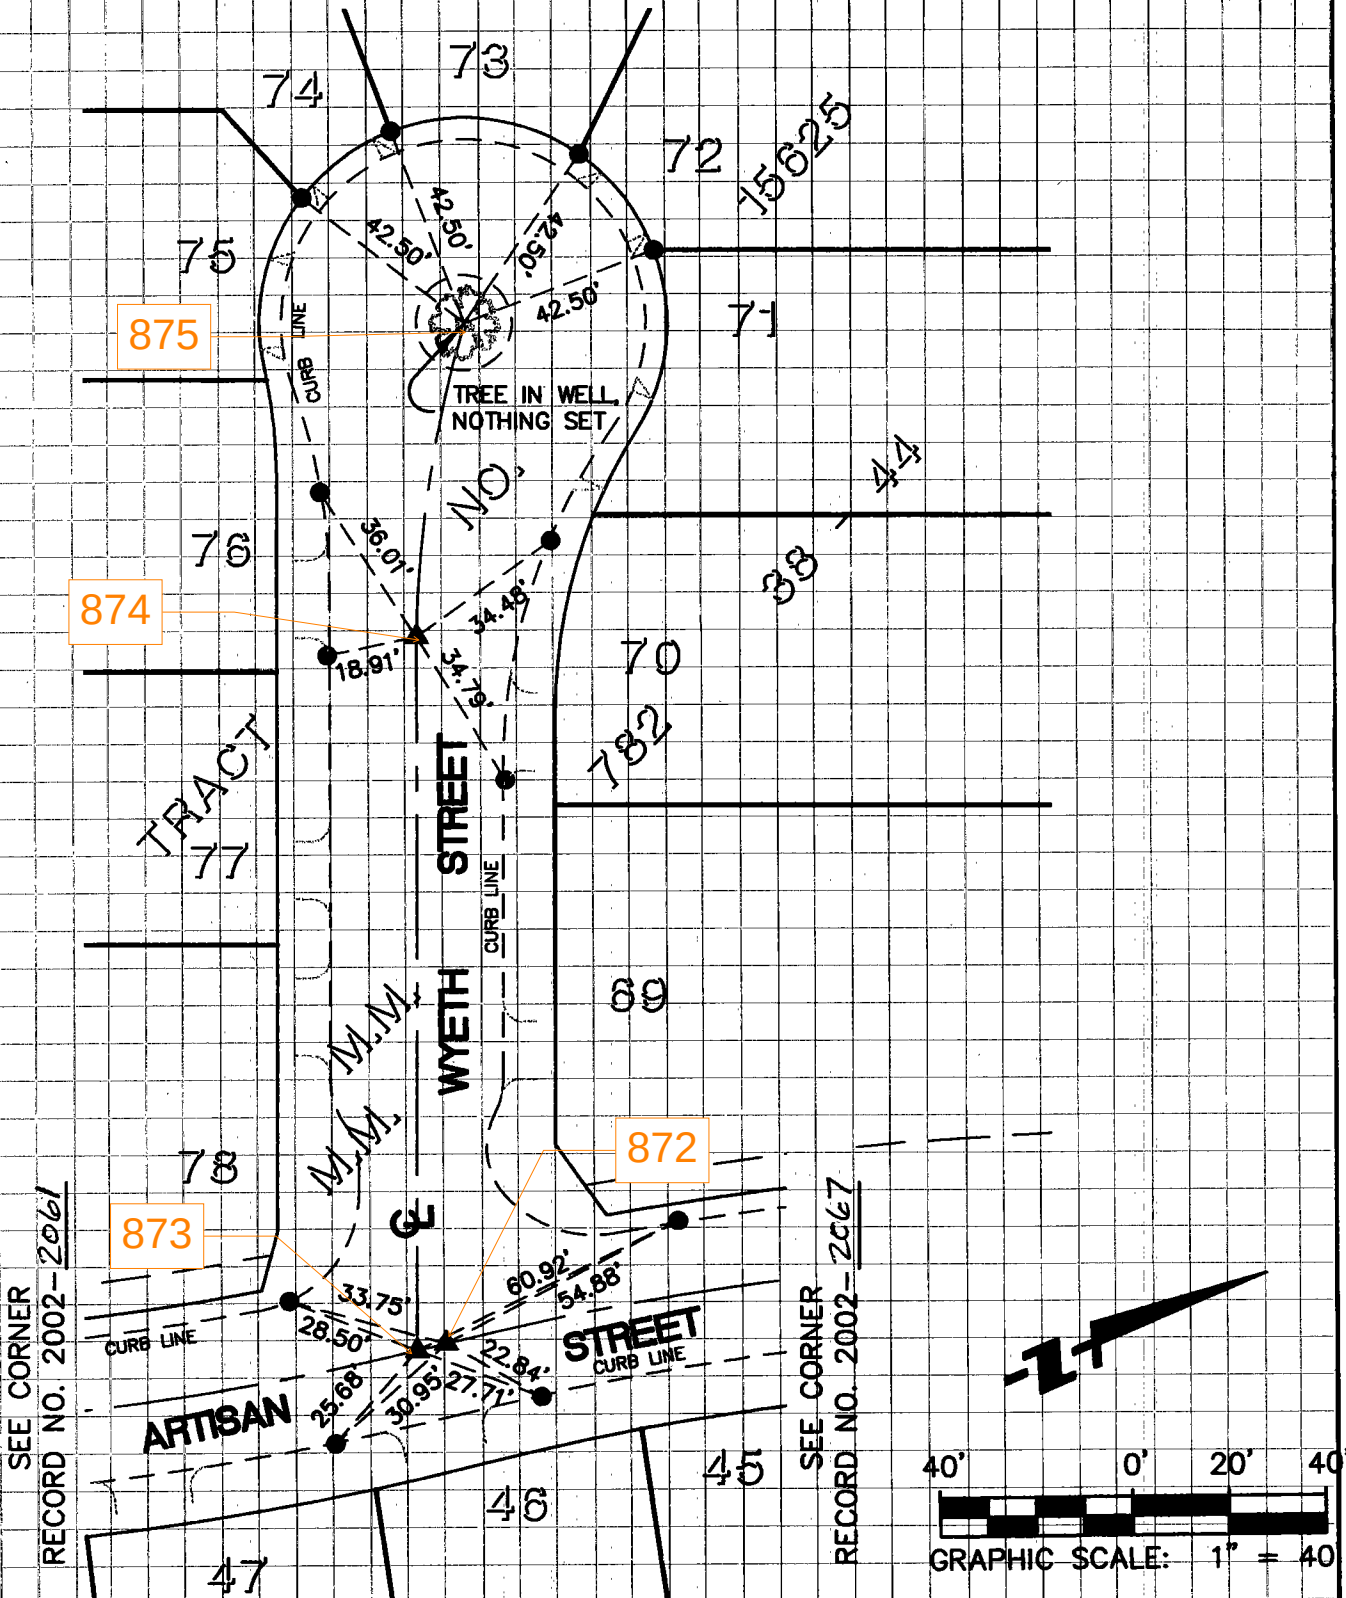

MONUMENT NOTES:

- ▲ SPIKE AND WASHER STAMPED "LS 6098"
- LEAD, NAIL AND TAG STAMPED "LS 6098"