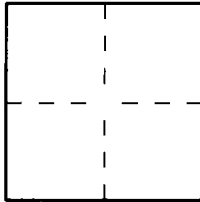


CORNER RECORD

Document Number 2002-2066City of (UNINCORPORATED)County of ORANGE

, California

Brief Legal Description CENTERLINE TIE NOTES FOR TRACT NO. 15625

CORNER TYPE

Government Corner ☐ Control ☐
Meander ☐ Property ☒
Rancho ☐ Other ☐

Date of Survey OCTOBER, 2002

COORDINATES (Optional)

N. _____
E. _____
Zone _____ NAD27 ☐ NAD83 ☐
NAD83 Epoch _____
Elev. _____
Vert. Datum: NGVD29 ☐ NAVD88 ☐
Meas. Units: Metric ☐ Imperial ☐
U.S. Survey foot ☐

Corner — Left as found ☐ Found and tagged ☐ Established ☒ Reestablished ☐ Rebuilt ☐

Identification and type of corner found; Evidence used to identify or procedure used to establish or reestablish the corner:


CENTERLINE TIE NOTES FOR TRACT NO. 15625, M.M. 782/38-44A description of the physical condition of the monument as found and as set or reset: SEE PAGE 2

SURVEYOR'S STATEMENT

This Corner Record was prepared by me or under my direction in conformance with
the Land Surveyor's Act on DECEMBER 10, 2002

Signed  L.S. or R.C.E. No. 6098

COUNTY SURVEYOR'S STATEMENT

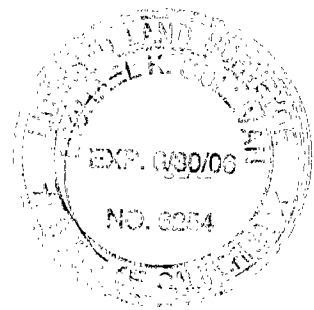This Corner Record was received DEC 17 2002and examined and filed 01-08-03Signed  L.S. or R.C.E. No. 6254Title DEPUTY COUNTY SURVEYOR

County Surveyor's Comment _____

