


CORNER RECORD

Document Number 2001-516

City of UNINCORPORATED TERRITORY

County of ORANGE, California

Brief Legal Description TRACT NO. 15626, M.M. 784/32-35
Wedge Wood & Winfield

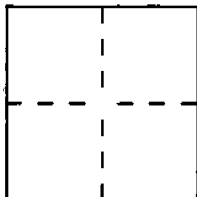

CORNER TYPE

Government Corner ☐ Control ☒
Meander ☐ Property ☐
Rancho ☐ Other ☐
Date of Survey Feb. 2001

COORDINATES (Optional)

N. _____
E. _____
Zone _____ Datum _____
Elev. _____

Corner — Left as found ☐ Found and tagged ☐ Established ☒ Reestablished ☐ Rebuilt ☐

Identification and type of corner found: Evidence used to identify or procedure used to establish or reestablish the corner:

THE PURPOSE OF THIS CORNER RECORD IS TO SET THE
CENTERLINE OF WINFIELD DRIVE, AND WEDGEWOOD
LANE AS SHOWN ON TRACT NO. 15626.

A description of the physical condition of the monument as found and as set or reset:

- 1.) SET SPIKE AND WASHER STAMPED "LS 5557" AS NOTED.
- 2.) SET LEAD, TACK, & TAG "LS 5557 TIE PT." AS NOTED.
- 3.) SET LEAD, TACK, & TAG "LS 5557" AS NOTED.

SURVEYOR'S STATEMENT

This Corner Record was prepared by me or under my direction in conformance with the Land Surveyors' Act on MARCH 1 ~~19~~ 2001

Signed [Signature] L.S. or R.C.E. Number 5557




COUNTY SURVEYOR'S STATEMENT

This Corner Record was received MAR 12 2001 and examined

and filed July 23rd 2001

Signed [Signature] Title DEPUTY COUNTY SURVEYOR

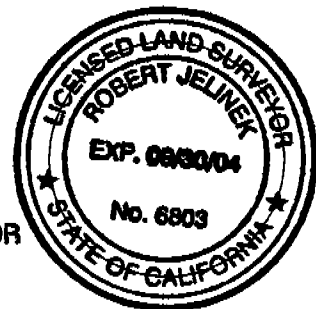

County Surveyor's Comment _____

CR 2001-516

HUITT-ZOLIARS

DATE OF SURVEY

FEBRUARY 2001


C/L TIES-TRACT NO. 15626

JAMES F. GILLEN, LS 5557

PARTY

TEITSCHIED

CLINTON

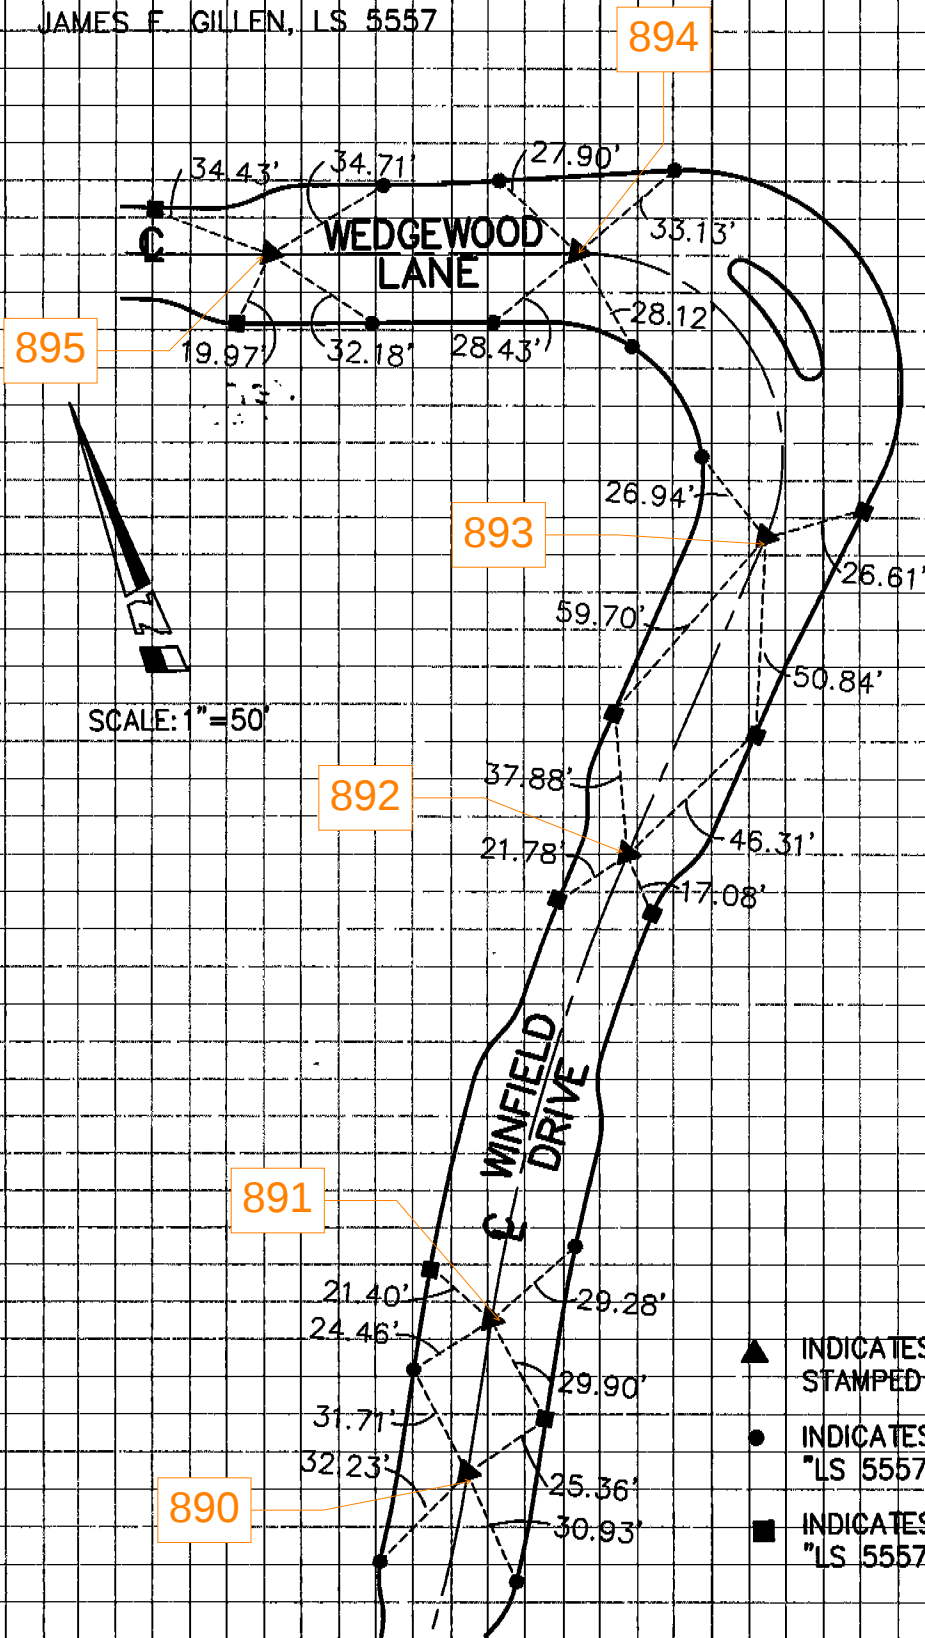

- ▲ INDICATES SET SPIKE AND WASHER STAMPED "LS 5557"
- INDICATES SET LEAD, TACK & TAG "LS 5557 TIE PT." IN TOP OF CURB
- INDICATES SET LEAD, TACK & TAG "LS 5557"