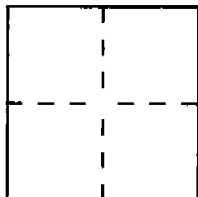


CORNER RECORD

Document Number 2001-514City of UNINCORPORATED TERRITORYCounty of ORANGE, CaliforniaBrief Legal Description TRACT NO. 15626, M.M. 784/32-35
Mason @ Wedgewood

CORNER TYPE

Government Corner ☐ Control ☒
Meander ☐ Property ☐
Rancho ☐ Other ☐
Date of Survey Feb. 2001

COORDINATES (Optional)

N. _____
E. _____
Zone _____ Datum _____
Elev. _____

Corner — Left as found ☐ Found and tagged ☐ Established ☒ Reestablished ☐ Rebuilt ☐

Identification and type of corner found: Evidence used to identify or procedure used to establish or reestablish the corner:


THE PURPOSE OF THIS CORNER RECORD IS TO SET.
THE CENTER LINE OF WEDGEWOOD LANE, AND MASON
LANE AS SHOWN ON TRACT NO. 15626.

A description of the physical condition of the monument as found and as set or reset:


1.) SET SPIKE AND WASHER STAMPED "LS5557" AS NOTED.
2.) SET LEAD, TACK, & TAG "LS5557 TIE PT." AS NOTED.
3.) SET LEAD, TACK, & TAG "LS5557" AS NOTED.

SURVEYOR'S STATEMENT

This Corner Record was prepared by me or under my direction in conformance with
the Land Surveyors' Act on MARCH 1 192001

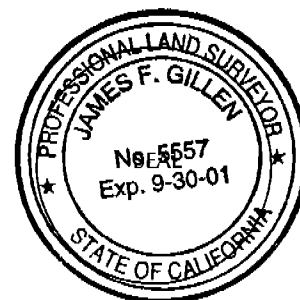Signed James F. Gillen L.S. or R.C.E. Number 5557

COUNTY SURVEYOR'S STATEMENT

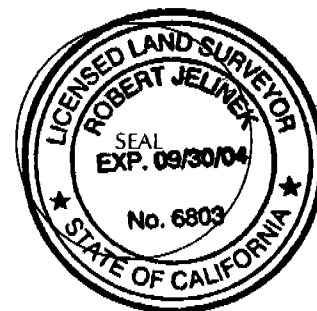This Corner Record was received MAR 12 2001 and examinedand filed July 20th 2001Signed Robert Jelinek Title DEPUTY COUNTY SURVEYOR

County Surveyor's Comment _____

CR 2001-514


HUITT-ZOLLARS

DATE OF SURVEY
FEBRUARY 2001

C/L TIES-TRACT NO. 15626

JAMES F. GILLEN, LS 5557

PARTY
TEITSCHIED
CLINTON

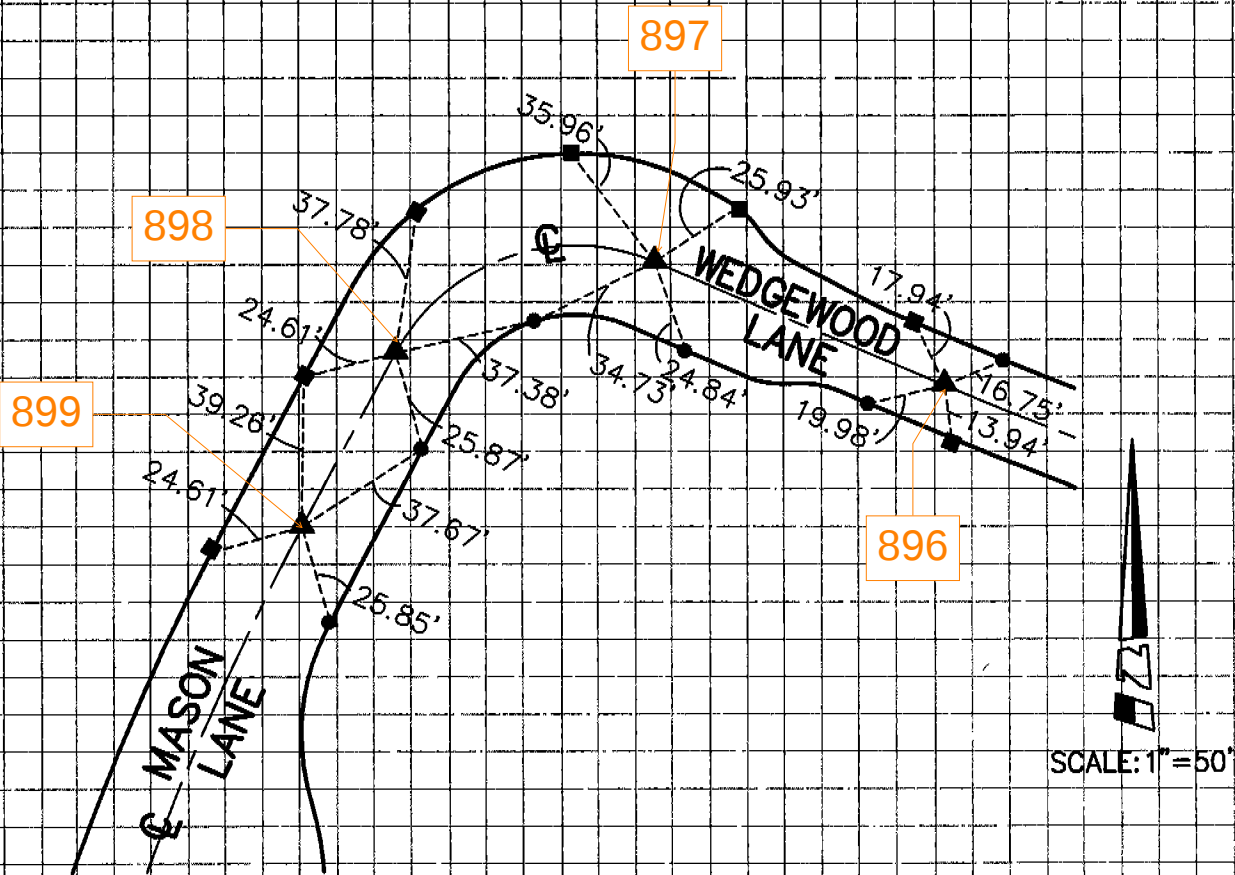

- ▲ INDICATES SET SPIKE AND WASHER
STAMPED "LS 5557"
- INDICATES SET LEAD, TACK & TAG
"LS 5557 TIE PT." IN TOP OF CURB
- INDICATES SET LEAD, TACK & TAG
"LS 5557"