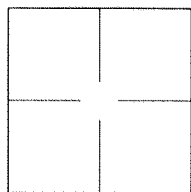


# CORNER RECORD

Document Number 2001-293City of UNINCORPORATED TERRITORYCounty of ORANGE

, California

Brief Legal Description TRACT 15628, M.M 786/23-26E DAWNWOOD & CALM CREEK CIRCLE

## CORNER TYPE

Government corner ☐ Control ☐  
Meander ☐ Property ☐  
Rancho ☐ Other ☒  
Date of Survey DEC. 2000

## COORDINATES (OPTIONAL)

N. \_\_\_\_\_  
E. \_\_\_\_\_  
Zone \_\_\_\_\_ NAD27 ☐ NAD83 ☐  
NAD83 Epoch \_\_\_\_\_  
Elev. \_\_\_\_\_  
Vert. Datum: ☐ NGVD29 ☐ NAVD88 ☐  
Meas. Units: ☐ Metric ☐ Imperial ☐

Corner- Left as found ☐ Found and tagged ☐ Established ☒ Reestablished ☐ Rebuilt ☐

Identification and type of corner found: Evidence used to identify or procedure used to establish or reestablish the corner:  
SET CENTERLINE MONUMENTS AND TIES FOR TRACT 15628

A description of the physical condition of the monument as found and as set or reset: \_\_\_\_\_

SEE PAGE 2 OF 2

## SURVEYOR'S STATEMENT

This Corner Record was prepared by me or under my direction in conformance with  
the Land Surveyors' Act on 1/18/01

Signed [Signature] P.L.S. or R.C.E. Number 28946

## COUNTY SURVEYOR'S STATEMENT


This Corner Record was received JAN 22 2001

and examined and filed March 14th 2001

Signed [Signature] P.L.S. or R.C.E. Number 6803

Title DEPUTY COUNTY SURVEYOR

County Surveyor's Comment \_\_\_\_\_

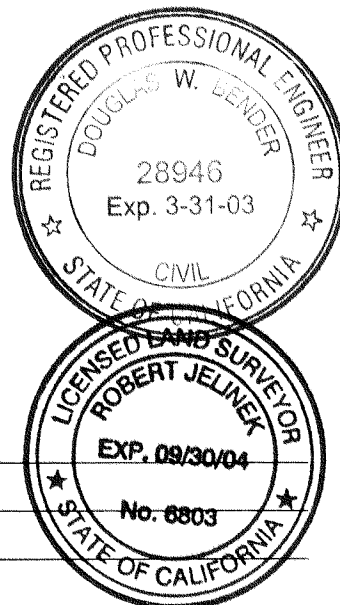

CENTERLINE TIES FOR:  
**TRACT NO. 15628**  
 IN THE UNINCORPORATED TERRITORY OF THE  
 COUNTY OF ORANGE, STATE OF CALIFORNIA

