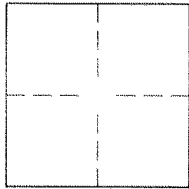


CORNER RECORD

Document Number 2001-292City of UNINCORPORATED TERRITORY County of ORANGE, CaliforniaBrief Legal Description TRACT 15628, M.M 786/23-26 & DAWNWOOD

CORNER TYPE

Government corner ☐ Control ☐
Meander ☐ Property ☐
Rancho ☐ Other ☒
Date of Survey DEC. 2000

COORDINATES (OPTIONAL)

N. _____
E. _____
Zone _____ NAD27 ☐ NAD83 ☐
NAD83 Epoch _____
Elev. _____
Vert. Datum: ☐ NGVD29 ☐ NAVD88 ☐
Meas. Units: ☐ Metric ☐ Imperial ☐

Corner- Left as found ☐ Found and tagged ☐ Established ☒ Reestablished ☐ Rebuilt ☐Identification and type of corner found: Evidence used to identify or procedure used to establish or reestablish the corner:
SET CENTERLINE MONUMENTS AND TIES FOR TRACT 15628A description of the physical condition of the monument as found and as set or reset: _____
SEE PAGE 2 OF 2


SURVEYOR'S STATEMENT

This Corner Record was prepared by me or under my direction in conformance with
the Land Surveyors' Act on 1/18/01Signed [Signature] P.L.S. or R.C.E. Number 28946

COUNTY SURVEYOR'S STATEMENT

This Corner Record was received JAN 22 2001and examined and filed March 14th 2001Signed Robert Jelinet P.L.S. or R.C.E. Number 6803Title DEPUTY COUNTY SURVEYOR

County Surveyor's Comment _____

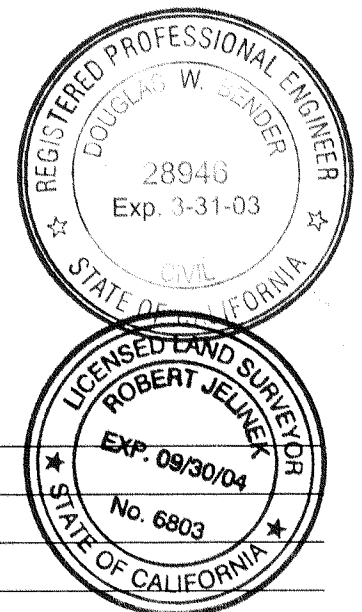

CENTERLINE TIES FOR:
TRACT NO. 15628
 IN THE UNINCORPORATED TERRITORY OF THE
 COUNTY OF ORANGE, STATE OF CALIFORNIA



SCALE: 1"=40'

TRACT BOUNDARY

