


CORNER RECORD

Document Number 2002-207

Unincorporated Territory _____ County of Orange, California

Brief Legal Description Centerline ties for Tract No. 15627, MM 785/17-20 (Dawnwood)

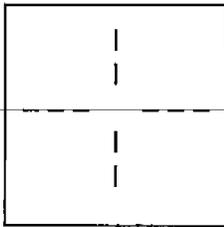

CORNER TYPE

Government Corner Control
Meander Property
Rancho Other
Date of Survey JAN 31 2001

COORDINATES (Optional)

N. _____
E. _____
Zone _____ NAD27 NAVD83
NAD83 Epoch _____
Elev. _____
Vert. Datum; NGVD29 NAVD88
Meas. Units: Metric Imperial
U.S. Survey foot

Corner — Left as found Found and tagged Established Reestablished Rebuilt

Identification and type of corner found/evidence used to identify or procedure used to establish or reestablish the corner:
Set ties for centerline monuments found per Tract No. 15627.

A description of the physical condition of the monument as found and as set or reset: SEE PAGE 2 OF THIS RECORD

SURVEYOR'S STATEMENT

This Corner Record was prepared by me or under my direction in conformance

with the Land Surveyor's Act on 2/18/02

Signed James R. Crawford L.S. Number 4965



COUNTY SURVEYOR'S STATEMENT

FEB 19 2002

This Corner Record was received _____

and examined and filed 03/12/02

Signed Michael K. Sullivan L.S. or R.C.E. No. 6254

Title DEPUTY



County Surveyor's Comment _____


MONUMENT NOTES

- DENOTES FD. S & W STAMPED "LS 4965"
- DENOTES SET L & T W/ TAG "LS 4965 TIE"
- ⊗ DENOTES SET L & T W/ TAG "LS 4965"

NOT TO SCALE

SEE CORNER RECORD 2002-

H:\PDATA\34338.G5\DWG\TR15627\CLTIES\338CT001.DWG

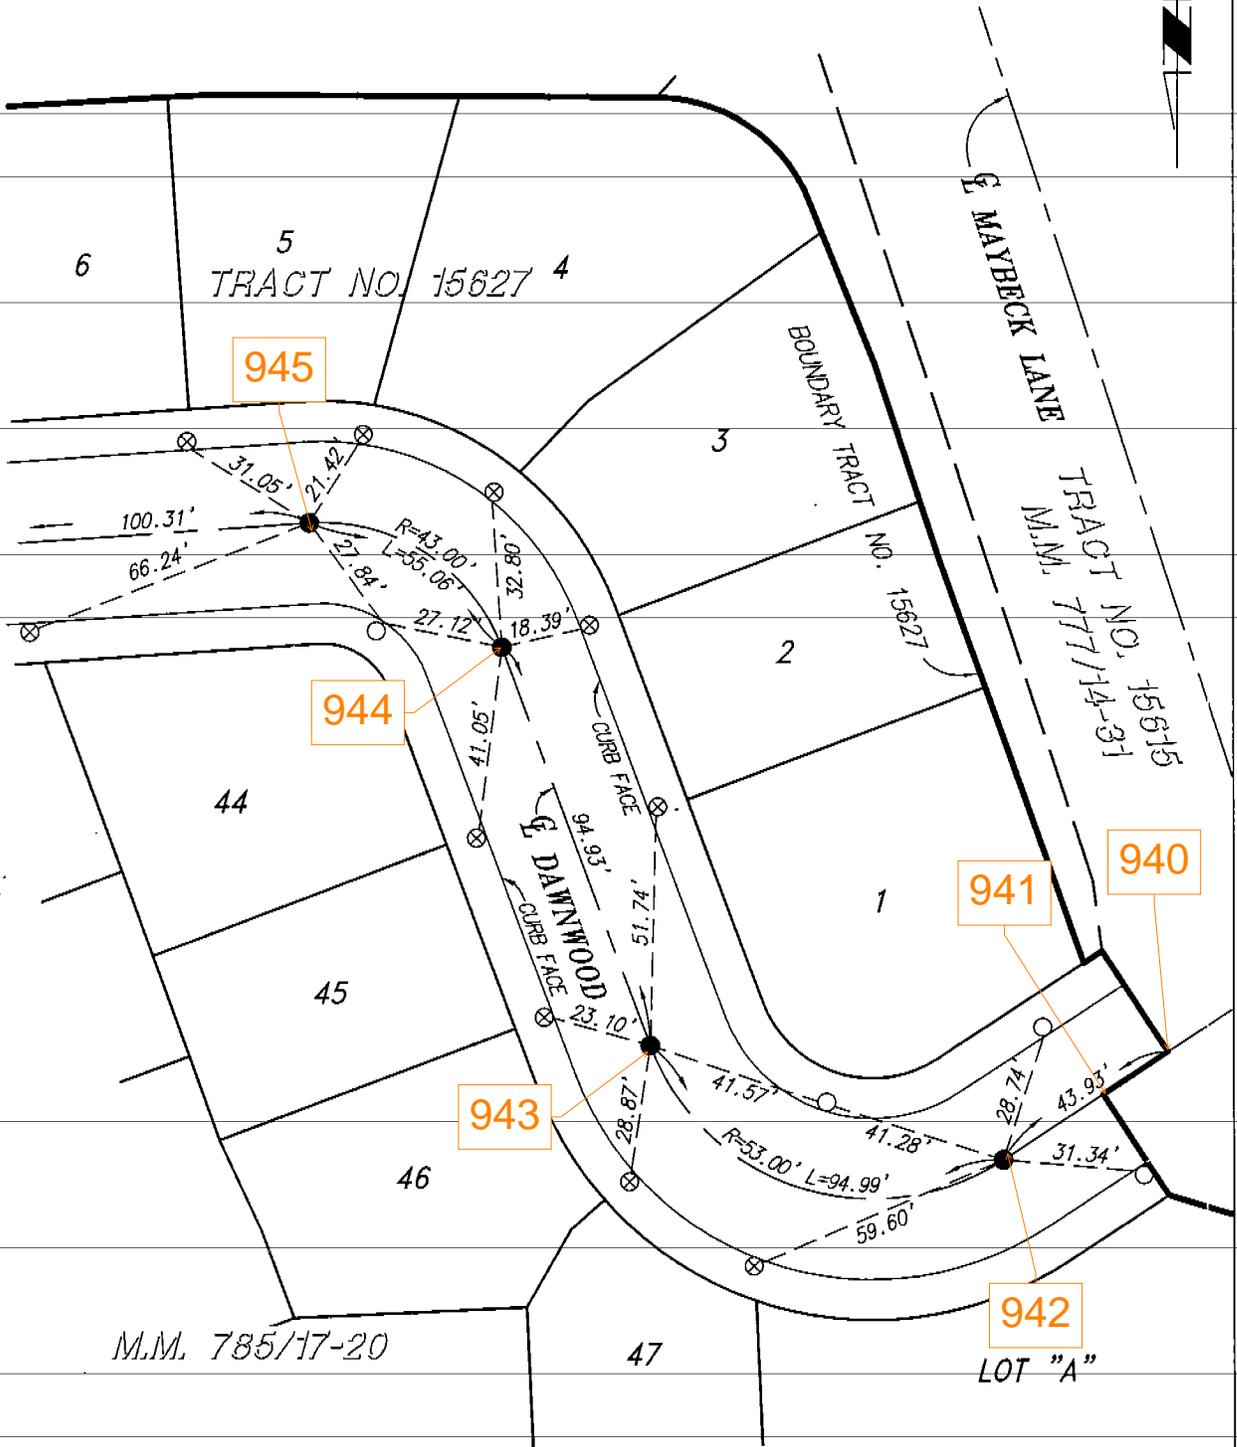

M.M. 785/17-20

LOT "A"