


CORNER RECORD

Document Number 2002-206

Unincorporated Territory _____ County of Orange, California

Brief Legal Description Centerline ties for Tract No. 15627, MM 785/17-20 (Dawnwood and Earlywood)

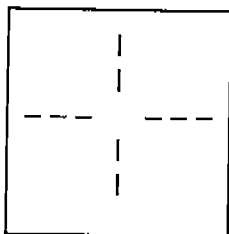

CORNER TYPE

Government Corner ☐ Control ☐
Meander ☐ Property ☐
Rancho ☐ Other ☒

Date of Survey JAN 31 2001

COORDINATES (Optional)

N. _____
E. _____
Zone _____ NAD27 ☐ NAVD83 ☐
NAD83 Epoch _____
Elev. _____
Vert. Datum; NGVD29 ☐ NAVD88 ☐
Meas. Units: Metric ☐ Imperial ☐
U.S. Survey foot ☐

Corner — Left as found ☐ Found and tagged ☐ Established ☒ Reestablished ☐ Rebuilt ☐

Identification and type of corner found/evidence used to identify or procedure used to establish or reestablish the corner:
Set ties for centerline monuments found per Tract No. 15627.

A description of the physical condition of the monument as found and as set or reset: _____

SEE PAGE 2 OF THIS RECORD

SURVEYOR'S STATEMENT

This Corner Record was prepared by me or under my direction in conformance
with the Land Surveyor's Act on 2/13/02

Signed James R. Crawford L.S. Number 4965

COUNTY SURVEYOR'S STATEMENT


This Corner Record was received FEB 19 2002

and examined and filed 03/12/02

Signed Michael K. Sullivan L.S. or R.C.E. No. 6254

Title DEPUTY

County Surveyor's Comment _____

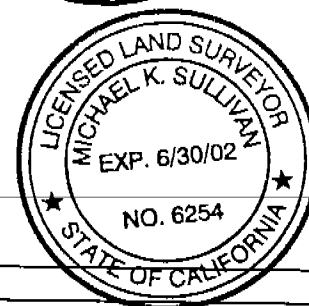

MONUMENT NOTES

- DENOTES FD. S & W STAMPED "LS 4965"
- DENOTES SET L & T W/ TAG "LS 4965 TIE"
- ⊗ DENOTES SET L & T W/ TAG "LS 4965"

