

CORNER RECORD


Document Number 2001- 1455

City of THE UNINCORPORATED TERRITORY

County of ORANGE

, California

Brief Legal Description TRACT NO. 15629, M.M. 787/43-46

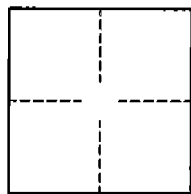

CORNER TYPE

Government corner ☐ Control ☒
 Meander ☐ Property ☐
 Rancho ☐ Other ☐
 Date of Survey SEP. 30, 2001

COORDINATES (OPTIONAL)

N. _____
 E. _____
 Zone _____ NAD27 ☐ NAD83 ☐
 NAD83 Epoch _____
 Elev. _____
 Vert. Datum: ☐ NGVD29 ☐ NAVD88 ☐
 Meas. Units: ☐ Metric ☐ Imperial ☐

Corner- Left as found ☐ Found and tagged ☐ Established ☒ Reestablished ☐ Rebuilt ☐

Identification and type of corner found: Evidence used to identify or procedure used to establish or reestablish the corner:

SEE PAGE 2

A description of the physical condition of the monument as found and as set or reset:

SEE PAGE 2

SURVEYOR'S STATEMENT

This Corner Record was prepared by me or under my direction in conformance with the Land Surveyors' Act on _____

Signed [Signature] P.L.S. or R.C.E. Number 28946

COUNTY SURVEYOR'S STATEMENT

OCT 16 2001


This Corner Record was received _____

and examined and filed November 14th 2001

Signed [Signature] P.L.S. or R.C.E. Number 6803

Title DEPUTY COUNTY SURVEYOR

County Surveyor's Comment _____

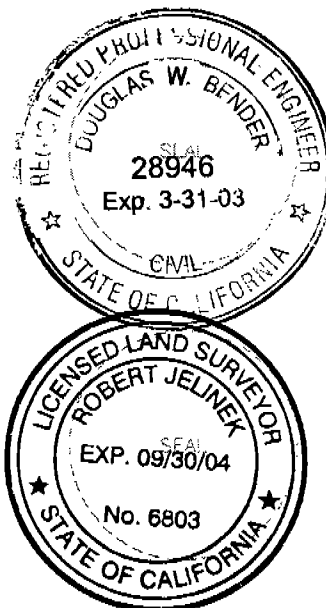

CENTERLINE TIES FOR:
TRACT NO. 15629
IN THE UNINCORPORATED TERRITORY OF THE
COUNTY OF ORANGE, STATE OF CALIFORNIA



SCALE: 1"=40'

960

TRACT BOUNDARY

961

962

SEE CORNER RECORD 2001-1454

☑ BANCROFT STREET

☑ WALDEN STREET

■ ALL TIES ARE LEAD AND TAGS "RCE 28946"
SET IN TOP OF CURB.

▲ ALL CENTERLINE MONUMENTS ARE PUNCHED
SPIKES WITH WASHER STAMPED "RCE 28946",
UNLESS OTHERWISE NOTED.

SEE CORNER RECORD 2001-1452