


CORNER RECORD

Document Number 2001-1454
City of THE UNINCORPORATED TERRITORY County of ORANGE, California
Brief Legal Description TRACT NO. 15629, M.M. 787/43-46

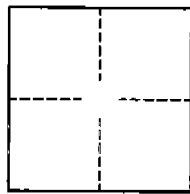

CORNER TYPE

Government corner ☐ Control ☒
Meander ☐ Property ☐
Rancho ☐ Other ☐
Date of Survey SEP. 30, 2001

COORDINATES (OPTIONAL)

N. _____
E. _____
Zone _____ NAD27 ☐ NAD83 ☐
NAD83 Epoch _____
Elev. _____
Vert. Datum: ☐ NGVD29 ☐ NAVD88 ☐
Meas. Units: ☐ Metric ☐ Imperial ☐

Corner— Left as found ☐ Found and tagged ☐ Established ☒ Reestablished ☐ Rebuilt ☐

Identification and type of corner found: Evidence used to identify or procedure used to establish or reestablish the corner:

SEE PAGE 2

A description of the physical condition of the monument as found and as set or reset:

SEE PAGE 2

SURVEYOR'S STATEMENT

This Corner Record was prepared by me or under my direction in conformance with the Land Surveyors' Act on _____

Signed [Signature] P.L.S. or R.C.E. Number 28946

COUNTY SURVEYOR'S STATEMENT


This Corner Record was received OCT 16 2001

and examined and filed November 14th 2001

Signed [Signature] P.L.S. or R.C.E. Number 6803

Title DEPUTY COUNTY SURVEYOR

County Surveyor's Comment _____

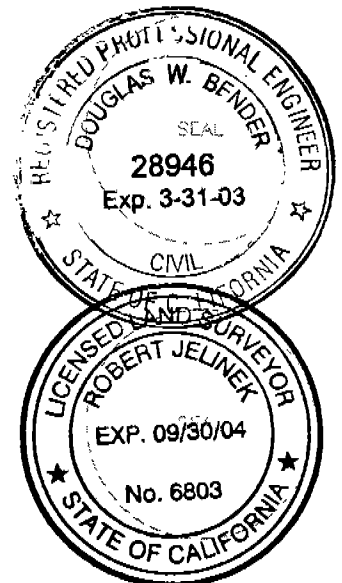

CENTERLINE TIES FOR:
TRACT NO. 15629
IN THE UNINCORPORATED TERRITORY OF THE
COUNTY OF ORANGE, STATE OF CALIFORNIA



1"=40'

TRACT BOUNDARY

971

970

CL BANCROFT STREET

ES ARE LEAD AND TAGS "RCE 28946"
TOP OF CURB.

CENTERLINE MONUMENTS ARE PUNCHED
WITH WASHER STAMPED "RCE 28946".

SEE CORNER RECORD 2001-1455

SEE CORNER RECORD 2001-145

- ALL TIES ARE LEAD AND TAGS "RCE 28946"
SET IN TOP OF CURB.
- ▲ ALL CENTERLINE MONUMENTS ARE PUNCHED
SPIKES WITH WASHER STAMPED "RCE 28946",
UNLESS OTHERWISE NOTED.