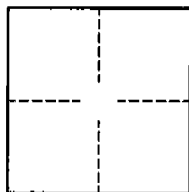


CORNER RECORD

Document Number 2001-1453City of THE UNINCORPORATED TERRITORYCounty of ORANGE

California

Brief Legal Description TRACT NO. 15629, M.M. 787/43-46

CORNER TYPE

Government corner ☐ Control ☒
Meander ☐ Property ☐
Rancho ☐ Other ☐
Date of Survey SEP. 30, 2001

COORDINATES (OPTIONAL)

N. _____
E. _____
Zone _____ NAD27 ☐ NAD83 ☐
NAD83 Epoch _____
Elev. _____
Vert. Datum: ☐ NGVD29 ☐ NAVD88 ☐
Meas. Units: ☐ Metric ☐ Imperial ☐

Corner— Left as found ☐ Found and tagged ☐ Established ☒ Reestablished ☐ Rebuilt ☐

Identification and type of corner found: Evidence used to identify or procedure used to establish or reestablish the corner:

SEE PAGE 2

A description of the physical condition of the monument as found and as set or reset:

SEE PAGE 2

SURVEYOR'S STATEMENT

This Corner Record was prepared by me or under my direction in conformance with the Land Surveyors' Act on _____

Signed [Signature] P.L.S. or R.C.E. Number 28946

COUNTY SURVEYOR'S STATEMENT

OCT 16 2001



This Corner Record was received _____

and examined and filed November 14th 2001

Signed Robert Jelinek P.L.S. or R.C.E. Number 6803

Title DEPUTY COUNTY SURVEYOR


County Surveyor's Comment _____

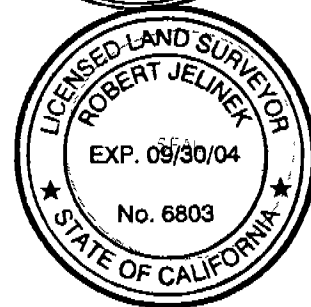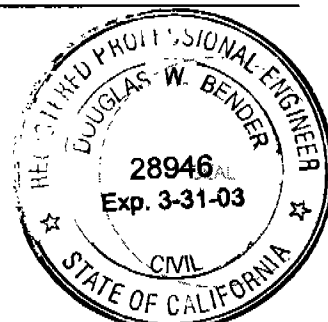

CENTERLINE TIES FOR:
TRACT NO. 15629
 IN THE UNINCORPORATED TERRITORY OF THE
 COUNTY OF ORANGE, STATE OF CALIFORNIA



SCALE: 1"=40'

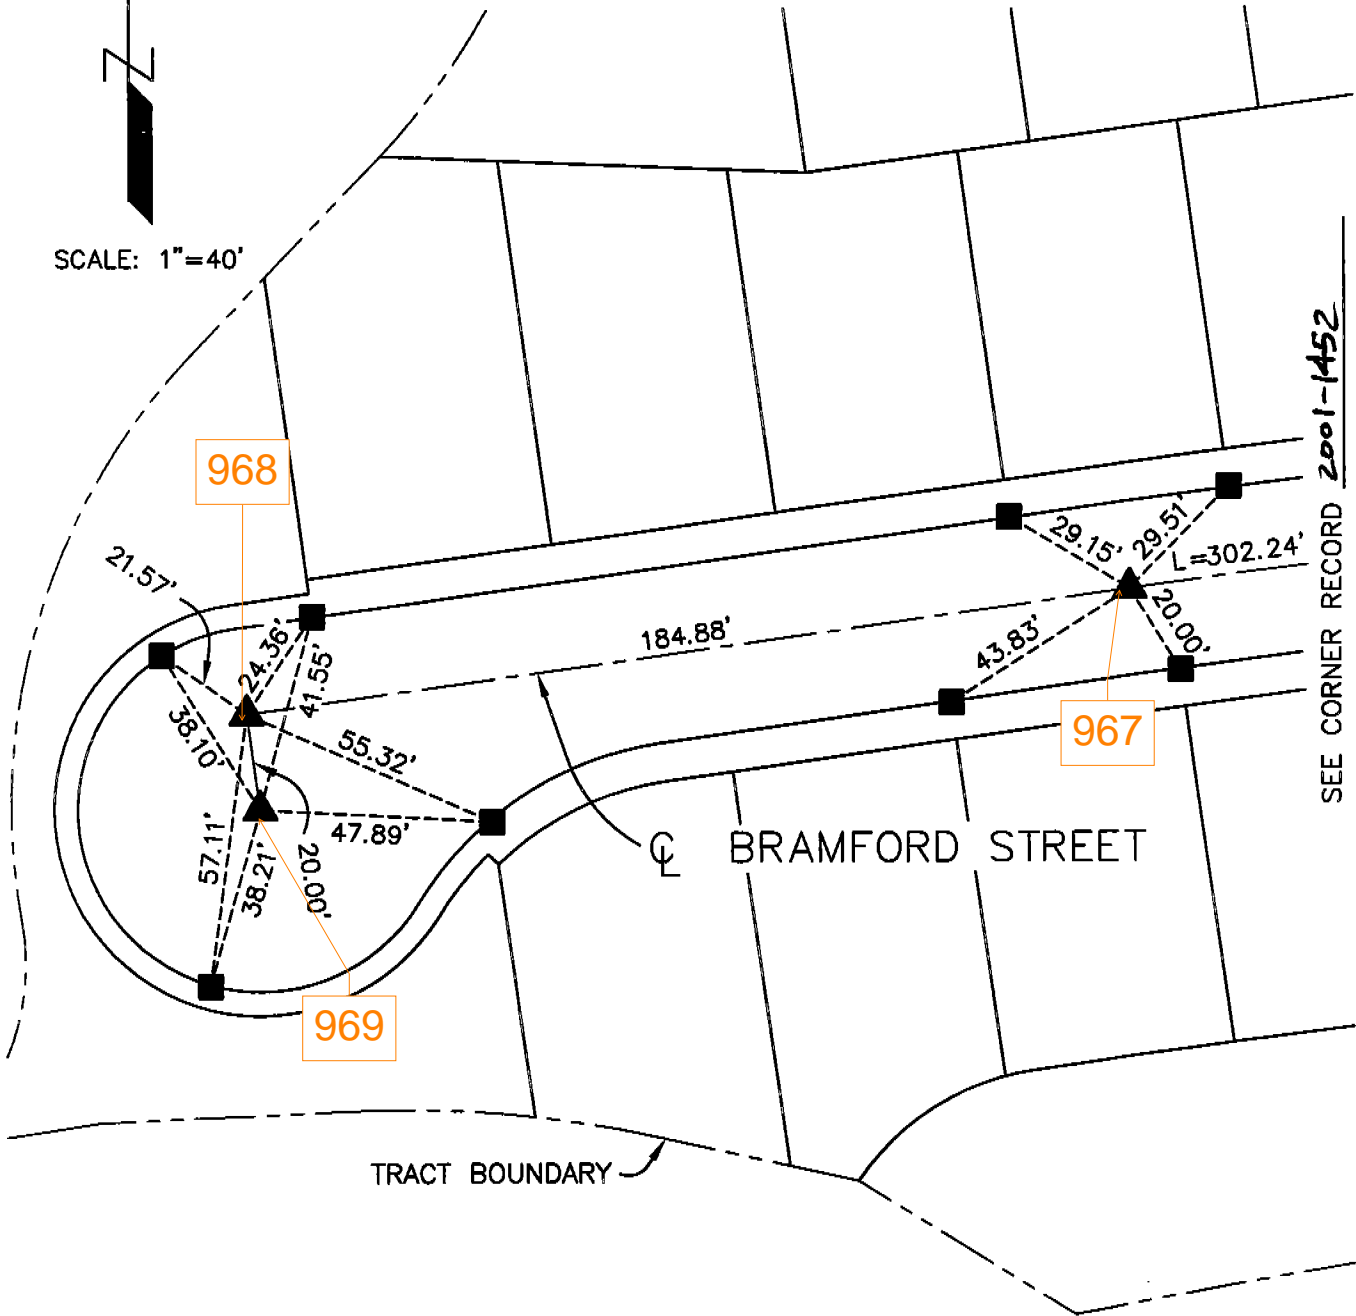

■ ALL TIES ARE LEAD AND TAGS "RCE 28946"
 SET IN TOP OF CURB.

▲ ALL CENTERLINE MONUMENTS ARE PUNCHED
 SPIKES WITH WASHER STAMPED "RCE 28946",
 UNLESS OTHERWISE NOTED.