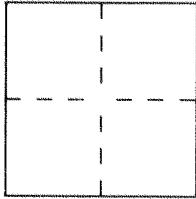


CORNER RECORD

Document Number 2001-378City of UNINCORPORATED TERRITORYCounty of ORANGE, CaliforniaBrief Legal Description C/L TIES FOR TRACT NO. 15618, M.M. 786/44-47

CORNER TYPE

Government Corner ☐ Control ☒
Meander ☐ Property ☐
Rancho ☐ Other ☐
Date of Survey MARCH, 2000

COORDINATES (Optional)

N. _____
E. _____
Zone _____ Datum _____
Elev. _____

Corner — Left as found ☐ Found and tagged ☐ Established ☒ Reestablished ☐ Rebuilt ☐

Identification and type of corner found: Evidence used to identify or procedure used to establish or reestablish the corner:

THE PURPOSE OF THIS CORNER RECORD IS TO PERPETUATE
THE CENTERLINE ON BLAKEMORE DRIVE AND KEMPTON
LANE AS SHOWN ON TRACT NO. 15618, M.M. 786/44-47

A description of the physical condition of the monument as found and as set or reset:

- 1.) SET SPIKE AND WASHER STAMPED "LS5557" FLUSH IN A.C. AS NOTED
- 2.) SET 1" I.P. WITH TAG "LS5557" AS NOTED
- 3.) SET LEAD, TACK AND TAG "LS5557 TIE PT." AS NOTED

SURVEYOR'S STATEMENT

This Corner Record was prepared by me or under my direction in conformance with
the Land Surveyors' Act on DECEMBER 29, 2000

Signed [Signature] L.S. or R.C.E. Number 5557




COUNTY SURVEYOR'S STATEMENT

FEB 13 2001

This Corner Record was received _____ and examined _____

and filed March 29th, 2001

Signed [Signature] Title DEPUTY COUNTY SURVEYOR

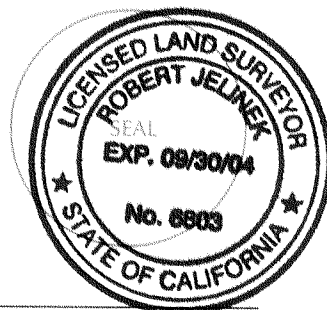

County Surveyor's Comment _____

C/L TIES-TRACT NO. 15618

JAMES F. GILLEN, LS 5557

DATE OF SURVEY

MARCH 2000

PARTY

C. BRUSO

B. SANFORD

▲ INDICATES SET SPIKE AND WASHER
STAMPED "LS 5557"

● INDICATES SET 1" IP TAGGED "LS 5557"

■ INDICATES SET LEAD, TACK & TAG
"LS 5557 TIE PT." IN TOP OF CURB

⊘ INDICATES TANGENT OVER TIES

