
CORNER RECORD	Document Numbe	er 2001- 3	76
City of UNINCORPORATED TERRITORY	County of	PRANGE	, California
Brief Legal Description TRACT NO. 15617,	M.M. 787/	48-50	
CORNER TYF	Control ☑ Property ☐ Other ☐	N E	ORDINATES Optional) Datum
Date of Survey JUNE,	2000	Elev.	
Corner — Left as found	Established 🔎	Reestablished [Rebuilt 🗌
dentification and type of corner found: Evidence used to id THE PURPOSE OF THIS CORNE THE CENTERLINE OF KEMP STREET.	ER RECORD	15 TO PEI	RPETUATE
SET SPIKE AND WASHER S 2.) SET I "I.P. W/TAG " LS 55 3.) SET LEAD, TACK AND TAG " L 4.) SET LEAD, TACK AND TAG " L SURVEYOR'S STATEMENT	57" AS NOT 45 5557" A. 55557 TIE	TED. S NOTED. PT. " AS N	VOTED.
This Corner Record was prepared by me or under my d	irection in conformanc	e with	SUITES F. GILLE
he Land Surveyors' Act on FEBRUARY 5	_ 19 _2001 Number <u>5557</u>		No. 5657 Exp. 9-30-01
COUNTY SURVEYOR'S STATEM FEB 1 3 200	1	,	O LAND S
nd filed Margh, 29th \$200	and exam 7 /		SEAL EXP. 09/30/04
igned by fly fly T	itle DEPUTY COUNTY	#/ cp	No sens
County Surveyor's Comment			OF CALIFORNIA

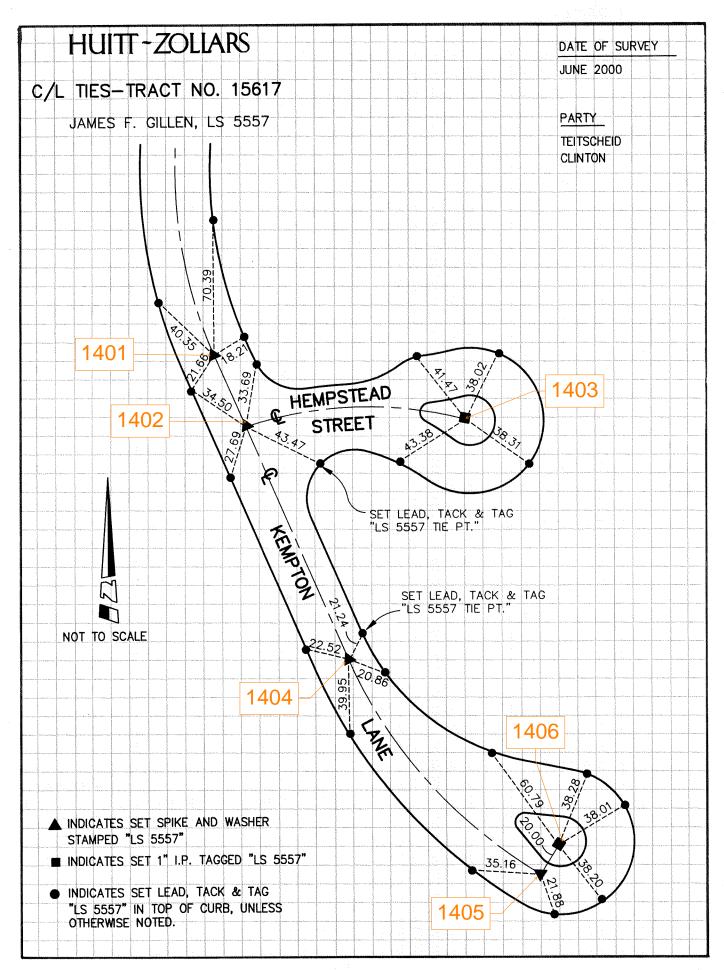

Page 2 of 2