


BLOCK 5157
MODULES 14, 24-29, 35-39, 46-49, 59
CORNER RECORD

Document Number 2001-383

City of UNINCORPORATED TERRITORY County of ORANGE, California

Brief Legal Description TRACT NO. 15615, M.M. 777 / 14-31

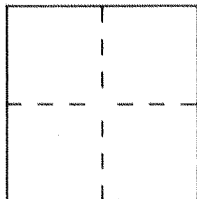

CORNER TYPE

Government Corner ☐ Control ☒
Meander ☐ Property ☐
Rancho ☐ Other ☐
Date of Survey October 2000

COORDINATES
(Optional)

N. _____
E. _____
Zone _____ Datum _____
Elev. _____

Corner — Left as found ☐ Found and tagged ☐ Established ☒ Reestablished ☐ Rebuilt ☐

Identification and type of corner found: Evidence used to identify or procedure used to establish or reestablish the corner:

THE PURPOSE OF THIS CORNER RECORD IS TO PERPETUATE THE
CENTERLINE OF CROWN VALLEY PARKWAY, SIENNA PARK-
WAY, AND KYLE COURT

A description of the physical condition of the monument as found and as set or reset:

- 1.) SET SPIKE AND WASHER STAMPED "LS 5557" AS NOTED.
- 2.) SET 2" I.P. WITH TAG "PLS 5557" AS NOTED
- 3.) SET LEAD, TACK AND TAG "LS 5557 TIE PT." AS NOTED

SURVEYOR'S STATEMENT

This Corner Record was prepared by me or under my direction in conformance with
the Land Surveyors' Act on NOVEMBER 10 2000


Signed [Signature] L.S. or R.C.E. Number 5557



COUNTY SURVEYOR'S STATEMENT

This Corner Record was received FEB 13 2001 and examined
and filed March 30th 2001

Signed [Signature] Title DEPUTY COUNTY SURVEYOR

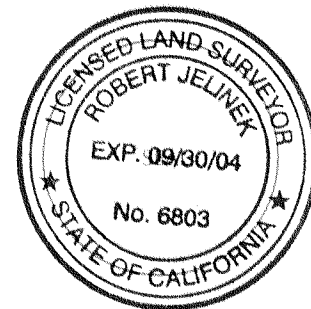

County Surveyor's Comment _____

HUITT-ZOLLARS

C/L TIES-TRACT NO. 15615

JAMES F. GILLEN, LS 5557

DATE OF SURVEY

OCTOBER 2000

PARTY

C. BRUSO

B. SANFORD

NOT TO SCALE

- ▲ INDICATES SET SPIKE AND WASHER STAMPED "LS 5557"
- INDICATES SET 2" IP TAGGED "PLS 5557"
- INDICATES SET LEAD, TACK & TAG "LS 5557 TIE PT" IN TOP OF CURB
- ⊙ INDICATES TANGENT OVER TIES

