


CORNER RECORD

Document Number 2001-928

City of Unincorporated Territory County of Orange, California

Brief Legal Description Tract No. 15630, M.M 785/10-16 (Iron Horse Trail)

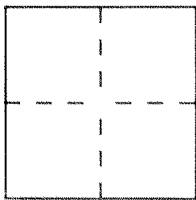

CORNER TYPE

Government Corner ☐ Control ☒
 Meander ☐ Property ☐
 Rancho ☐ Other ☐
 Date of Survey 5/2001

COORDINATES (Optional)

N. _____
 E. _____
 Zone _____ Datum _____
 Elev. _____

Corner — Left as found ☐ Found and tagged ☐ Established ☒ Reestablished ☐ Rebuilt ☐

Identification and type of corner found: Evidence used to identify or procedure used to establish or reestablish the corner:

A description of the physical condition of the monument as found and as set or reset: _____


See Sketch - Sheet 2

SURVEYOR'S STATEMENT

This Corner Record was prepared by me or under my direction in conformance with

the Land Surveyors' Act on April 19, 2001

Signed Robert N. Mack L.S. or R.C.E. Number 5314

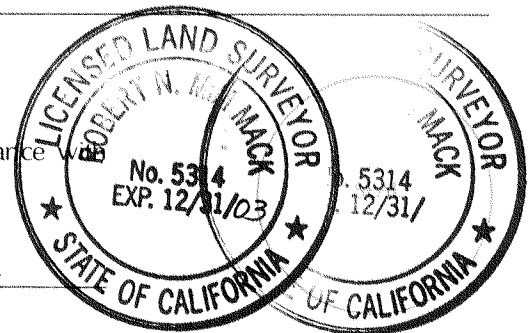


COUNTY SURVEYOR'S STATEMENT

This Corner Record was received MAY 11 2001 and examined

and filed June 5th 2001

Signed Robert Jelinek Title DEPUTY COUNTY SURVEYOR

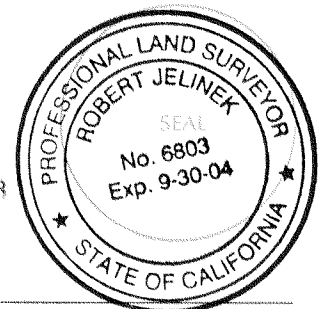

County Surveyor's Comment _____

LEGEND:

- INDICATES SET SPIKE AND WASHER STAMPED L.S. 5314
- INDICATES SET LEAD AND TAG STAMPED L.S. 5314
- ⊙ INDICATES TANGENT OVER

TRACT NO. 15630
M.M. 785/10-16

SCALE: 1" = 20'

1436

ASH HOLLOW
TRAIL

1435

IRON HORSE TRAIL

1437

$P=180.00'$
 $L=248.63'$
 $L=101.92'$
 $L=34.35'$

N 14°03'58" E

36'
54'

96.87'

2.00'

⊙ 40.47'
38.92'

⊙ 40.56'
40.19'

27.38'

29.68'

23.85'







