


CORNER RECORD

Document Number 2001- 927

City of Unincorporated Territory County of Orange, California

Brief Legal Description Tract No. 15630, M.M. 785/10-16 (Half moon Trail)

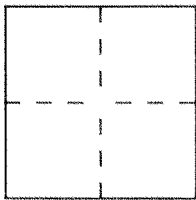

CORNER TYPE

Government Corner ☐ Control ☒
Meander ☐ Property ☐
Rancho ☐ Other ☐
Date of Survey 5/2001

COORDINATES (Optional)

N. _____
E. _____
Zone _____ Datum _____
Elev. _____

Corner — Left as found ☐ Found and tagged ☐ Established ☒ Reestablished ☐ Rebuilt ☐

Identification and type of corner found: Evidence used to identify or procedure used to establish or reestablish the corner:

A description of the physical condition of the monument as found and as set or reset: _____

See Sketch - Sheet 2

SURVEYOR'S STATEMENT

This Corner Record was prepared by me or under my direction in conformance with the Land Surveyors' Act on April 19, XX 2001

Signed Robert N. Min Mack L.S. or R.C.E. Number 5314




COUNTY SURVEYOR'S STATEMENT MAY 11 2001

This Corner Record was received _____ and examined

and filed June 5th, 2001

Signed Robert Jelinek Title DEPUTY COUNTY SURVEYOR

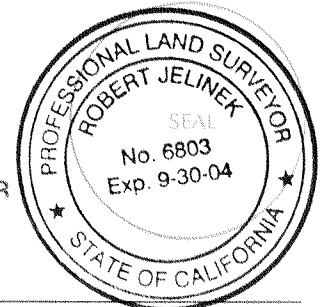

County Surveyor's Comment _____

