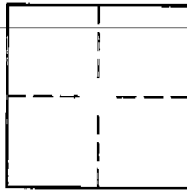


CORNER RECORD

Document Number 2002-536City of UNINCORPORATED TERRITORYCounty of ORANGE, CaliforniaBrief Legal Description TRACT 15622, M.M. 784/47-50

CORNER TYPE

Government corner ☐ Control ☐
Meander ☐ Property ☐
Rancho ☐ Other ☒
Date of Survey SEP. 2001

COORDINATES (OPTIONAL)

N. _____
E. _____
Zone _____ NAD27 ☐ NAD83 ☐
NAD83 Epoch _____
Elev. _____
Vert. Datum: ☐ NGVD29 ☐ NAVD88 ☐
Meas. Units: ☐ Metric ☐ Imperial ☐

Corner— Left as found ☐ Found and tagged ☐ Established ☒ Reestablished ☐ Rebuilt ☐


Identification and type of corner found: Evidence used to identify or procedure used to establish or reestablish the corner:

SEE PAGE 2

A description of the physical condition of the monument as found and as set or reset:

SEE PAGE 2

SURVEYOR'S STATEMENT

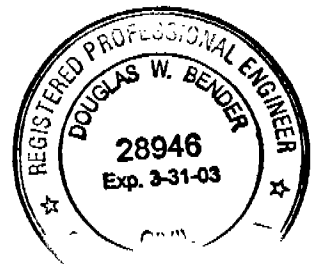This Corner Record was prepared by me or under my direction in conformance with
the Land Surveyors' Act on 3/22/02Signed [Signature] P.T.S. or R.C.E. Number 28946

COUNTY SURVEYOR'S STATEMENT

This Corner Record was received APR 11 2002
and examined and filed MAY 15 2002Signed [Signature] or R.C.E. Number 6254
DEPUTY COUNTY SURVEYOR

Title _____

County Surveyor's Comment _____



CENTERLINE TIES FOR:
TRACT NO. 15622
 IN THE UNINCORPORATED TERRITORY OF THE
 COUNTY OF ORANGE, STATE OF CALIFORNIA



SCALE: 1"=40'

