




CENTERLINE TIES FOR:  
**TRACT NO. 15622**  
 IN THE UNINCORPORATED TERRITORY OF THE  
 COUNTY OF ORANGE, STATE OF CALIFORNIA

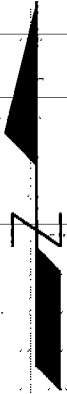

SCALE: 1"=40'

1" IRON PIPE TAGGED  
 R.C.E. 28946

1467

LAURELHURST DRIVE

1466

SEE CORNER RECORD 2002-534

■ ALL TIES ARE LEAD AND TAGS "RCE 28946"  
 SET IN TOP OF CURB.

▲ ALL CENTERLINE MONUMENTS ARE PUNCHED  
 SPIKES WITH WASHER STAMPED "RCE 28946",  
 UNLESS OTHERWISE NOTED.