

BLOCK 5157 MODULES 25, 26
CORNER RECORD


WM 44E

Document Number 2000 - 186

City of UNINCORPORATED TERRITORY

County of _____, California

Brief Legal Description SET C/L MON. WITH C/L TIES FOR TRACT NO. 15621, M.M. 781/14-16

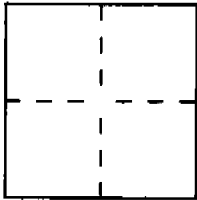

CORNER TYPE

Government Corner ☐ Control ☒
Meander ☐ Property ☐
Rancho ☐ Other ☐
Date of Survey 2/2000

COORDINATES
(Optional)

N. _____
E. _____
Zone _____ Datum _____
Elev. _____

Corner — Left as found ☐ Found and tagged ☐ Established ☒ Reestablished ☐ Rebuilt ☐

Identification and type of corner found: Evidence used to identify or procedure used to establish or reestablish the corner:

THE PURPOSE OF THIS CORNER RECORD IS TO PERPETUATE
THE CENTERLINE OF LAURELHURST DRIVE AS SHOWN ON
TRACT NO. 15621, M.M. 781/14-16.

A description of the physical condition of the monument as found and as set or reset:

- 1.) SET SPIKE AND WASHER STAMPED "LS5557" FLUSH IN AC.
 - 2.) SET LEAD, TACK AND TAG "LS5557 TIE PT."
 - 3.) SET 1" I.P. WITH TAG "LS5557"
- ALL AS MORE COMPLETELY SET FORTH ON PG. 2 OF 2.

SURVEYOR'S STATEMENT

This Corner Record was prepared by me or under my direction in conformance with
the Land Surveyors' Act on MARCH 23 2000

Signed [Signature] L.S. or R.C.E. Number 5557



COUNTY SURVEYOR'S STATEMENT

This Corner Record was received 4-13- 2000 and examined

and filed April 26th 2000

Signed [Signature] Title DEPUTY COUNTY SURVEYOR



County Surveyor's Comment _____

HUITT-ZOLIARS

C/L TIES-TRACT NO. 15621


JAMES F. GILLEN, LS 5557

DATE OF SURVEY

FEB 2000

PARTY

J. JOHNS
ENGISO
FLORES

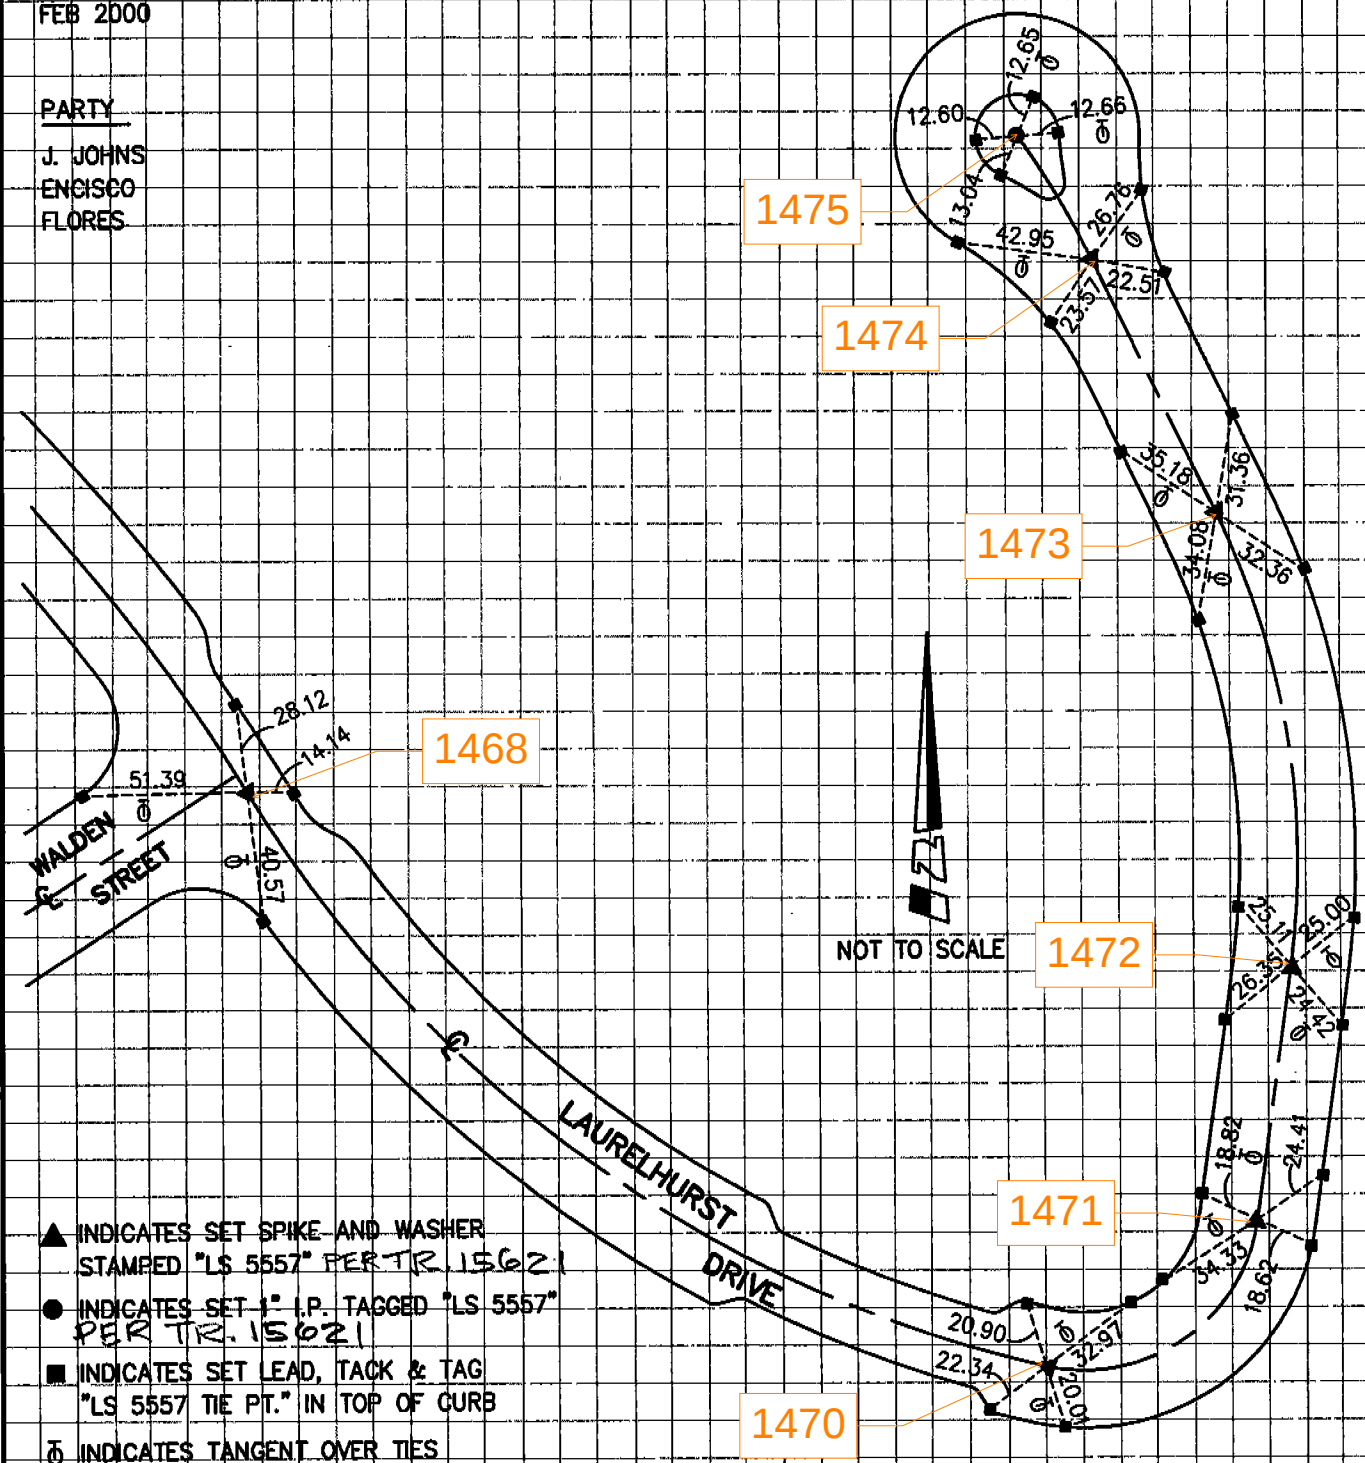

- ▲ INDICATES SET SPIKE AND WASHER
STAMPED "LS 5557" PER TR. 15621
- INDICATES SET 1" I.P. TAGGED "LS 5557"
PER TR. 15621
- INDICATES SET LEAD, TACK & TAG
"LS 5557 TIE PT." IN TOP OF CURB
- ⊙ INDICATES TANGENT OVER TIES