


**U.S.** *Survey  
Foot*

OC Public Works  
OC Survey/Field Services  
Boundary Analysis & Mapping



## I02 LAGUNA CANYON CHANNEL CL

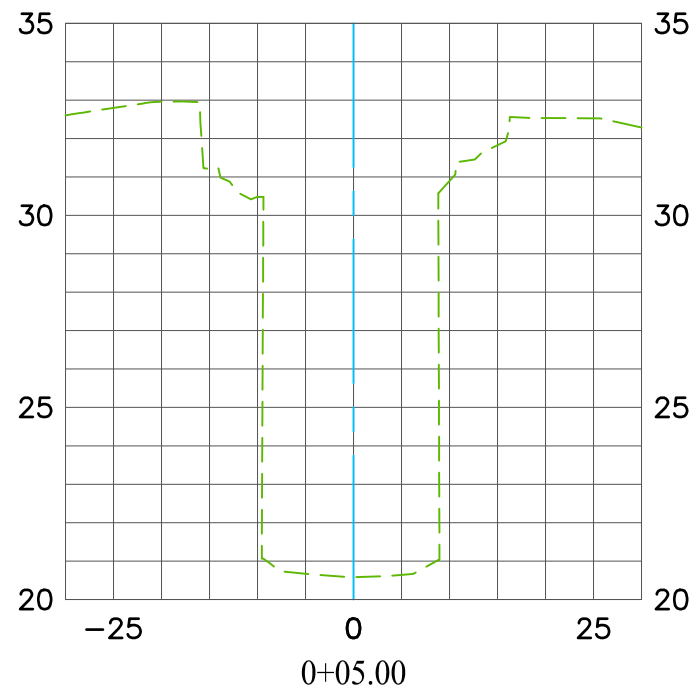

EXISTING CONDITION 2019


DATE PREPARED: 08/08/2019

-----

Vert. Scale: 1"=5'  
Hor. Scale: 1"=20'



## I02 LAGUNA CANYON CHANNEL CL

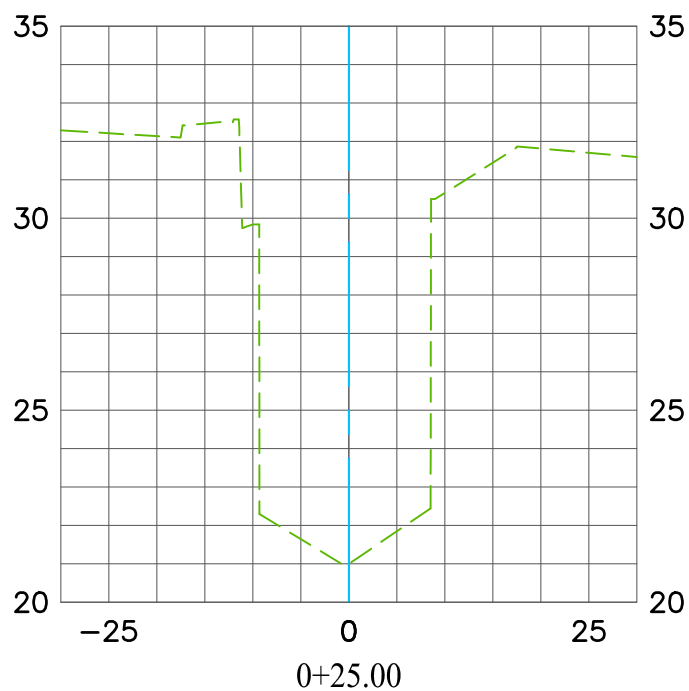


EXISTING CONDITION 2019

DATE PREPARED: 08/08/2019

Vert. Scale: 1"=5'  
Hor. Scale: 1"=20'



## I02 LAGUNA CANYON CHANNEL CL

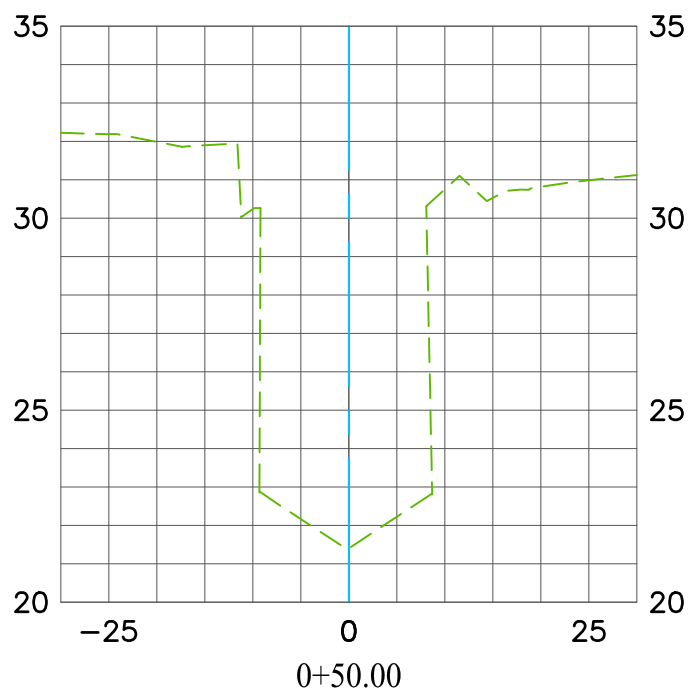

EXISTING CONDITION 2019


DATE PREPARED: 08/08/2019

-----

Vert. Scale: 1"=5'  
Hor. Scale: 1"=20'



## I02 LAGUNA CANYON CHANNEL CL

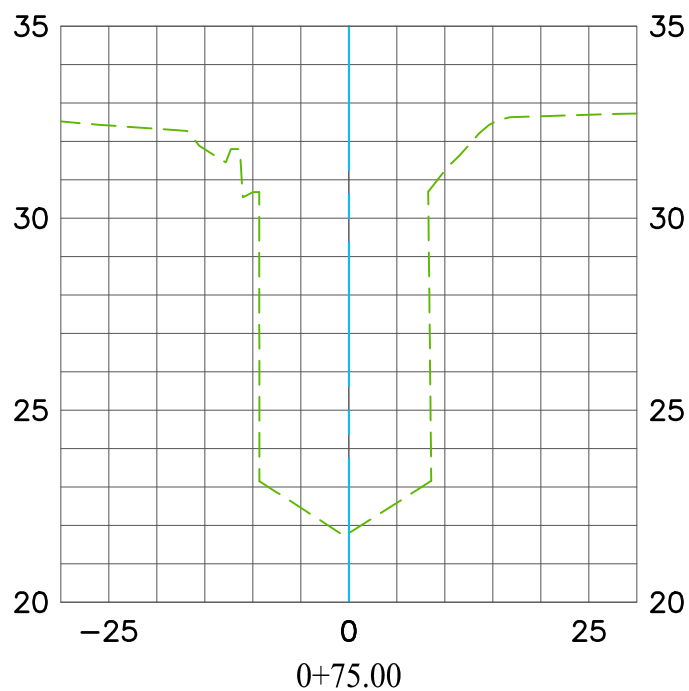

EXISTING CONDITION 2019

DATE PREPARED: 08/08/2019


Vert. Scale: 1"=5'  
Hor. Scale: 1"=20'

**U.S.** *Survey  
Foot*

OC Public Works  
OC Survey/Field Services  
Boundary Analysis & Mapping



## I02 LAGUNA CANYON CHANNEL CL

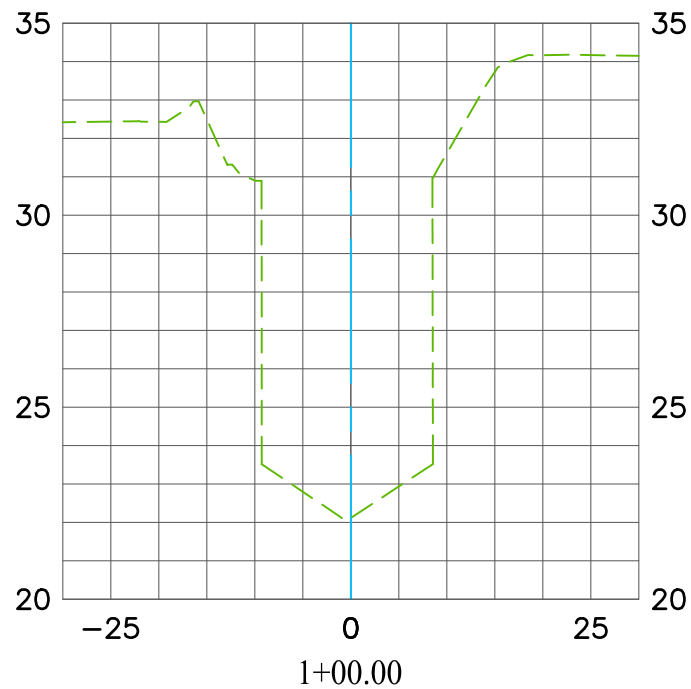


EXISTING CONDITION 2019


DATE PREPARED: 08/08/2019

-----

Vert. Scale: 1"=5'  
Hor. Scale: 1"=20'

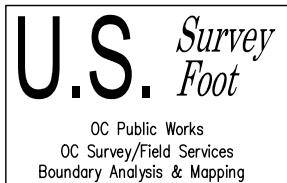

# I02 LAGUNA CANYON CHANNEL CL

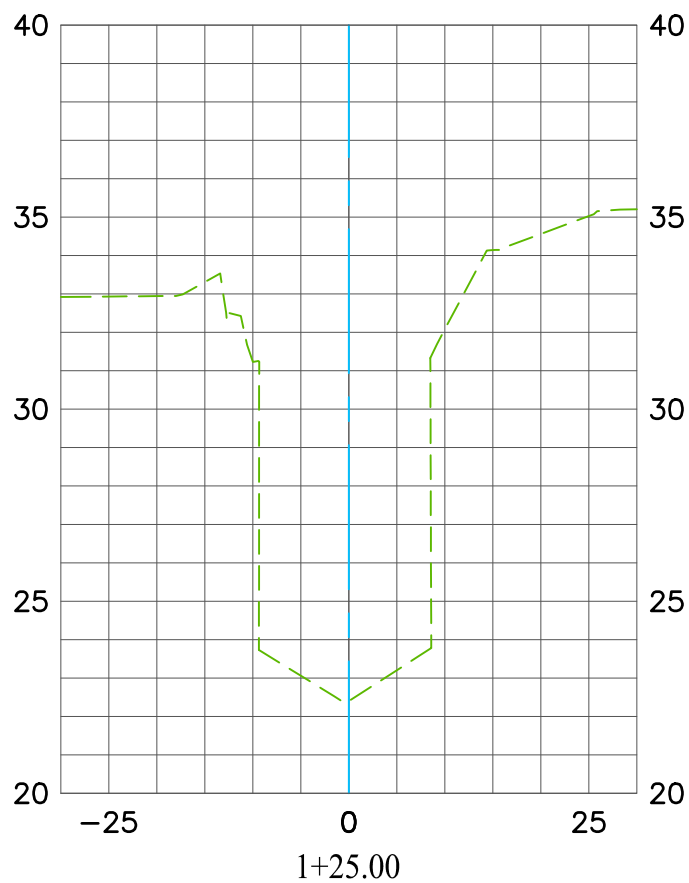


EXISTING CONDITION 2019

DATE PREPARED: 08/08/2019

Vert. Scale: 1"=5'  
Hor. Scale: 1"=20'



## I02 LAGUNA CANYON CHANNEL CL

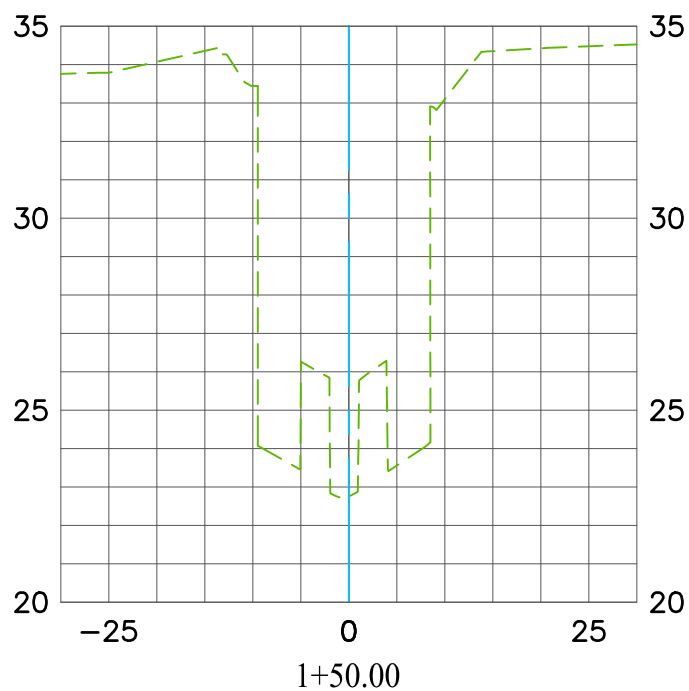

EXISTING CONDITION 2019


DATE PREPARED: 08/08/2019

-----

Vert. Scale: 1"=5'  
Hor. Scale: 1"=20'



## I02 LAGUNA CANYON CHANNEL CL

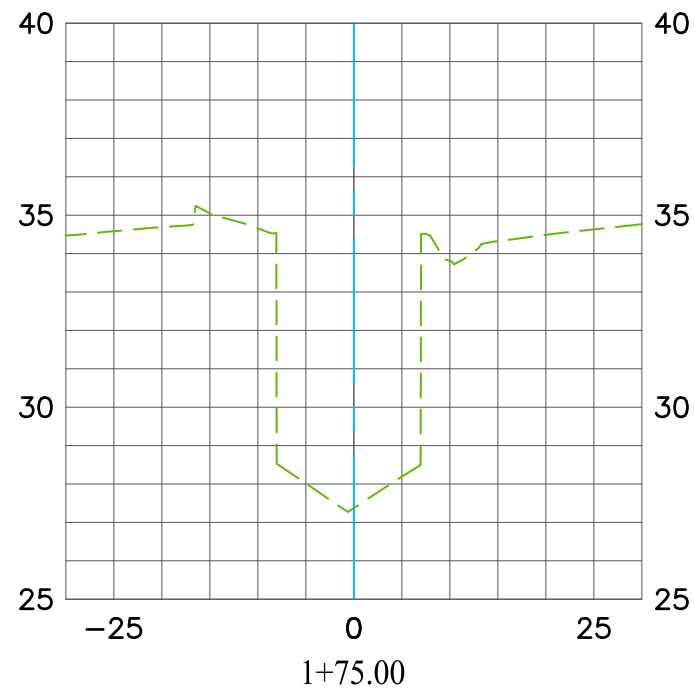

EXISTING CONDITION 2019


DATE PREPARED: 08/08/2019

-----

Vert. Scale: 1"=5'  
Hor. Scale: 1"=20'



## I02 LAGUNA CANYON CHANNEL CL

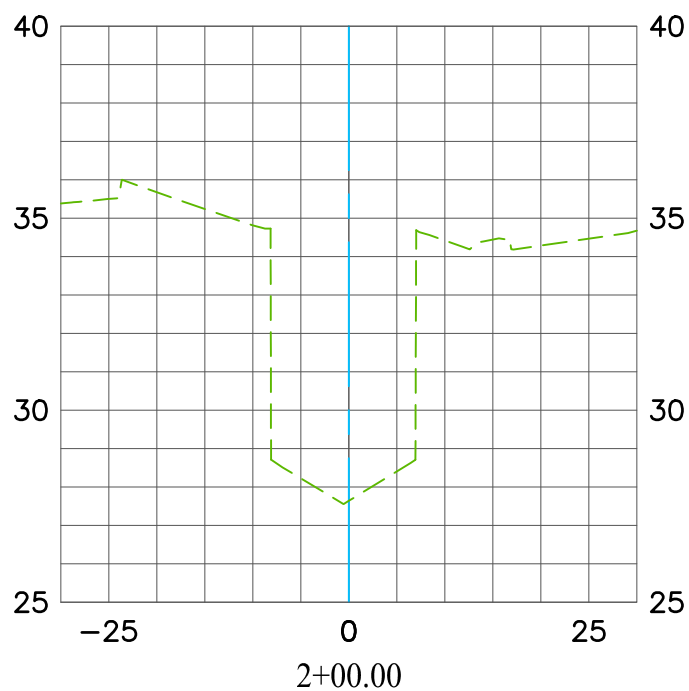

EXISTING CONDITION 2019

DATE PREPARED: 08/08/2019

-----

Vert. Scale: 1"=5'  
Hor. Scale: 1"=20'