

OC PUBLIC WORKS DEPARTMENT

SHANE SILSBY, DIRECTOR

KEVIN HILLS, COUNTY SURVEYOR

LAGUNA CANYON CHANNEL (C02)


SEGMENT I



THE CONSTRUCTION ALIGNMENT FOR SECTIONS SHOWN HEREIN WAS ESTABLISHED BY HOLDING 10+00 AT THE INTERSECTION OF THE EXISTING CONCRETE FLOWLINE OF THE CHANNEL AND THE S'WLY FACE OF THE MOST S'WLY BRIDGE WALL.

PROJECT CROSS SECTIONS

I02 LAGUNA CANYON CHANNEL CL

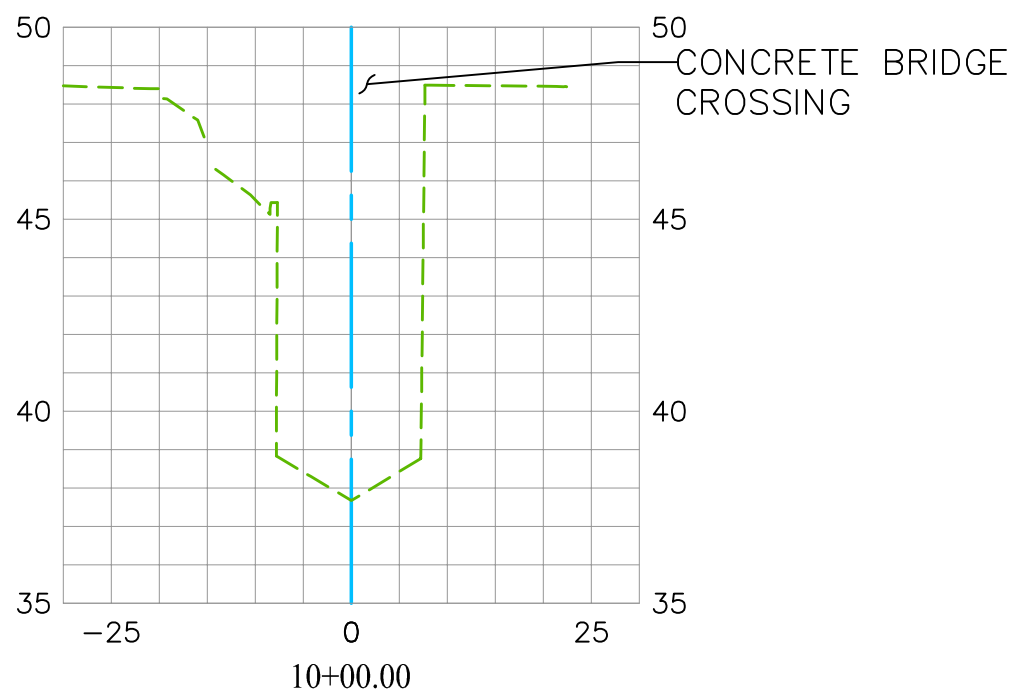


EXISTING CONDITION 2019

DATE PREPARED: 11/26/2019

Vert. Scale: 1"=5'
Hor. Scale: 1"=20'

I02 LAGUNA CANYON CHANNEL CL

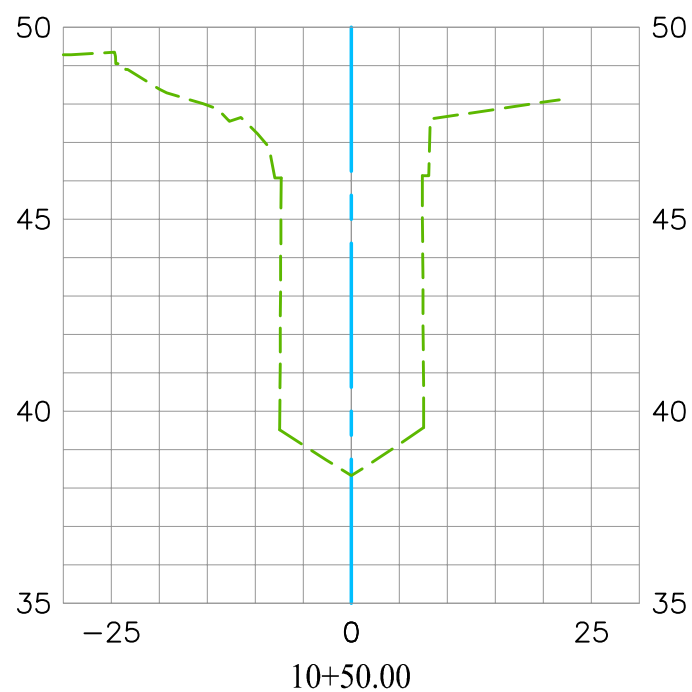


EXISTING CONDITION 2019

DATE PREPARED: 11/26/2019

Vert. Scale: 1"=5'
Hor. Scale: 1"=20'


I02 LAGUNA CANYON CHANNEL CL

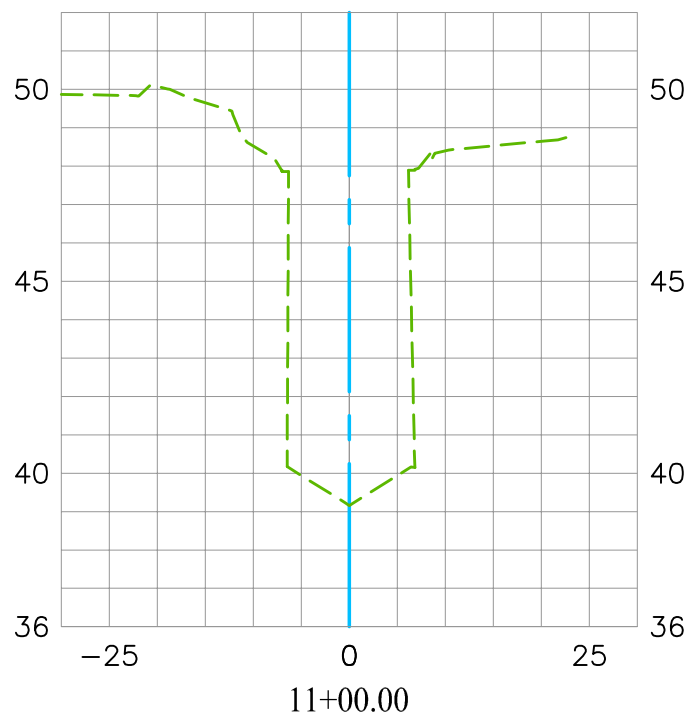


EXISTING CONDITION 2019

DATE PREPARED: 11/26/2019

Vert. Scale: 1"=5'
Hor. Scale: 1"=20'

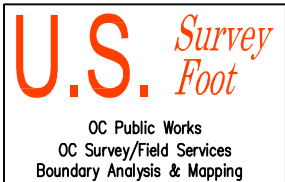

I02 LAGUNA CANYON CHANNEL CL

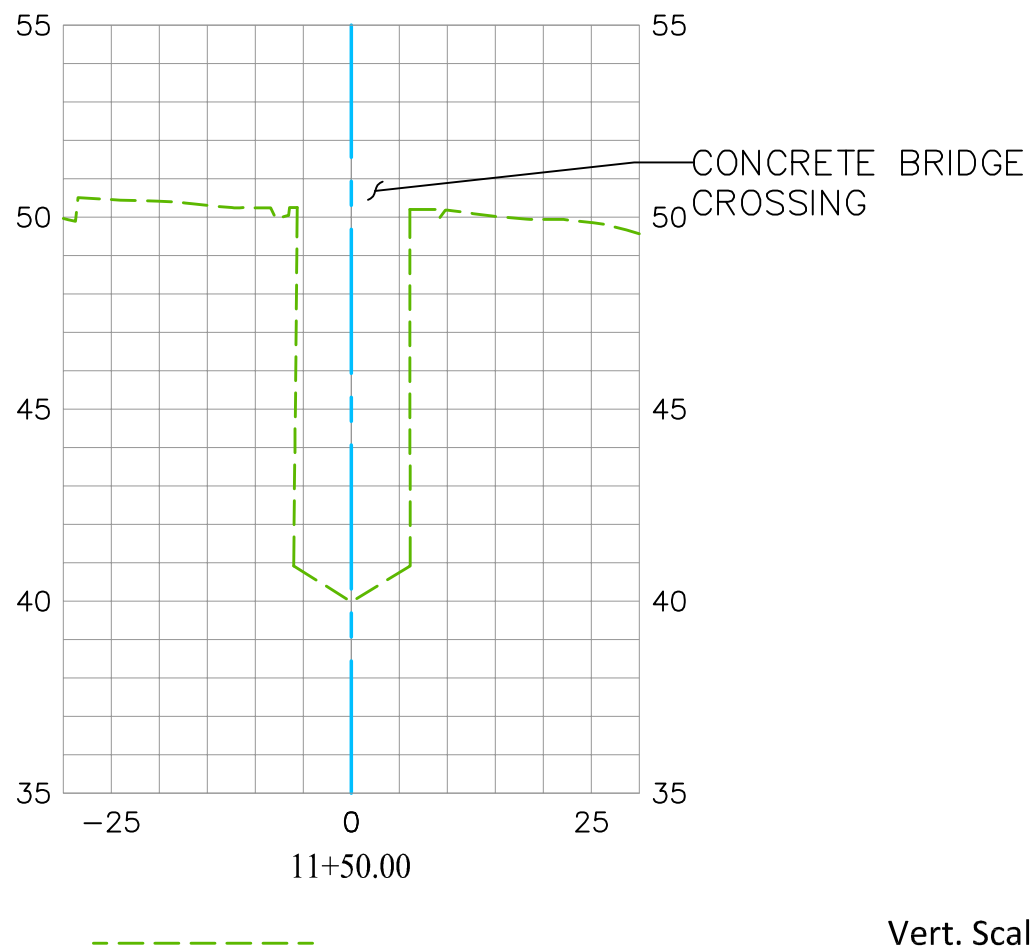


EXISTING CONDITION 2019

DATE PREPARED: 11/26/2019

Vert. Scale: 1"=5'
Hor. Scale: 1"=20'

I02 LAGUNA CANYON CHANNEL CL

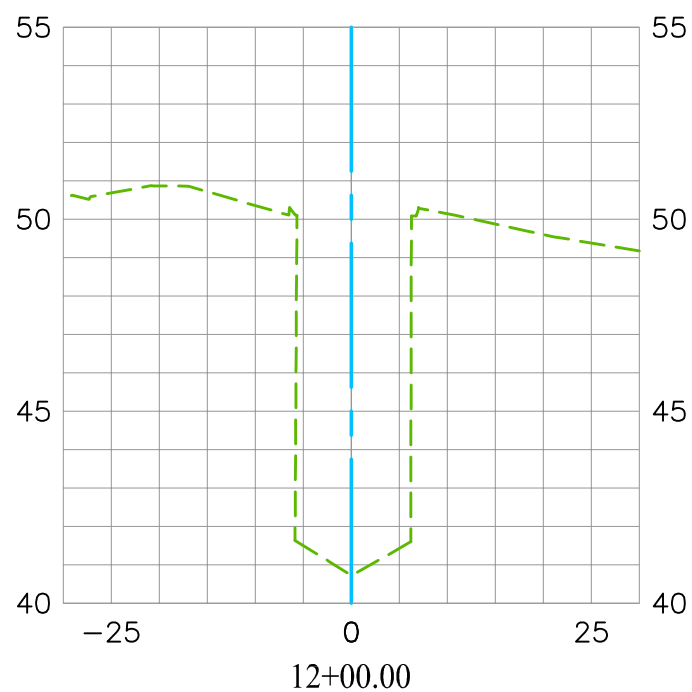


EXISTING CONDITION 2019

DATE PREPARED: 11/26/2019

Vert. Scale: 1"=5'
Hor. Scale: 1"=20'

I02 LAGUNA CANYON CHANNEL CL

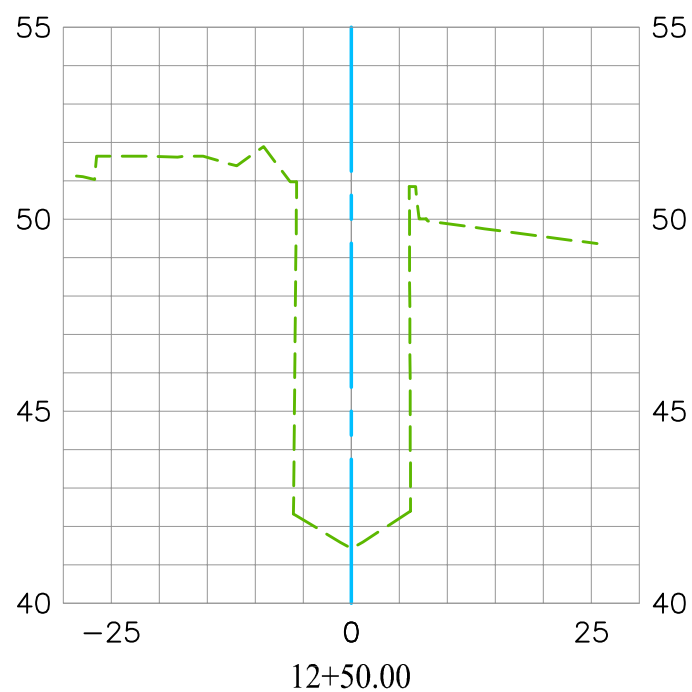


EXISTING CONDITION 2019

DATE PREPARED: 11/26/2019

Vert. Scale: 1"=5'
Hor. Scale: 1"=20'

I02 LAGUNA CANYON CHANNEL CL

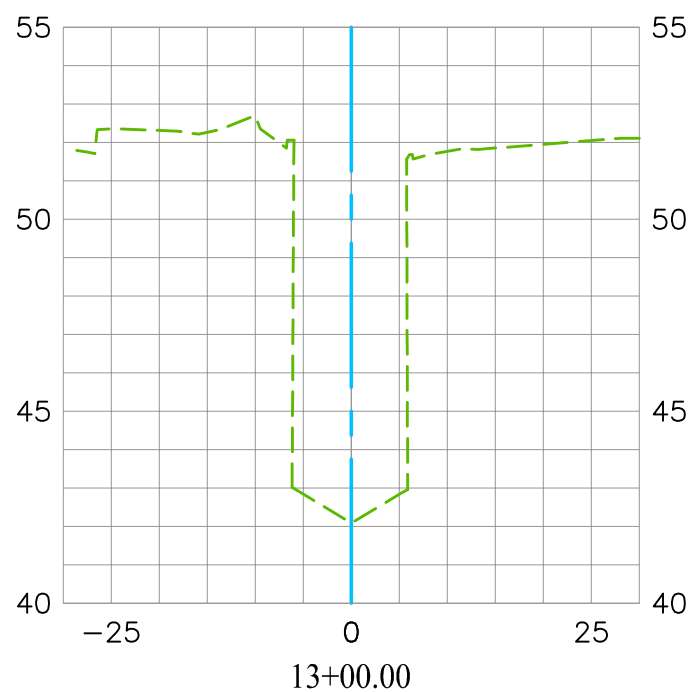


EXISTING CONDITION 2019

DATE PREPARED: 11/26/2019

Vert. Scale: 1"=5'
Hor. Scale: 1"=20'

I02 LAGUNA CANYON CHANNEL CL

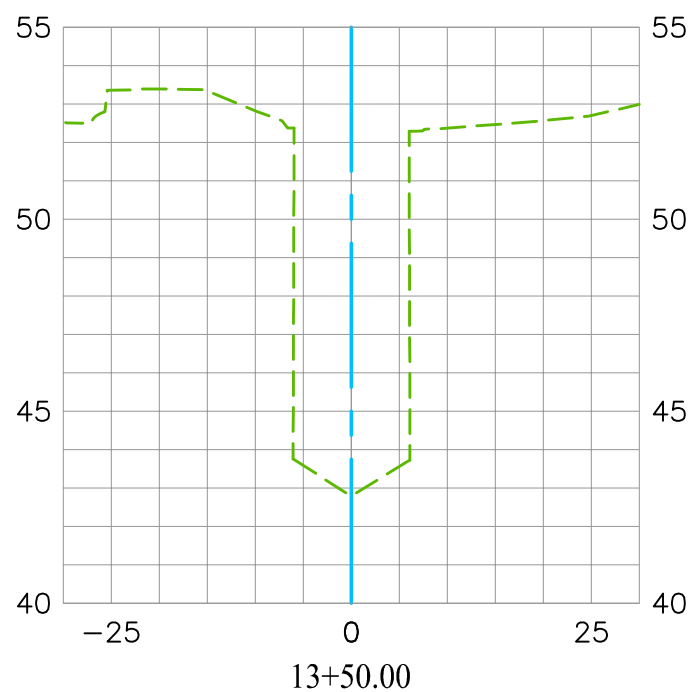


EXISTING CONDITION 2019

DATE PREPARED: 11/26/2019

Vert. Scale: 1"=5'
Hor. Scale: 1"=20'

I02 LAGUNA CANYON CHANNEL CL

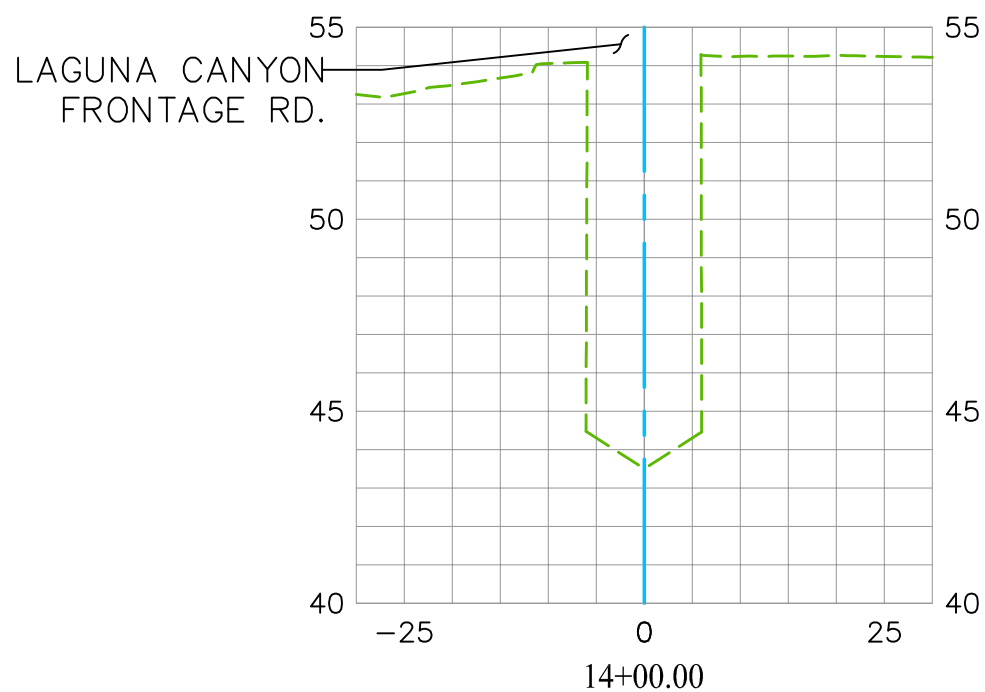


EXISTING CONDITION 2019

DATE PREPARED: 11/26/2019

Vert. Scale: 1"=5'
Hor. Scale: 1"=20'


I02 LAGUNA CANYON CHANNEL CL

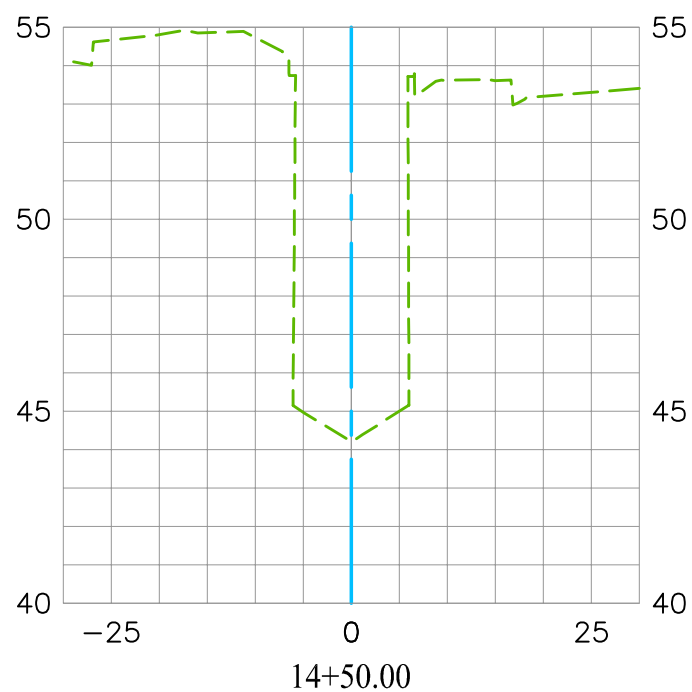

EXISTING CONDITION 2019

DATE PREPARED: 11/26/2019

Vert. Scale: 1"=5'
Hor. Scale: 1"=20'

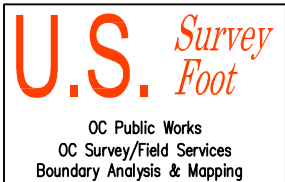

I02 LAGUNA CANYON CHANNEL CL




EXISTING CONDITION 2019

DATE PREPARED: 11/26/2019

Vert. Scale: 1"=5'
Hor. Scale: 1"=20'

I02 LAGUNA CANYON CHANNEL CL

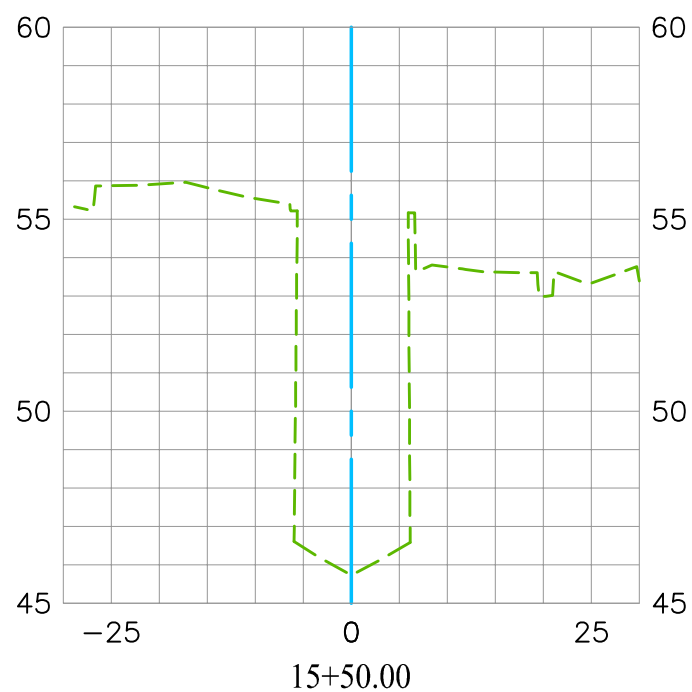


EXISTING CONDITION 2019

DATE PREPARED: 11/26/2019

Vert. Scale: 1"=5'
Hor. Scale: 1"=20'

I02 LAGUNA CANYON CHANNEL CL

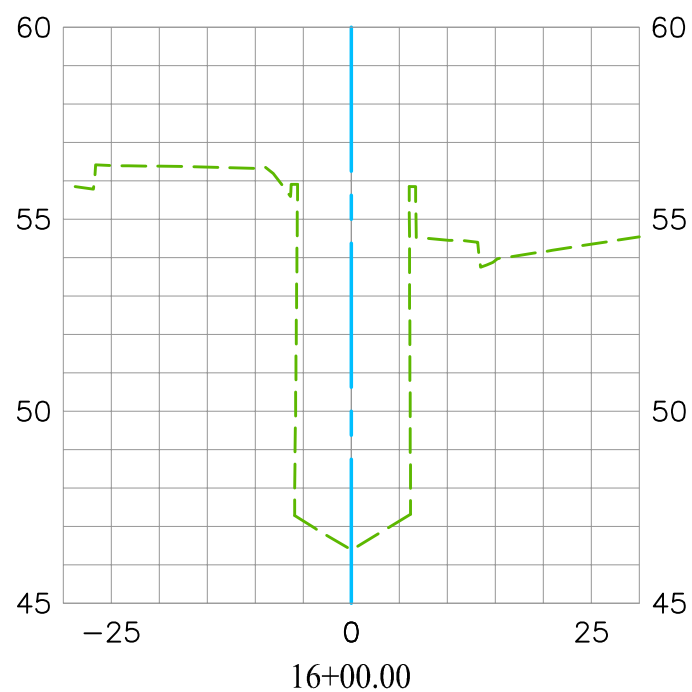


EXISTING CONDITION 2019

DATE PREPARED: 11/26/2019

Vert. Scale: 1"=5'
Hor. Scale: 1"=20'

I02 LAGUNA CANYON CHANNEL CL

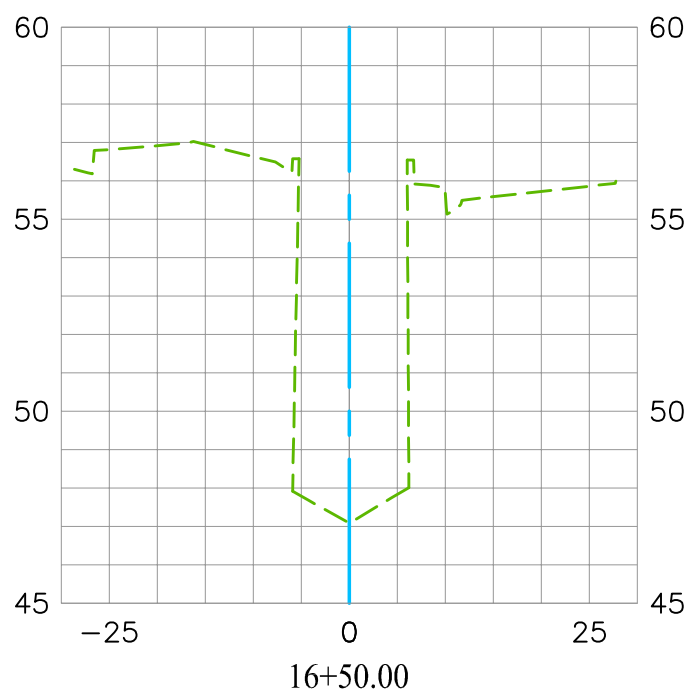


EXISTING CONDITION 2019

DATE PREPARED: 11/26/2019

Vert. Scale: 1"=5'
Hor. Scale: 1"=20'

I02 LAGUNA CANYON CHANNEL CL

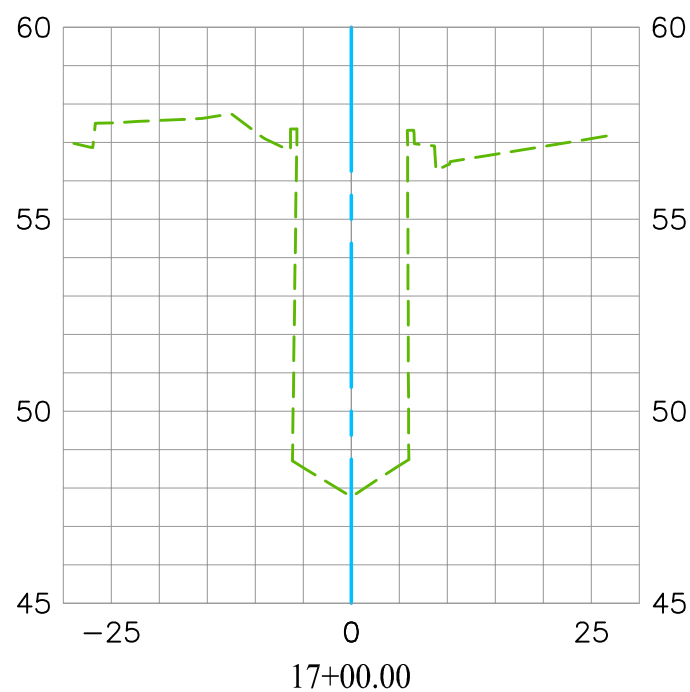


EXISTING CONDITION 2019

DATE PREPARED: 11/26/2019

Vert. Scale: 1"=5'
Hor. Scale: 1"=20'

I02 LAGUNA CANYON CHANNEL CL

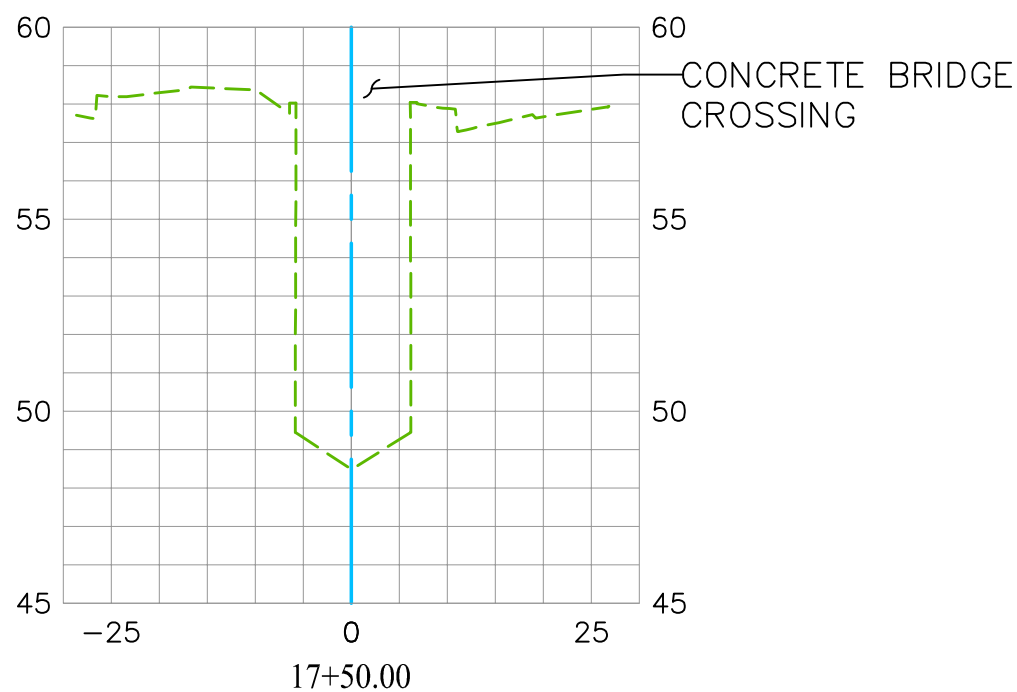


EXISTING CONDITION 2019

DATE PREPARED: 11/26/2019

Vert. Scale: 1"=5'
Hor. Scale: 1"=20'


I02 LAGUNA CANYON CHANNEL CL

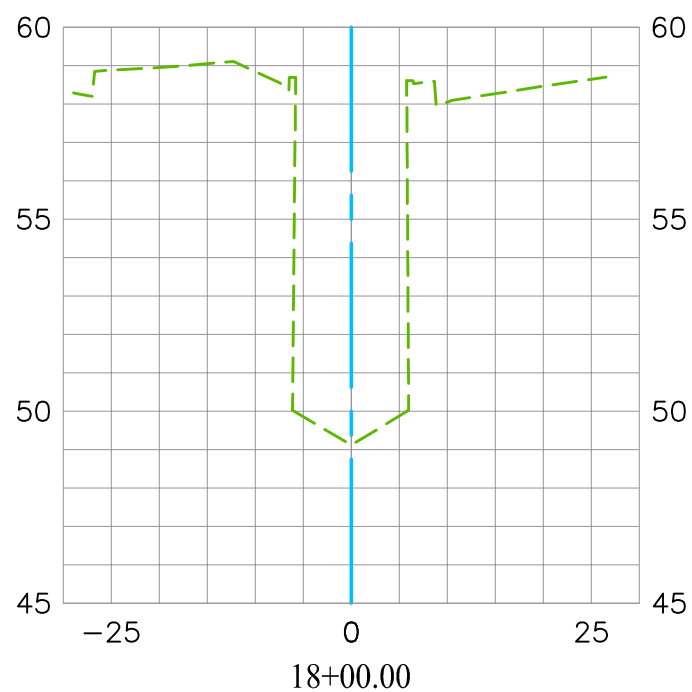


EXISTING CONDITION 2019

DATE PREPARED: 11/26/2019

Vert. Scale: 1"=5'
Hor. Scale: 1"=20'

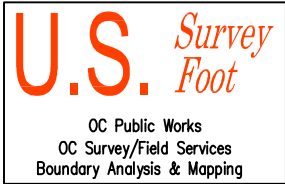

I02 LAGUNA CANYON CHANNEL CL

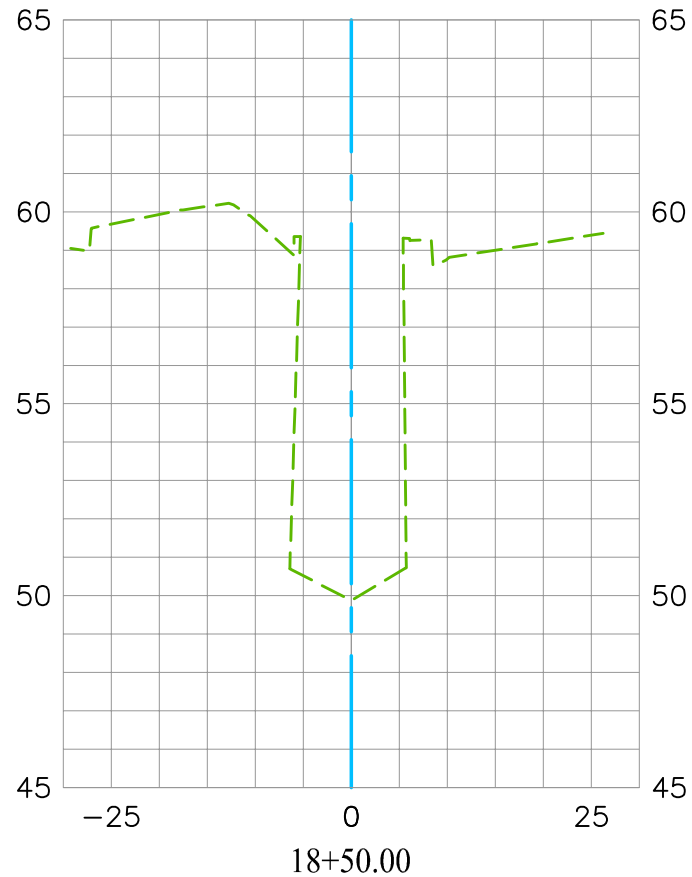


EXISTING CONDITION 2019

DATE PREPARED: 11/26/2019

Vert. Scale: 1"=5'
Hor. Scale: 1"=20'

I02 LAGUNA CANYON CHANNEL CL

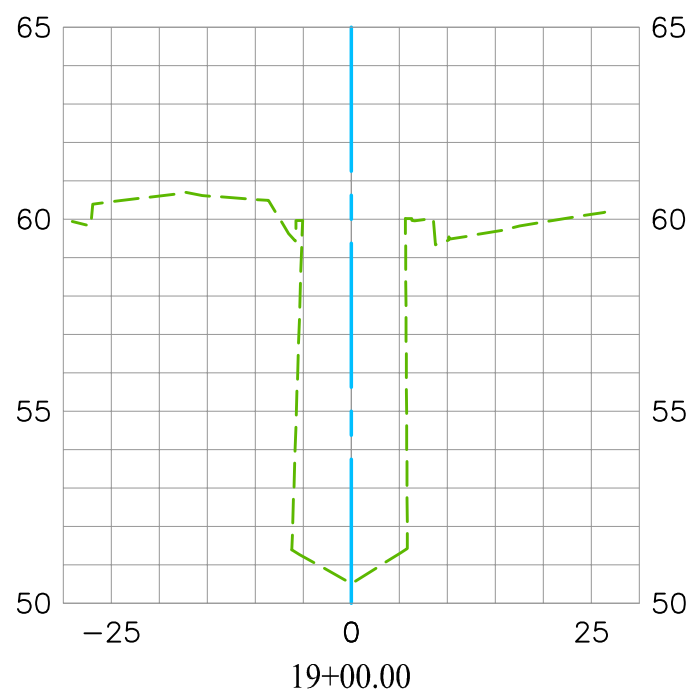


EXISTING CONDITION 2019

DATE PREPARED: 11/26/2019

Vert. Scale: 1"=5'
Hor. Scale: 1"=20'

I02 LAGUNA CANYON CHANNEL CL

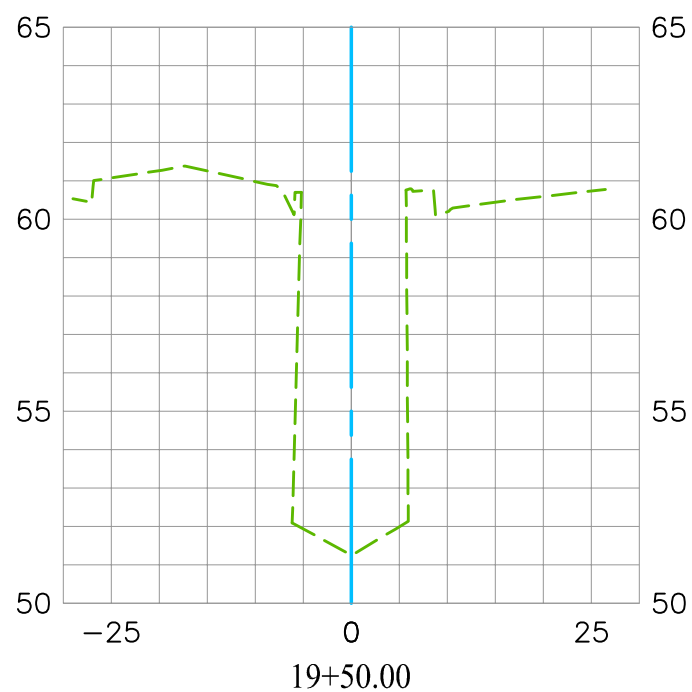


EXISTING CONDITION 2019

DATE PREPARED: 11/26/2019

Vert. Scale: 1"=5'
Hor. Scale: 1"=20'

I02 LAGUNA CANYON CHANNEL CL

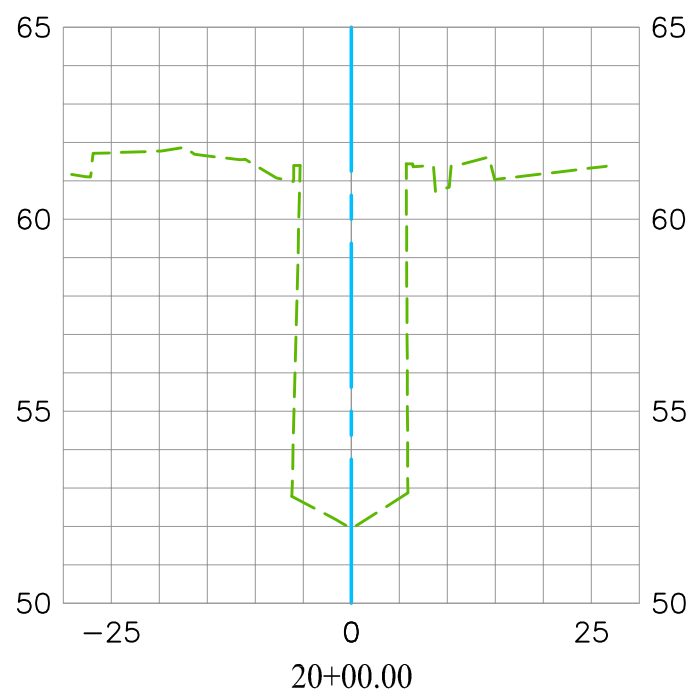


EXISTING CONDITION 2019

DATE PREPARED: 11/26/2019

Vert. Scale: 1"=5'
Hor. Scale: 1"=20'

I02 LAGUNA CANYON CHANNEL CL

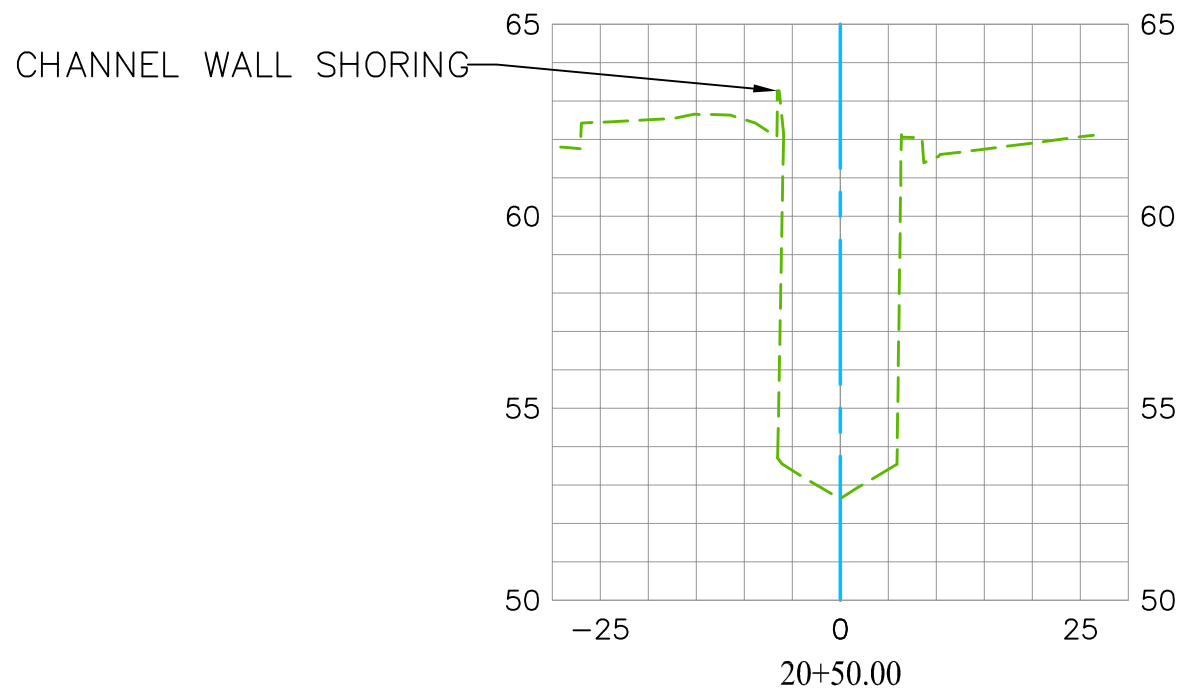


EXISTING CONDITION 2019

DATE PREPARED: 11/26/2019

Vert. Scale: 1"=5'
 Hor. Scale: 1"=20'

I02 LAGUNA CANYON CHANNEL CL

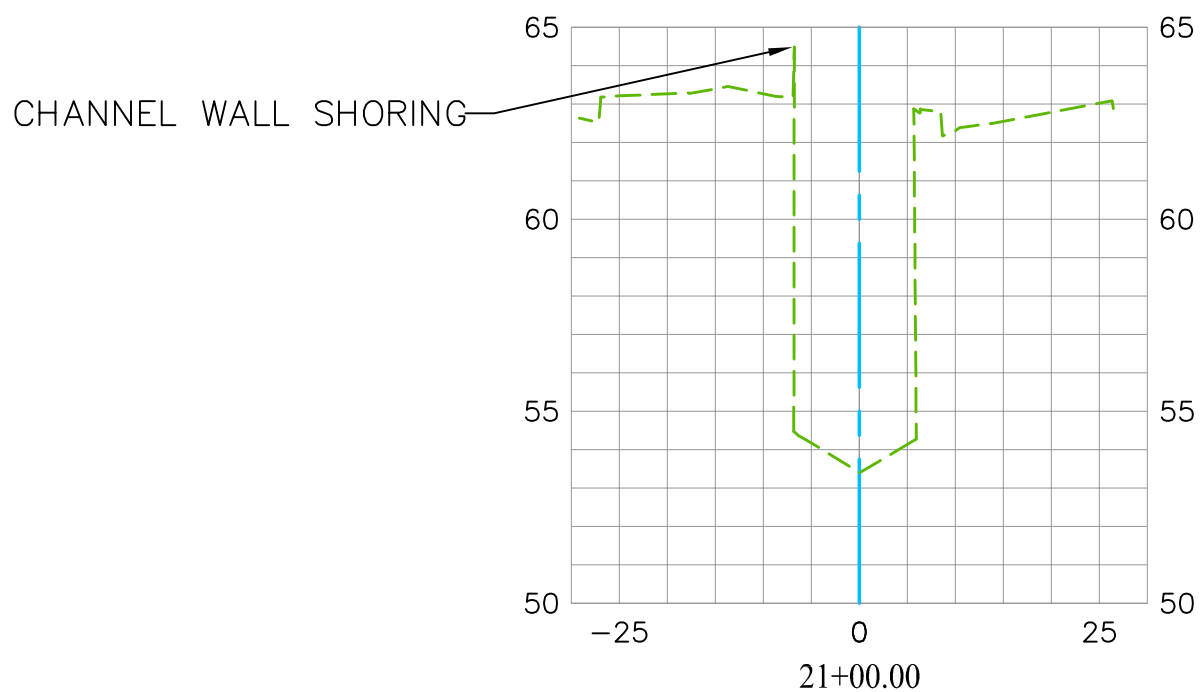


EXISTING CONDITION 2019

DATE PREPARED: 11/26/2019

Vert. Scale: 1"=5'
Hor. Scale: 1"=20'


I02 LAGUNA CANYON CHANNEL CL

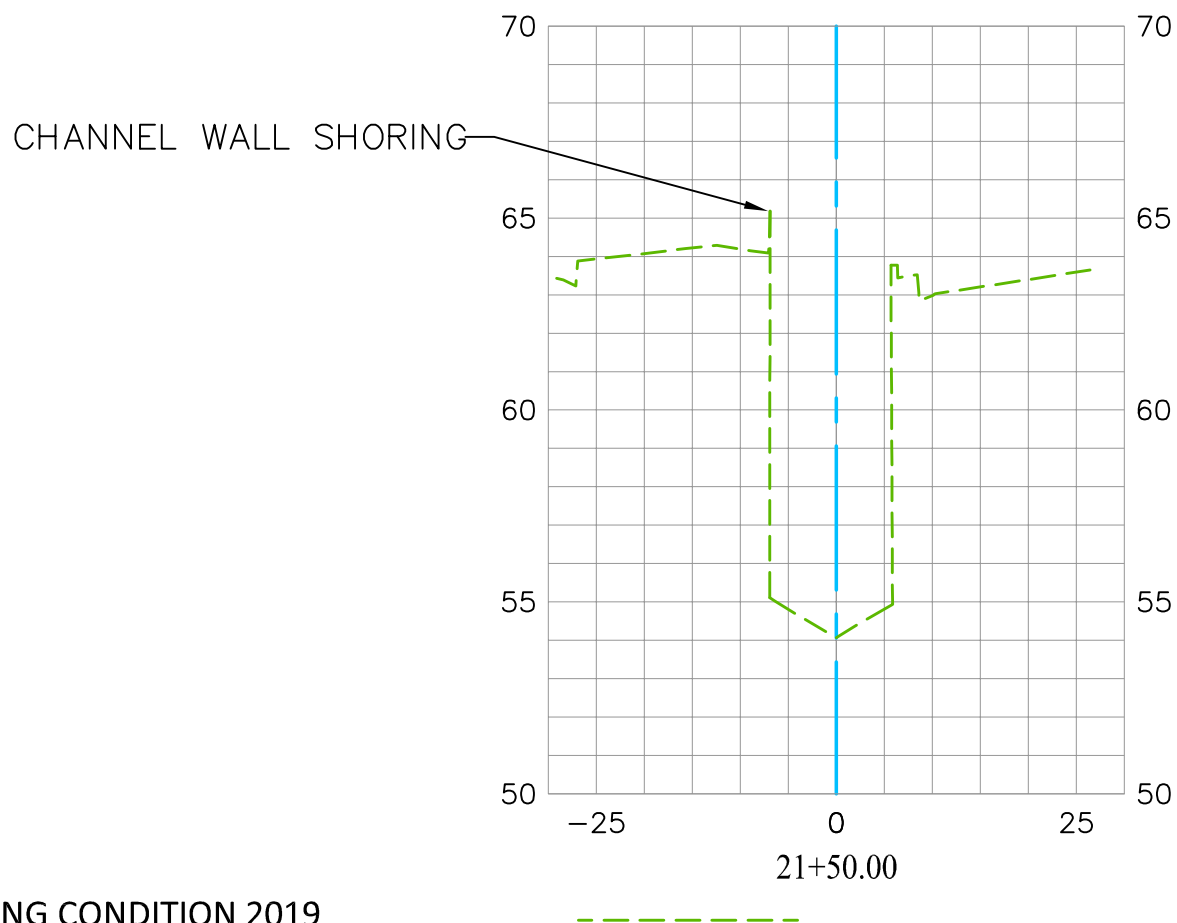

EXISTING CONDITION 2019

DATE PREPARED: 11/26/2019


Vert. Scale: 1"=5'
Hor. Scale: 1"=20'

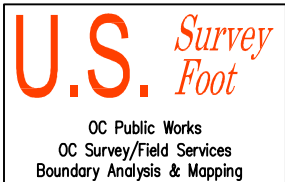

I02 LAGUNA CANYON CHANNEL

CHANNEL WALL SHORING

CL

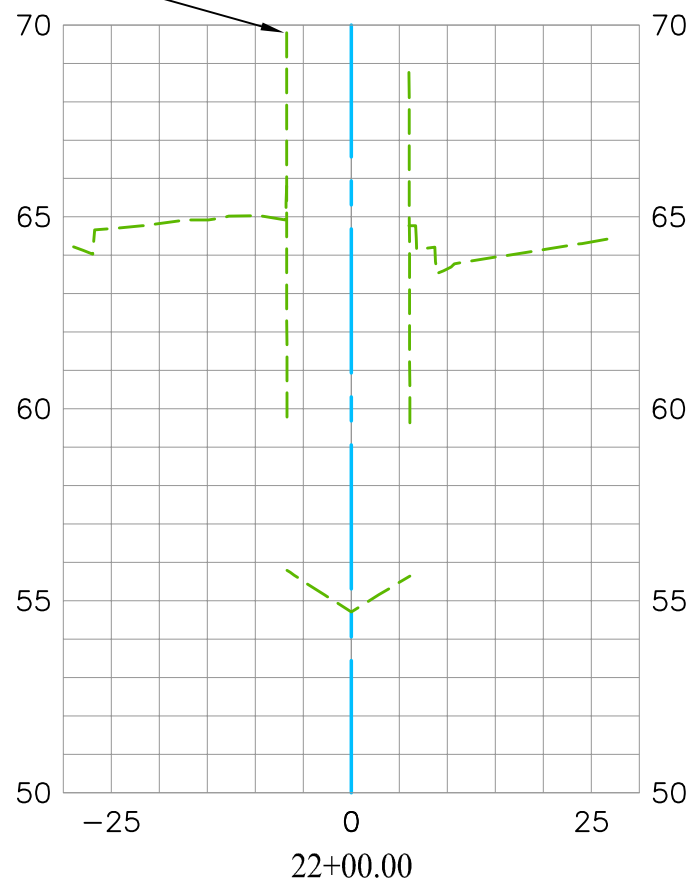


EXISTING CONDITION 2019

DATE PREPARED: 11/26/2019

Vert. Scale: 1"=5'
Hor. Scale: 1"=20'

I02 LAGUNA CANYON CHANNEL CL

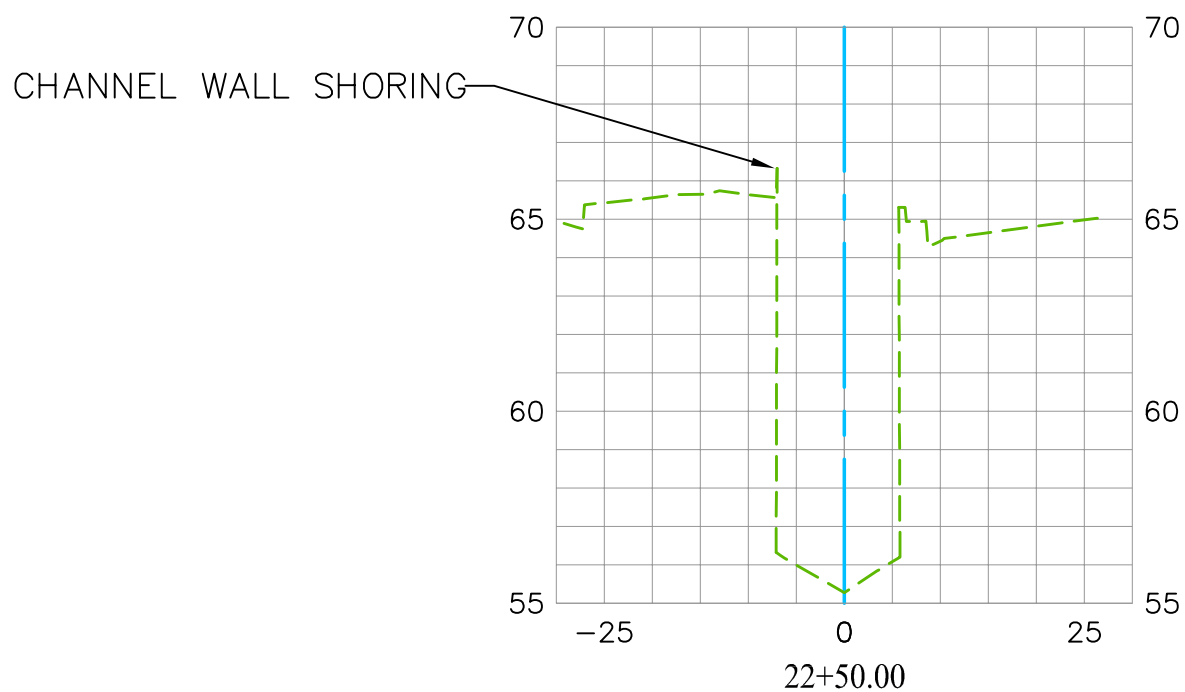


EXISTING CONDITION 2019

DATE PREPARED: 11/26/2019

Vert. Scale: 1"=5'
Hor. Scale: 1"=20'


I02 LAGUNA CANYON CHANNEL CL

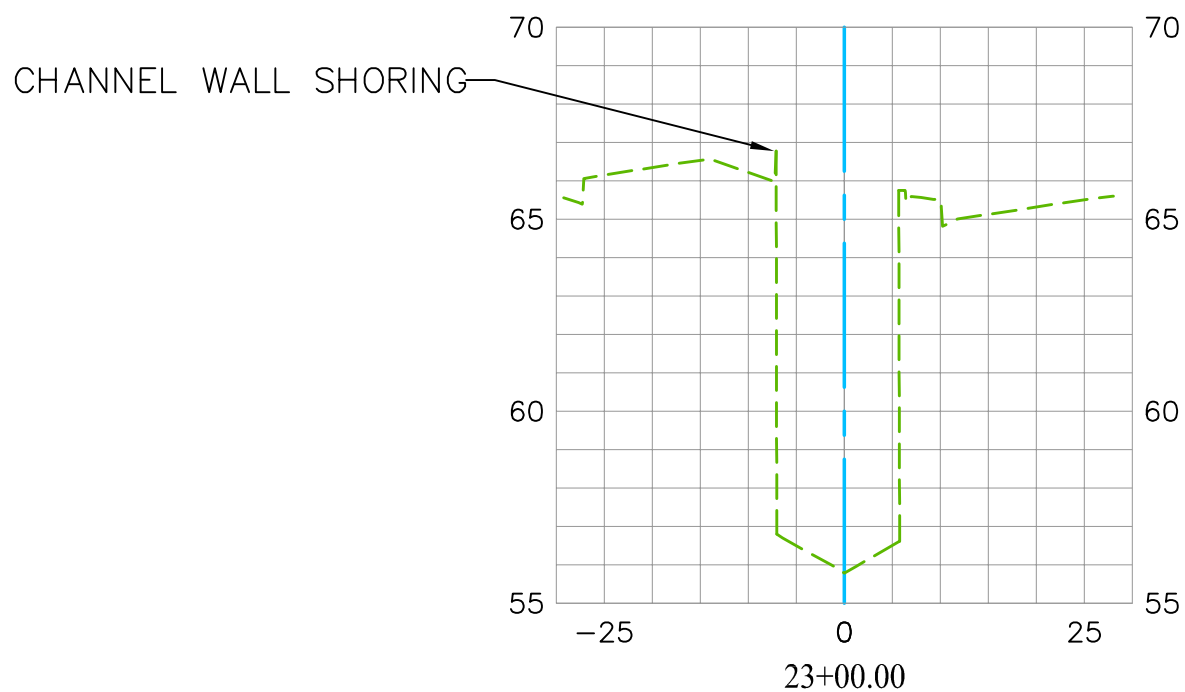


EXISTING CONDITION 2019

DATE PREPARED: 11/26/2019

Vert. Scale: 1"=5'
Hor. Scale: 1"=20'

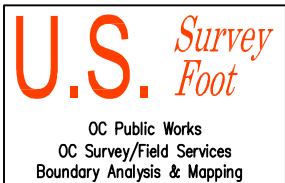


I02 LAGUNA CANYON CHANNEL CL

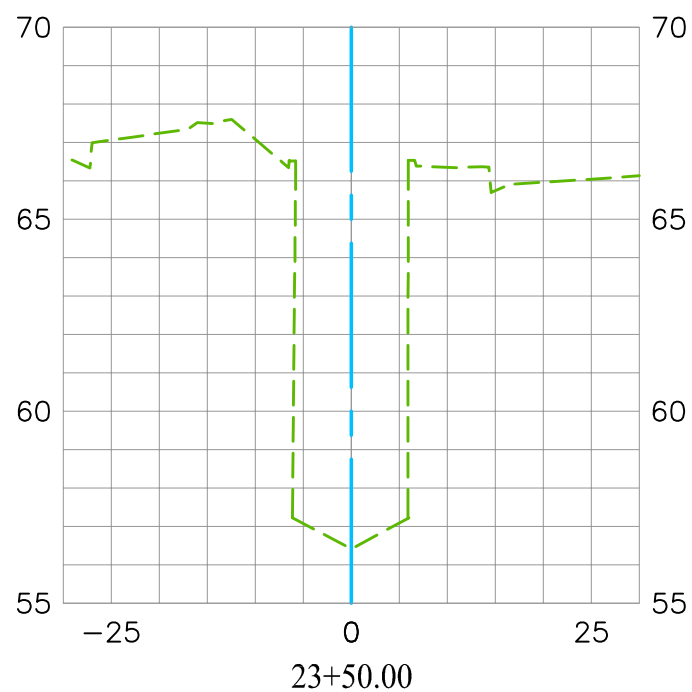


EXISTING CONDITION 2019

DATE PREPARED: 11/26/2019

Vert. Scale: 1"=5'
Hor. Scale: 1"=20'

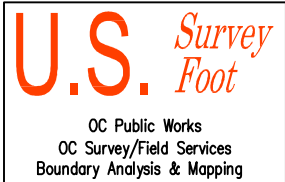


I02 LAGUNA CANYON CHANNEL CL

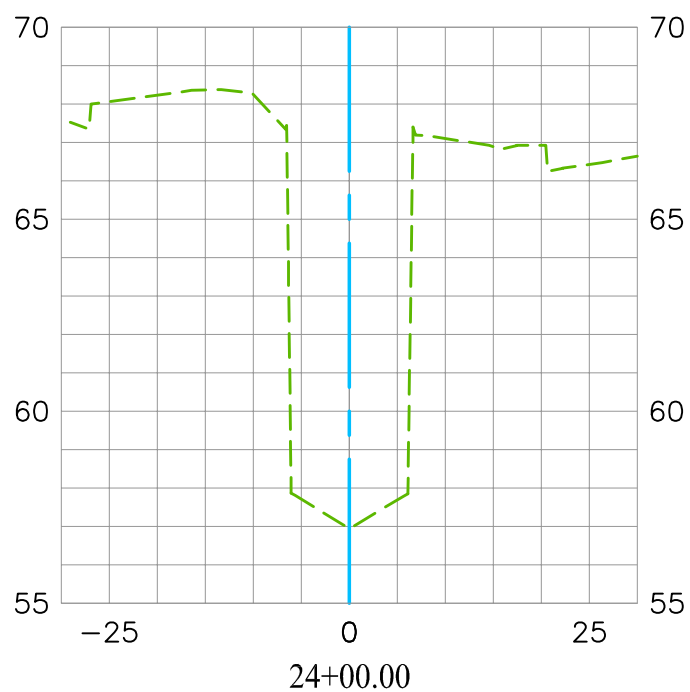


EXISTING CONDITION 2019

DATE PREPARED: 11/26/2019

Vert. Scale: 1"=5'
Hor. Scale: 1"=20'

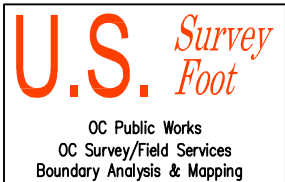


I02 LAGUNA CANYON CHANNEL CL

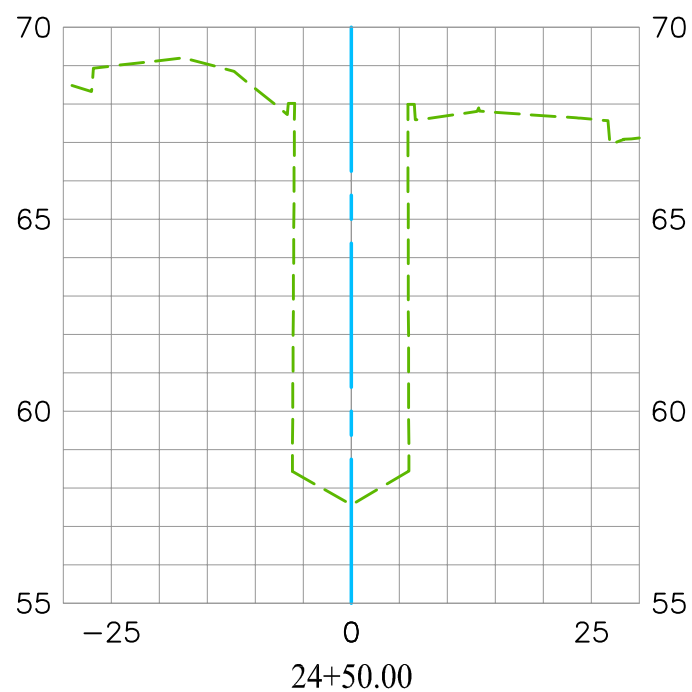


EXISTING CONDITION 2019

DATE PREPARED: 11/26/2019

Vert. Scale: 1"=5'
Hor. Scale: 1"=20'

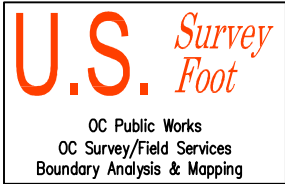


I02 LAGUNA CANYON CHANNEL CL

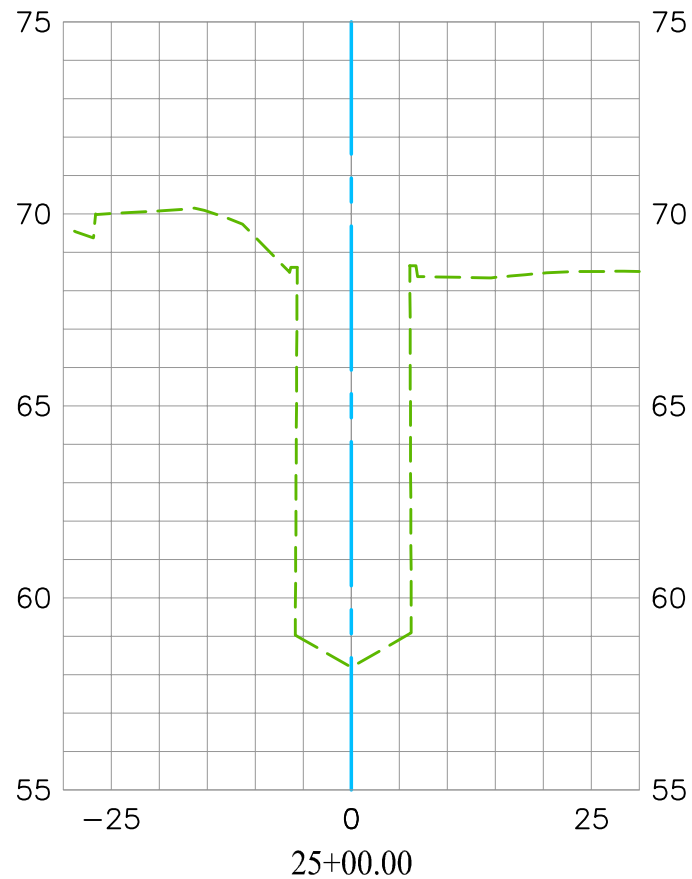


EXISTING CONDITION 2019

DATE PREPARED: 11/26/2019

Vert. Scale: 1"=5'
Hor. Scale: 1"=20'

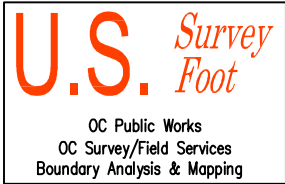


I02 LAGUNA CANYON CHANNEL CL

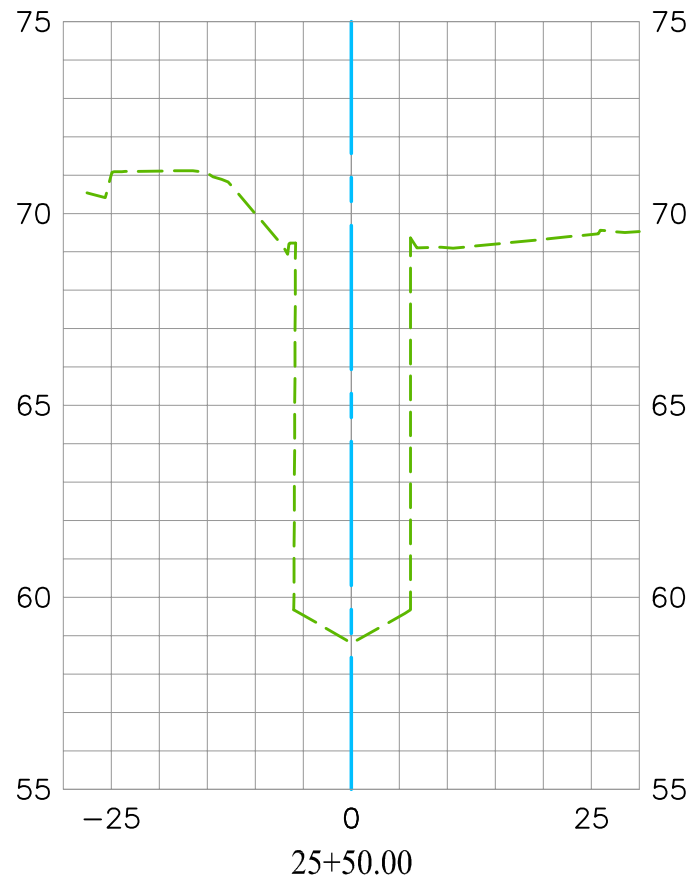


EXISTING CONDITION 2019

DATE PREPARED: 11/26/2019

Vert. Scale: 1"=5'
Hor. Scale: 1"=20'

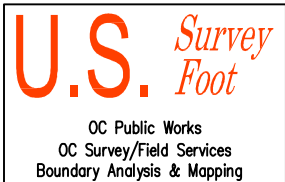


I02 LAGUNA CANYON CHANNEL CL

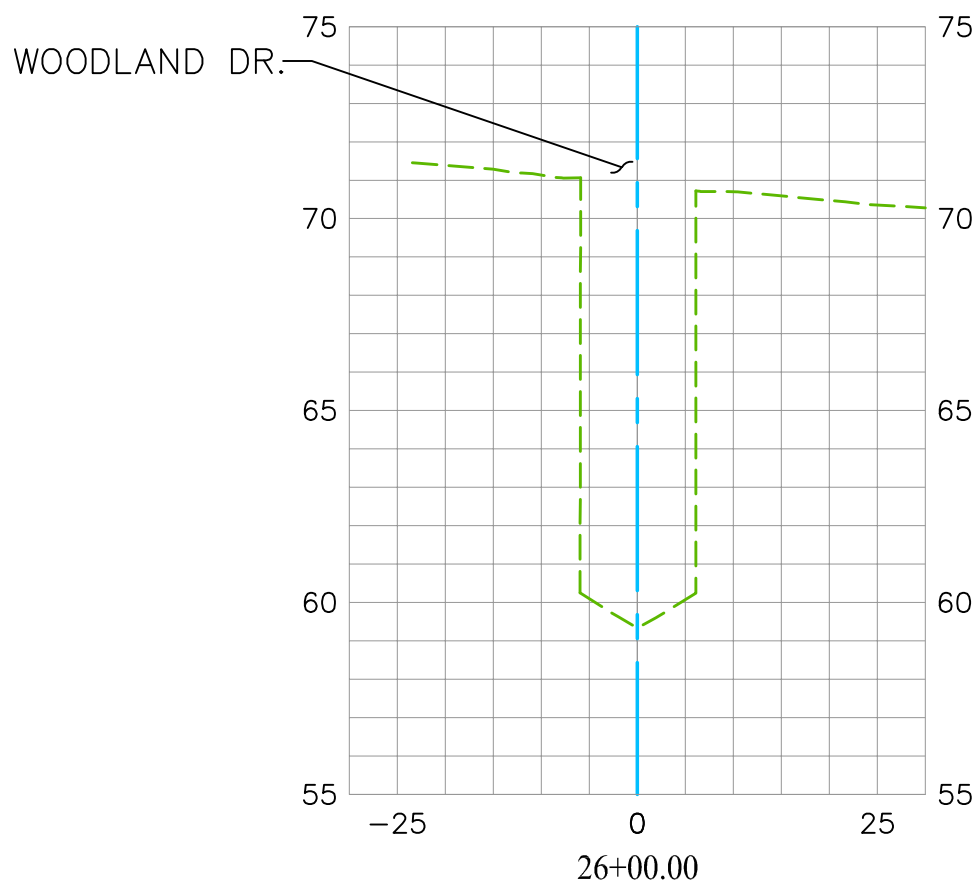


EXISTING CONDITION 2019

DATE PREPARED: 11/26/2019

Vert. Scale: 1"=5'
Hor. Scale: 1"=20'

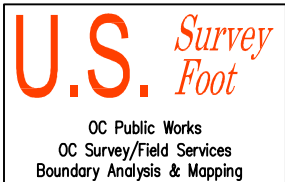

I02 LAGUNA CANYON CHANNEL CL

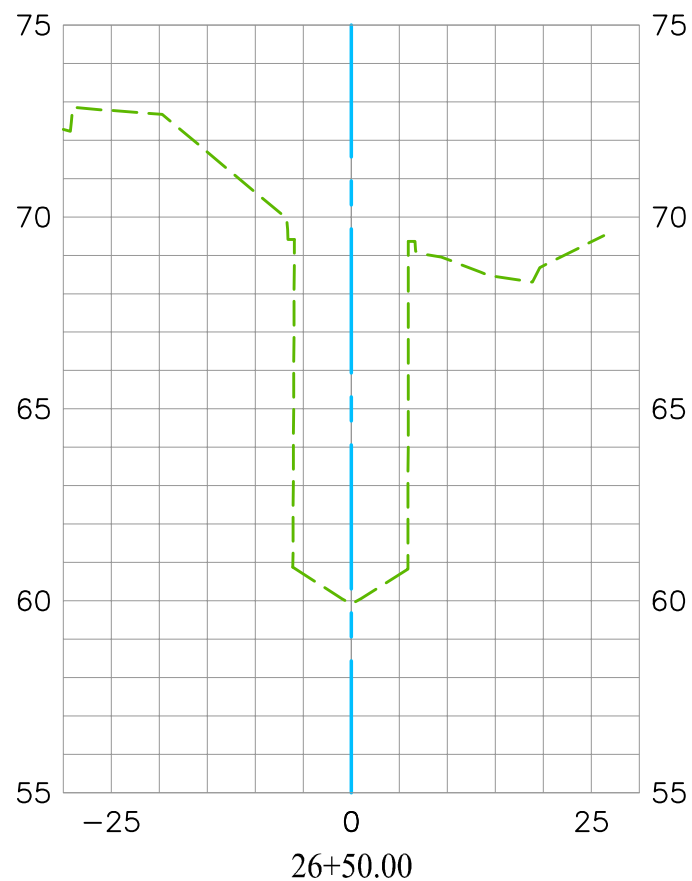


EXISTING CONDITION 2019

DATE PREPARED: 11/26/2019

Vert. Scale: 1"=5'
Hor. Scale: 1"=20'


I02 LAGUNA CANYON CHANNEL CL

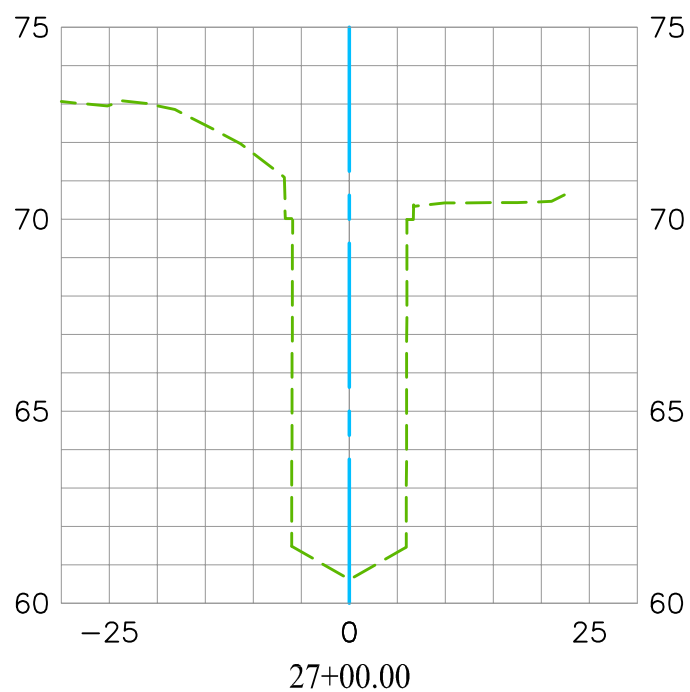


EXISTING CONDITION 2019

DATE PREPARED: 11/26/2019

Vert. Scale: 1"=5'
Hor. Scale: 1"=20'

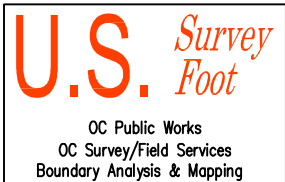


I02 LAGUNA CANYON CHANNEL CL

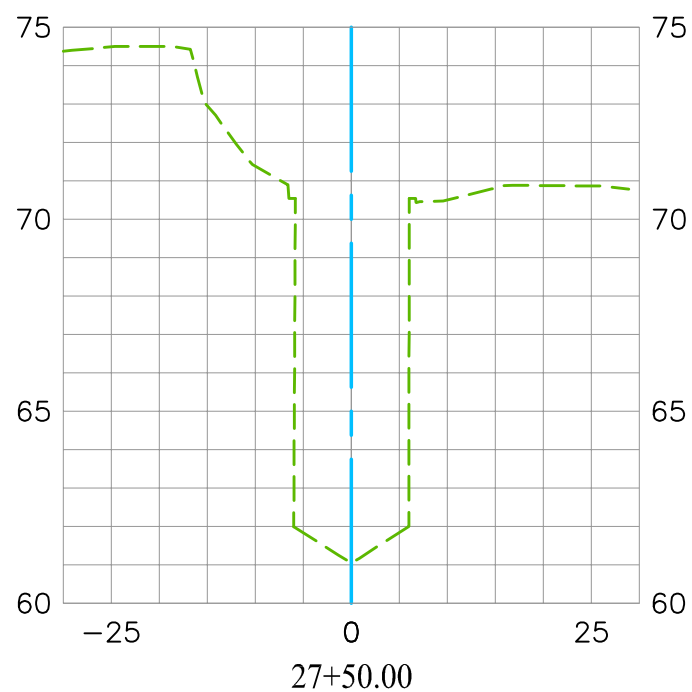


EXISTING CONDITION 2019

DATE PREPARED: 11/26/2019

Vert. Scale: 1"=5'
Hor. Scale: 1"=20'

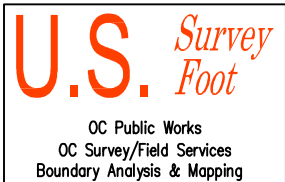


I02 LAGUNA CANYON CHANNEL CL

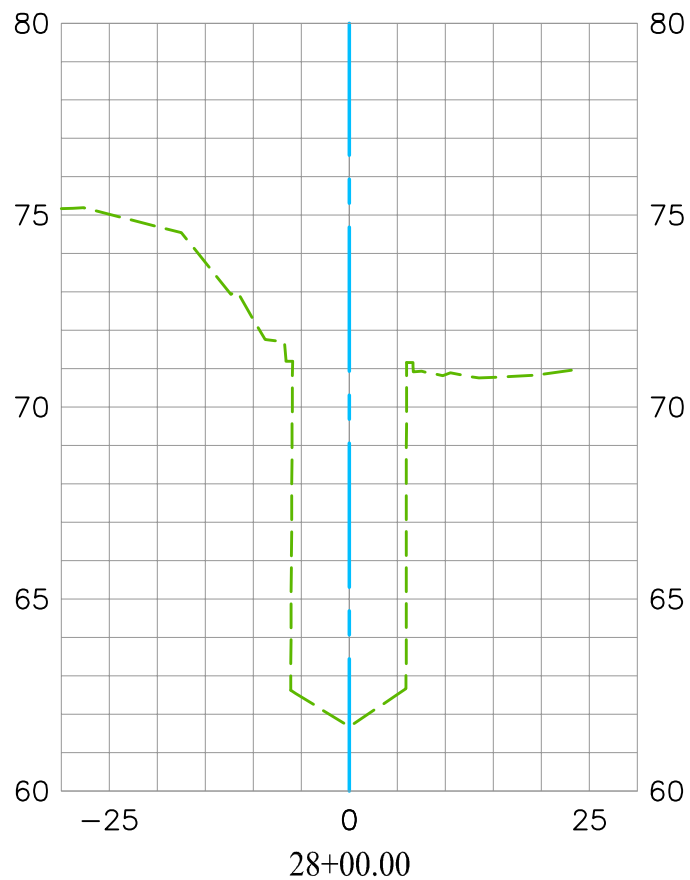


EXISTING CONDITION 2019

DATE PREPARED: 11/26/2019

Vert. Scale: 1"=5'
Hor. Scale: 1"=20'

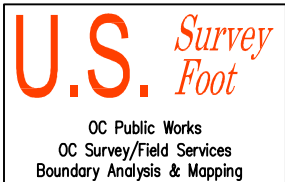


I02 LAGUNA CANYON CHANNEL CL

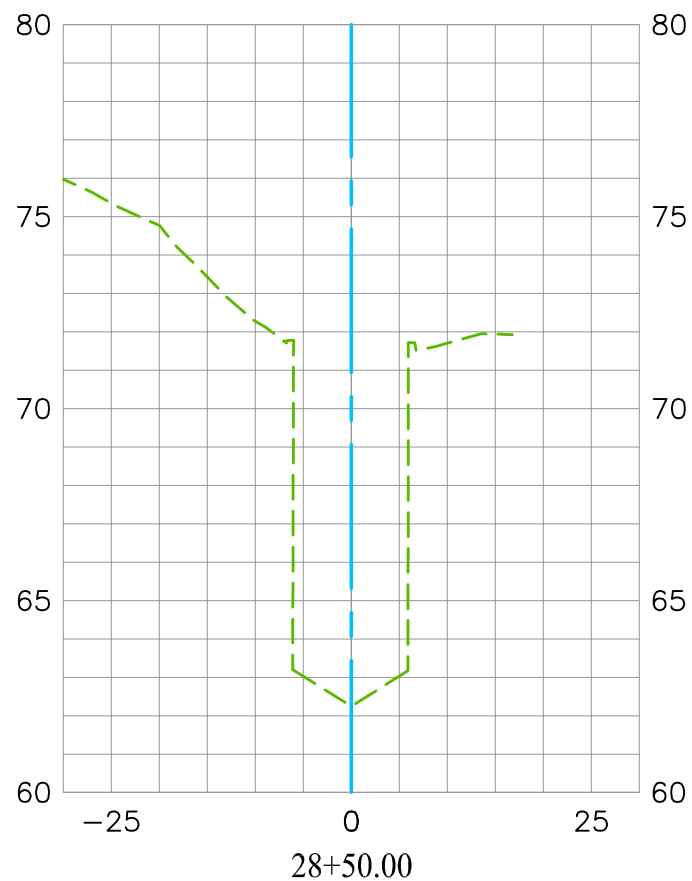


EXISTING CONDITION 2019

DATE PREPARED: 11/26/2019

Vert. Scale: 1"=5'
Hor. Scale: 1"=20'

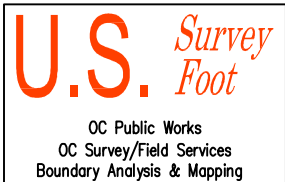


I02 LAGUNA CANYON CHANNEL CL

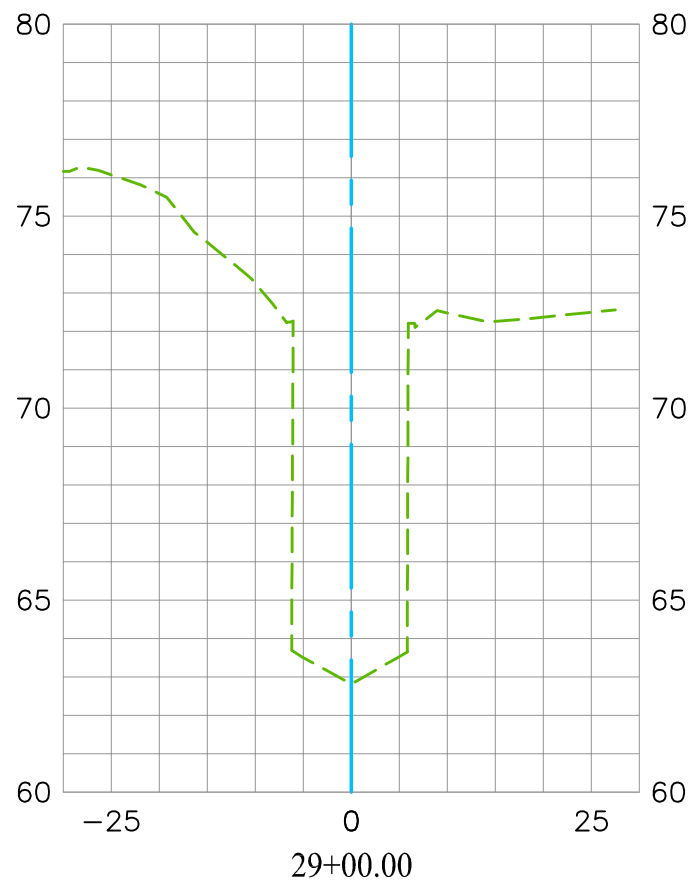


EXISTING CONDITION 2019

DATE PREPARED: 11/26/2019

Vert. Scale: 1"=5'
Hor. Scale: 1"=20'

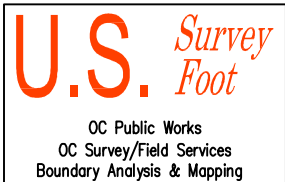


I02 LAGUNA CANYON CHANNEL CL

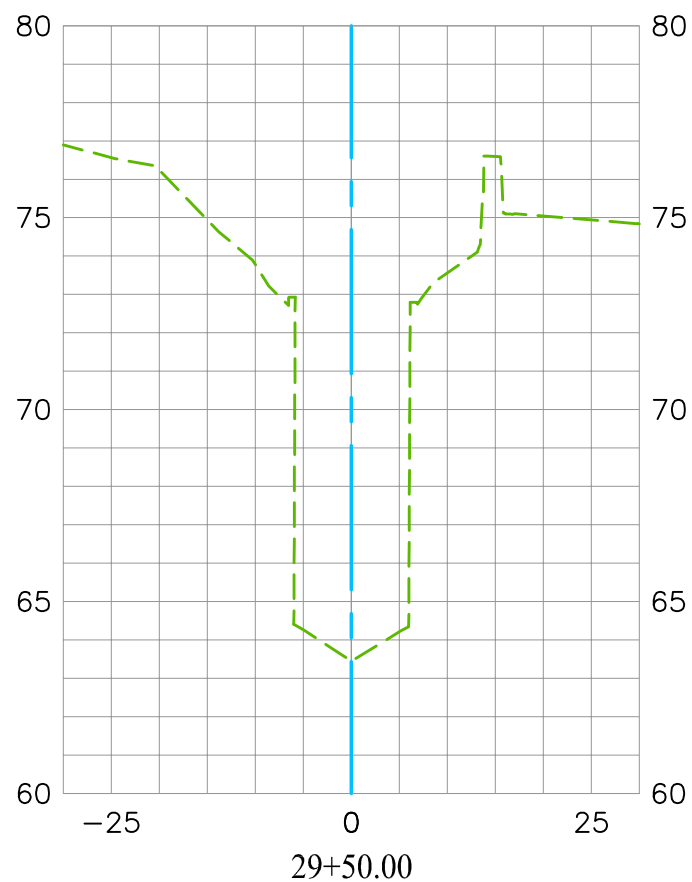


EXISTING CONDITION 2019

DATE PREPARED: 11/26/2019

Vert. Scale: 1"=5'
Hor. Scale: 1"=20'

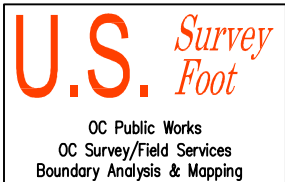

I02 LAGUNA CANYON CHANNEL CL

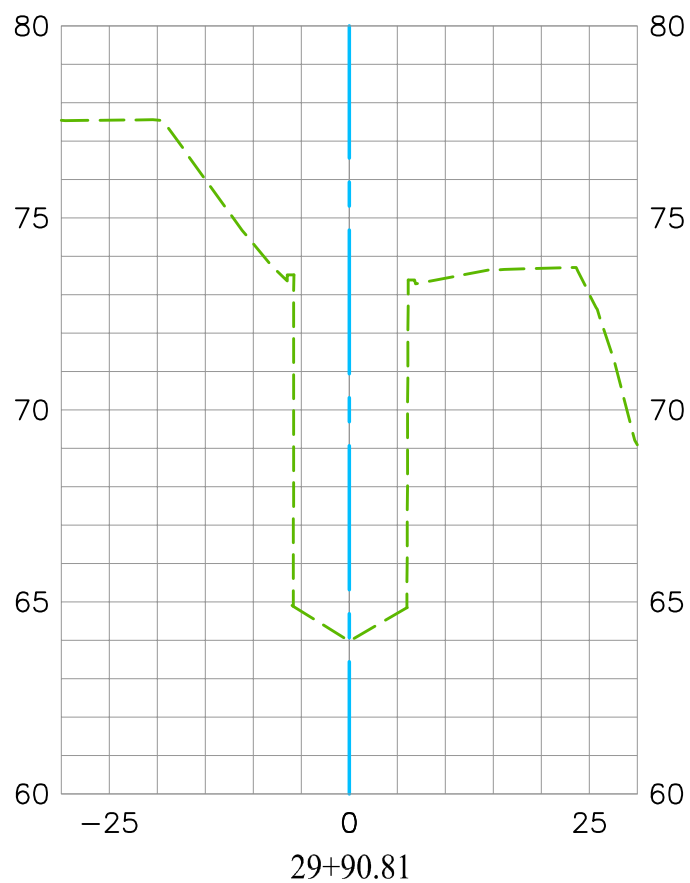

EXISTING CONDITION 2019

DATE PREPARED: 11/26/2019

Vert. Scale: 1"=5'
Hor. Scale: 1"=20'