


Block 5158 Module. 91
CORNER RECORD

WM 44a

Document Number 98-322
County of Orange, California

City of Unincorporated
Brief Legal Description Tract No. 15280

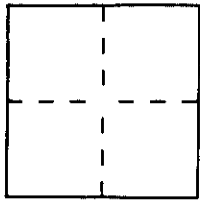

CORNER TYPE

Government Corner ☐ Control ☐
Meander ☐ Property ☐
Rancho ☐ Other ☐
Date of Survey _____

**COORDINATES
(Optional)**

N _____
E _____
Zone _____ Datum _____
Elev _____

Corner — Left as found ☐ Found and tagged ☐ Established ☒ Reestablished ☐ Rebuilt ☐

Identification and type of corner found Evidence used to identify or procedure used to establish or reestablish the corner


A description of the physical condition of the monument as found and as set or reset _____

Set centerline monuments per Tract No. 15280, Set lead, tack and tag
ties as shown hereon.

SURVEYOR'S STATEMENT

This Corner Record was prepared by me or under my direction in conformance with
the Land Surveyors' Act on February 4 1998

Signed [Signature] L.S. or R.C.E. Number L.S. 5649

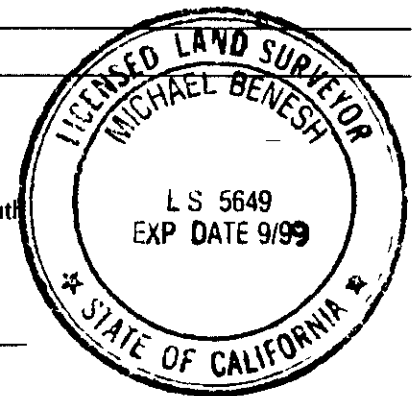


COUNTY SURVEYOR'S STATEMENT

This Corner Record was received 8/24 1998 and examined

and filed September 1st 1998

Signed [Signature] Title DEPUTY COUNTY SURVEYOR

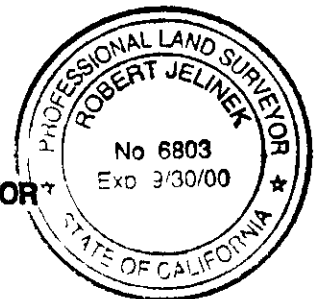

County Surveyor's Comment _____

SURVEYED BY

DATE

ORANGE COUNTY SURVEYOR

© TIE NOTES FOR TRACT 15280
TIE BY SOUTHWEST CIVIL ENGINEERING
MICHAEL L. BENESH LS5649

SHEET 2 OF 5 SHEETS
DATE OF SURVEY,
FEBRUARY 4, 1998


MONUMENT NOTES

- SET SPIKE & WASHER STAMPED "L.S.5649"

ALL TIE POINTS ARE LEAD, TACK &
TAG L.S. "5649" IN TOP OF CURB

INDEX MAP

NOT TO SCALE

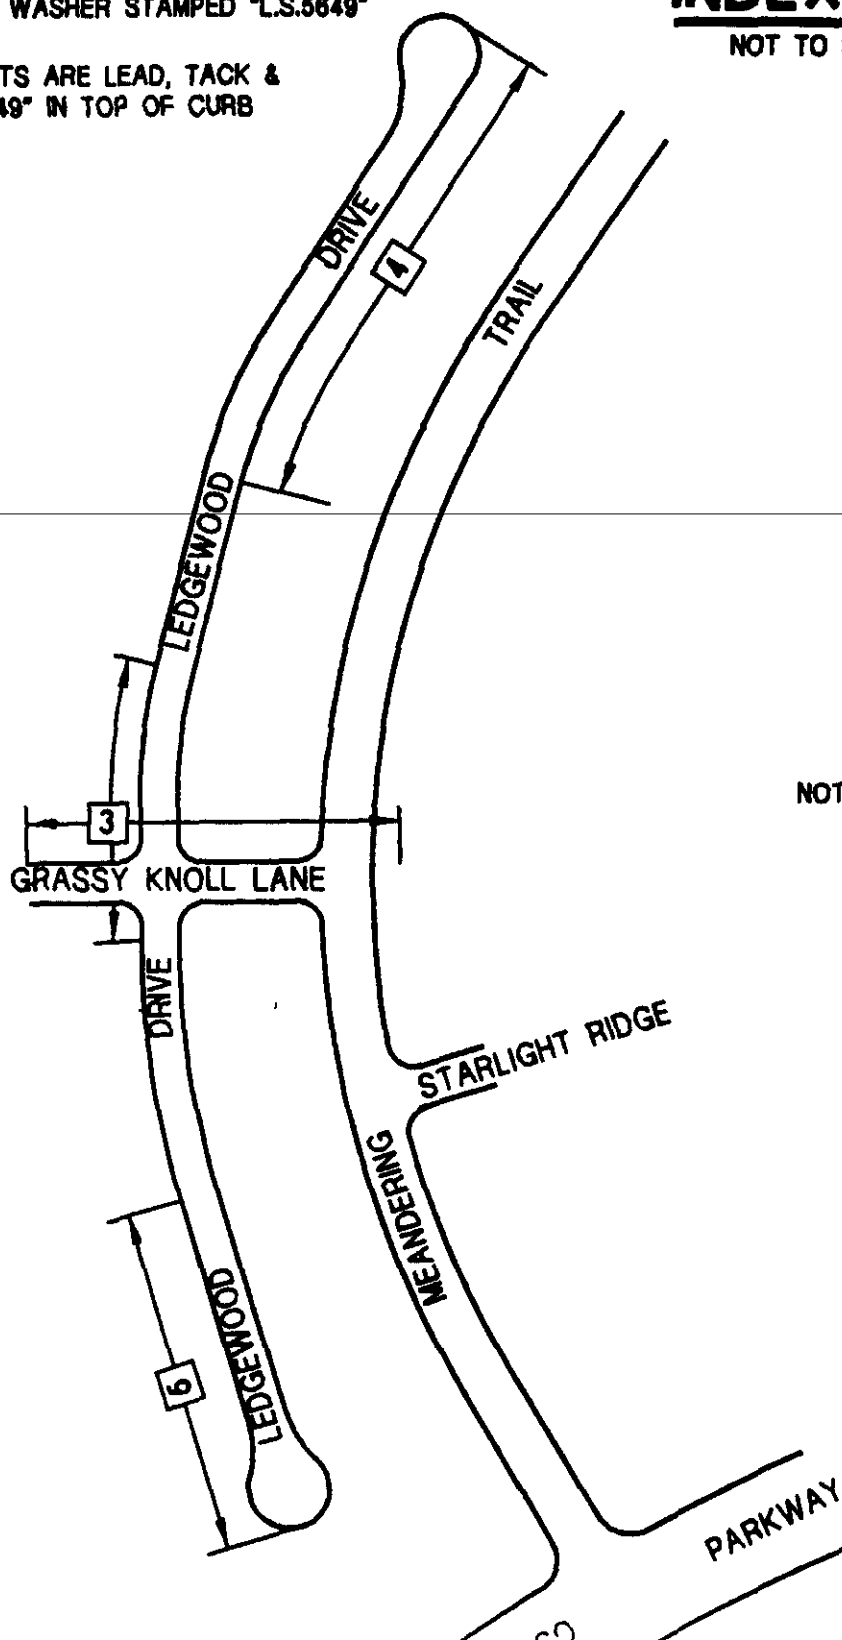

NOT TO SCALE

SURVEYED BY

DATE

ORANGE COUNTY SURVEYOR


SHEET 3 OF 5 SHEETS
DATE OF SURVEY.
FEBRUARY 4, 1998

© TIE NOTES FOR TRACT 15280
TIE BY SOUTHWEST CIVIL ENGINEERING
MICHAEL L. BENESH LS5649

SEE SHEET 2 FOR MONUMENT NOTES

NOTE
TIES ON THIS SHEET ARE NOT
TANGENT OVER

SEE SHEET 4

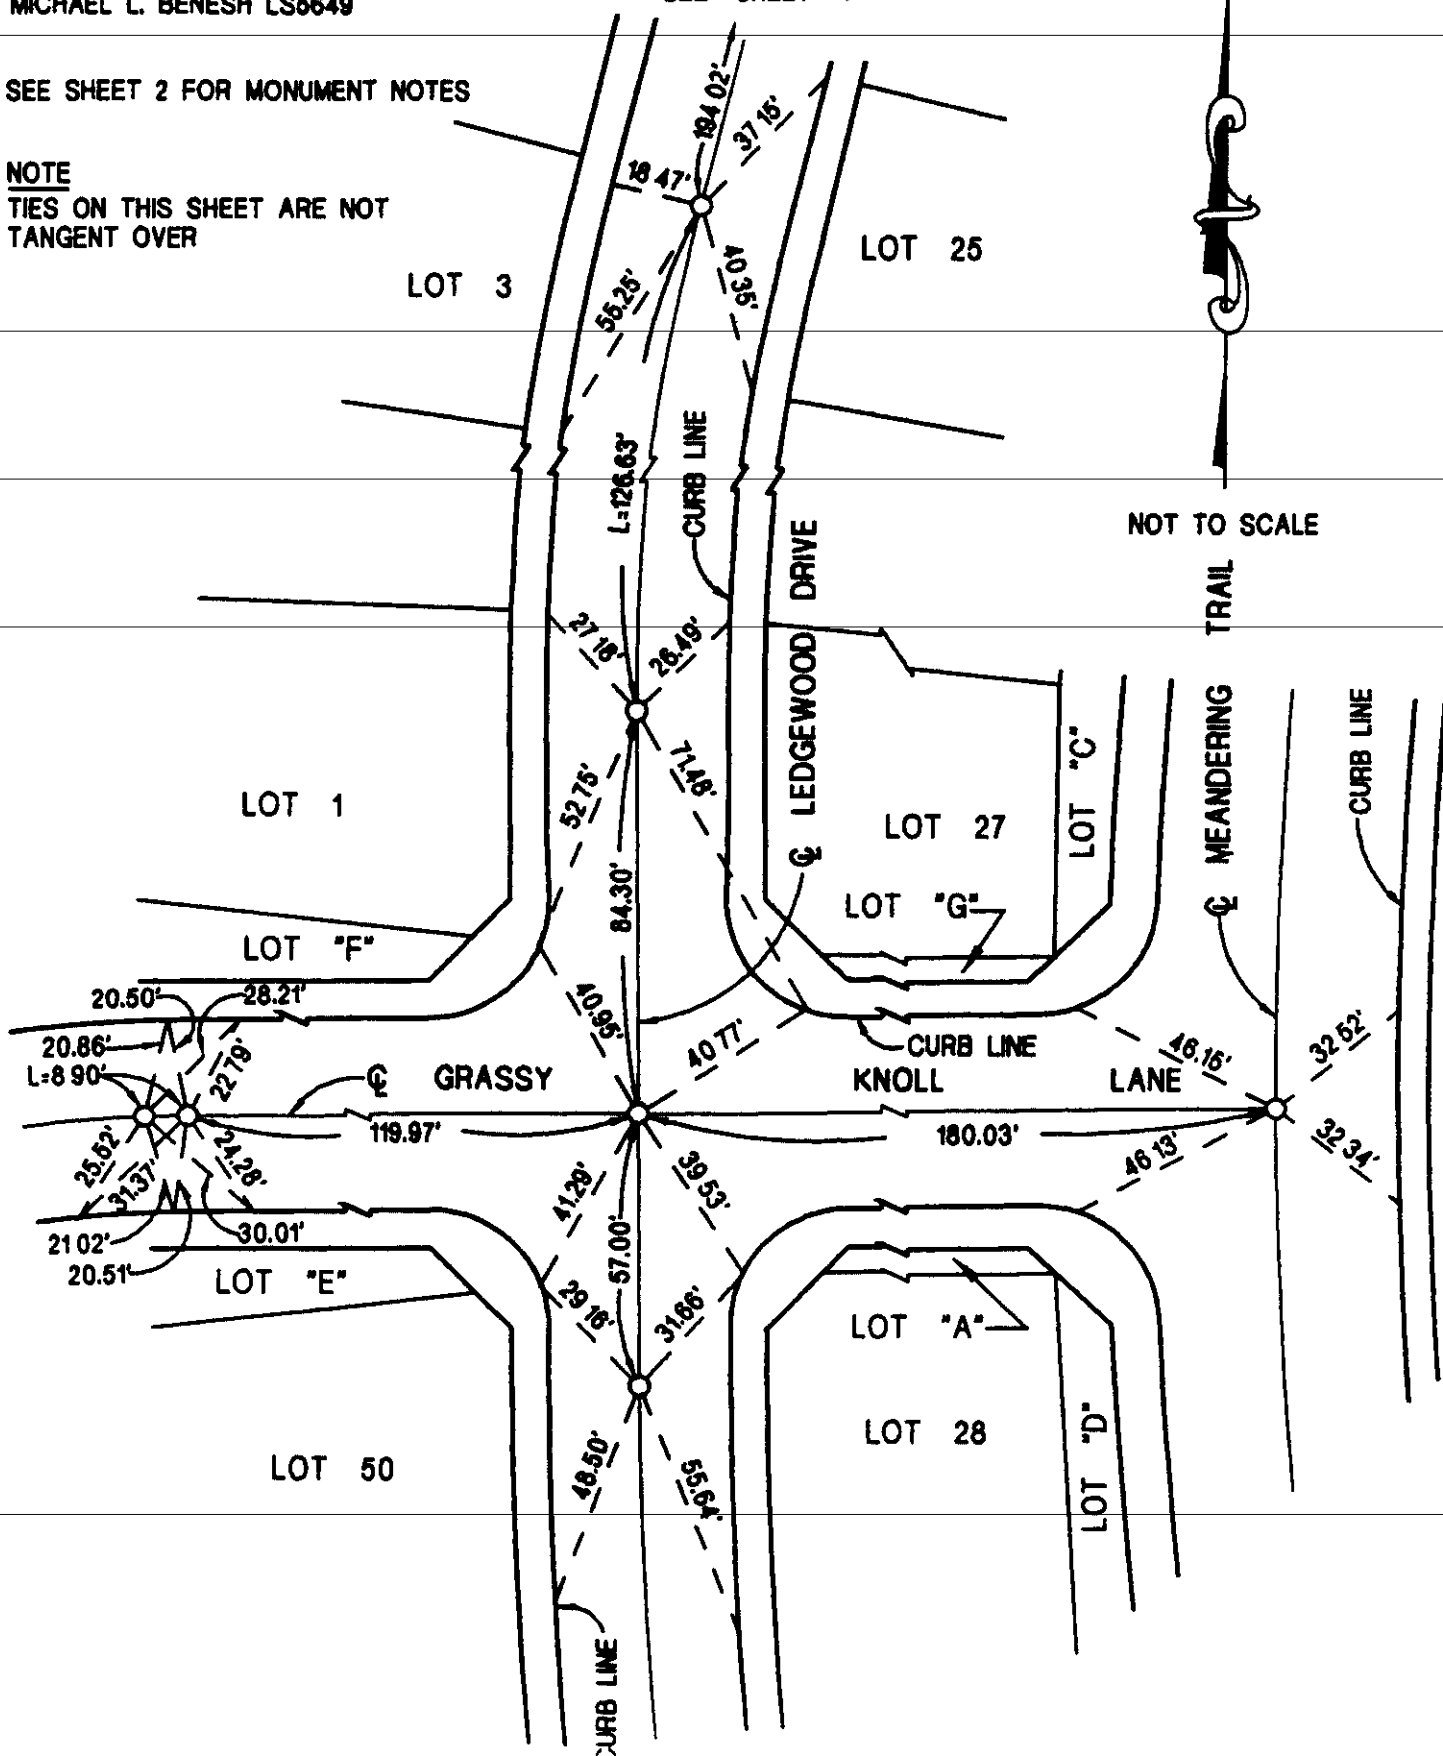

CURVED BY

DATE

ORANGE COUNTY SURVEYOR


© TIE NOTES FOR TRACT 15280
TIE BY SOUTHWEST CIVIL ENGINEERING
MICHAEL L. BENESH LS5649

SEE SHEET 2 FOR MONUMENT NOTES

NOTE

TIES ON THIS SHEET ARE NOT
TANGENT OVER.

SHEET 4 OF 5 SHEETS
DATE OF SURVEY.
FEBRUARY 4, 1998

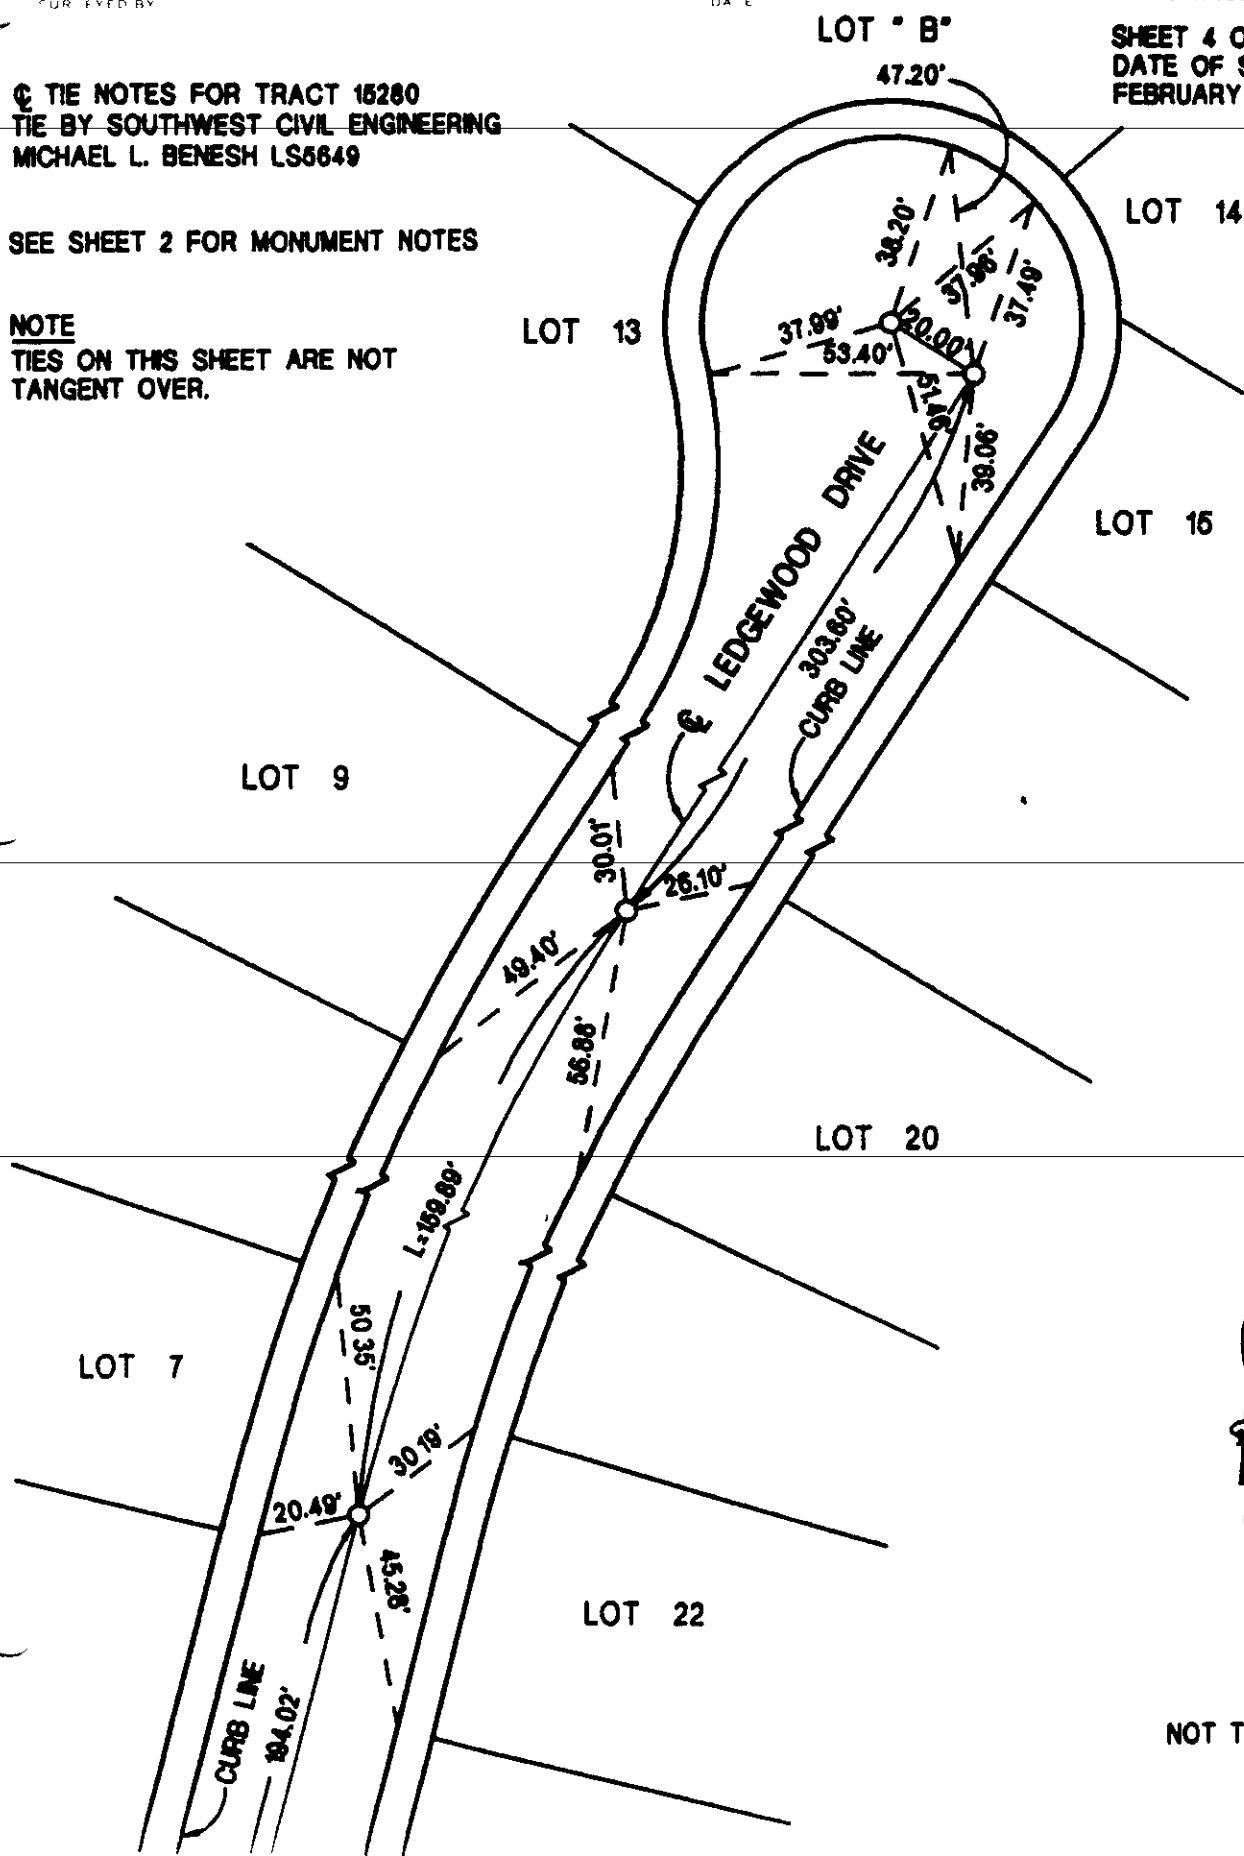

NOT TO SCALE