

Block: 5258 MODULES: 01, 02

WM 40E


## CORNER RECORD

Document Number 99-50

City of UNINCORPORATED

County of ORANGE, California

Brief Legal Description 4 TIES FOR SUNNY SLOPE, MEANDERING TRAIL PORTION OF TRACT 15349

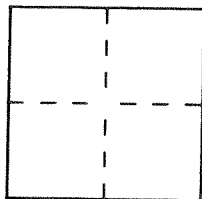

## CORNER TYPE

Government Corner ☐ Control ☐  
 Meander ☐ Property ☒  
 Rancho ☐ Other ☐  
 Date of Survey 1/99

COORDINATES  
(Optional)

N. \_\_\_\_\_  
 E. \_\_\_\_\_  
 Zone \_\_\_\_\_ Datum \_\_\_\_\_  
 Elev. \_\_\_\_\_

Corner — Left as found ☐ Found and tagged ☐ Established ☒ Reestablished ☐ Rebuilt ☐

Identification and type of corner found: Evidence used to identify or procedure used to establish or reestablish the corner:

SET SPIKE & WASHER, R.C.E. 21687 AT THE CENTERLINE  
 OF SUNNY SLOPE, MEANDERING TRAIL PORTION OF TR. 15349.

A description of the physical condition of the monument as found and as set or reset:

## SURVEYOR'S STATEMENT

This Corner Record was prepared by me or under my direction in conformance with  
 the Land Surveyors' Act on FEB 1 1999.


Signed \_\_\_\_\_ L.S. or R.C.E. Number 21687




## COUNTY SURVEYOR'S STATEMENT

This Corner Record was received Feb. 4 1999 and examined  
 and filed March 4th 1999.


Signed Robert Jelinek Title DEPUTY COUNTY SURVEYOR

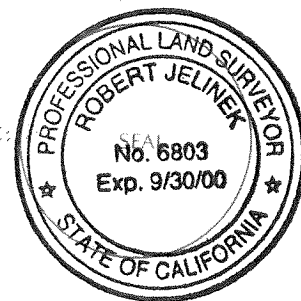

County Surveyor's Comment

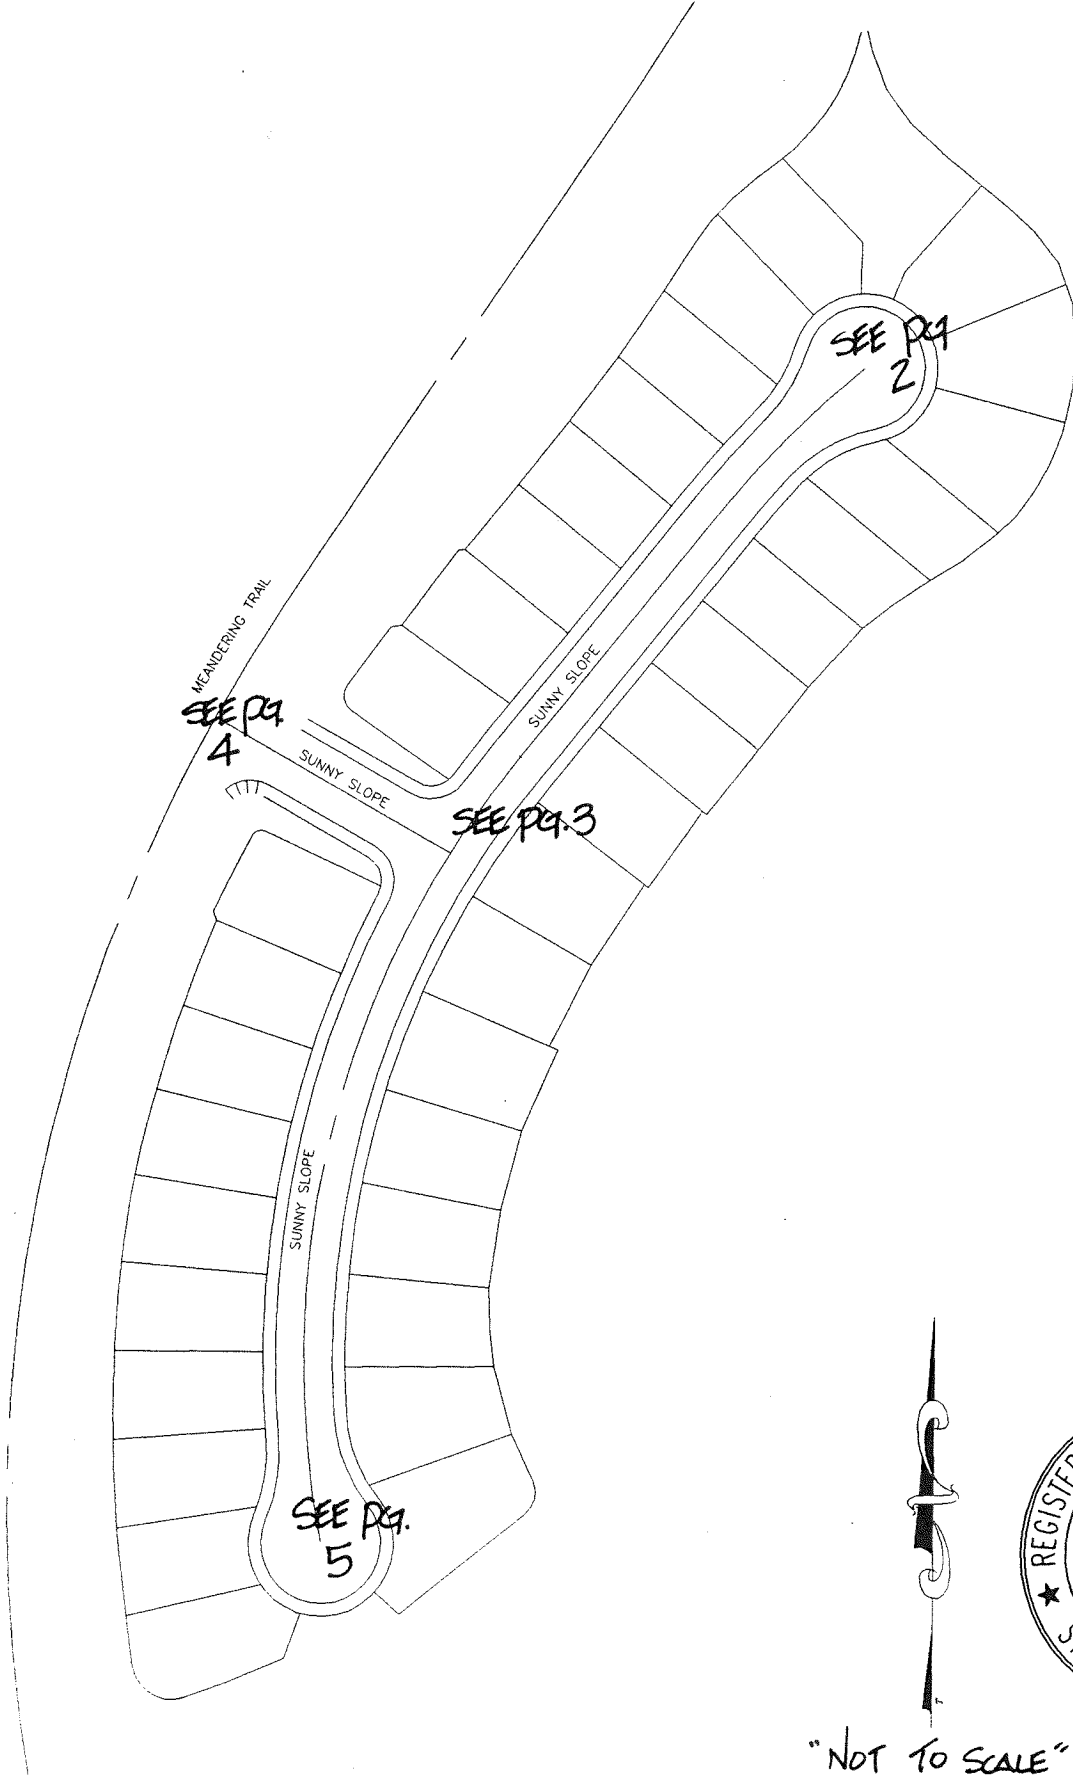

"NOT TO SCALE"

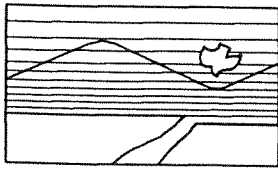




**Adams • Streeter**  
**CIVIL ENGINEERS INC.**

15 Corporate Park, Irvine, CA 92606  
Ph: (949) 474-2330 Fax: (949) 474-0251  
email: ASIASI@ix.netcom.com

TRACT NO. 15349  
**CENTERLINE TIES**

DATE: 1/99

PAGE 1 OF 5

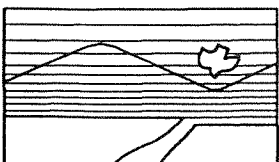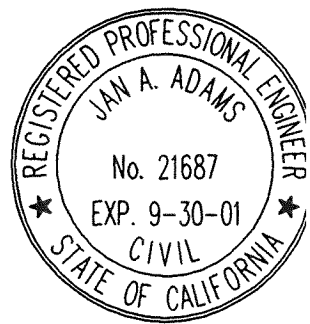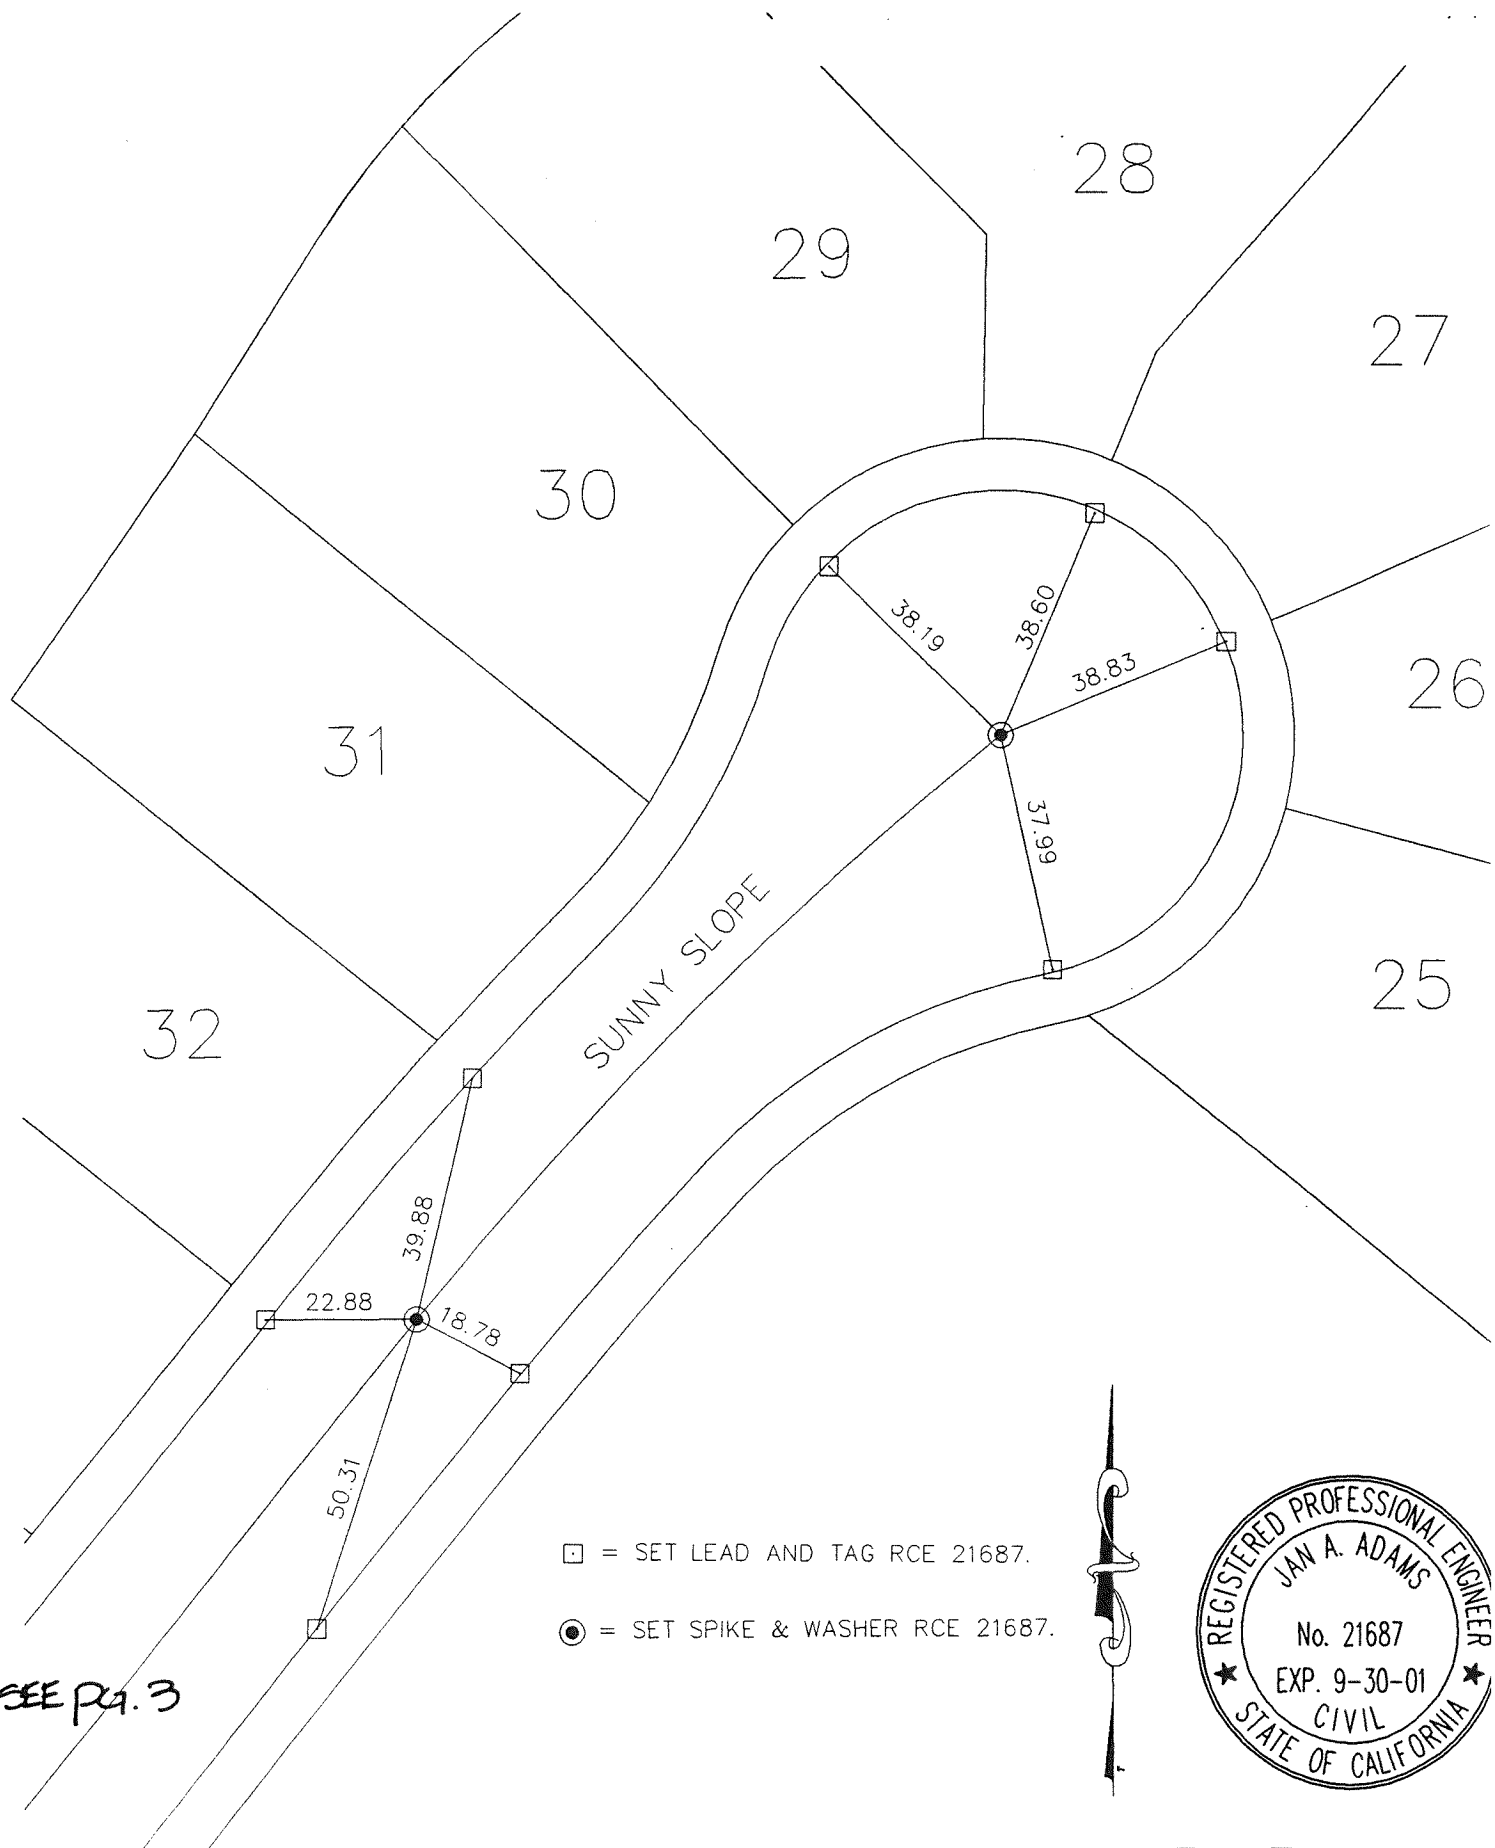

**Adams • Streeter**  
CIVIL ENGINEERS INC.

15 Corporate Park, Irvine, CA 92606  
Ph: (949) 474-2330 Fax: (949) 474-0251  
email: ASIASI@ix.netcom.com




TRACT NO. 15349

**CENTERLINE TIES**

DATE: 1/99

SCALE: 1"=30'

DG 7 ncs

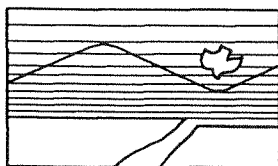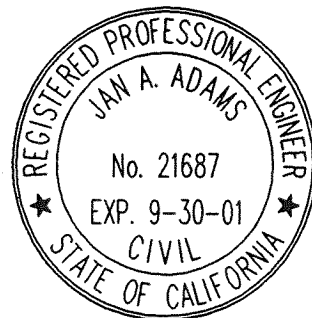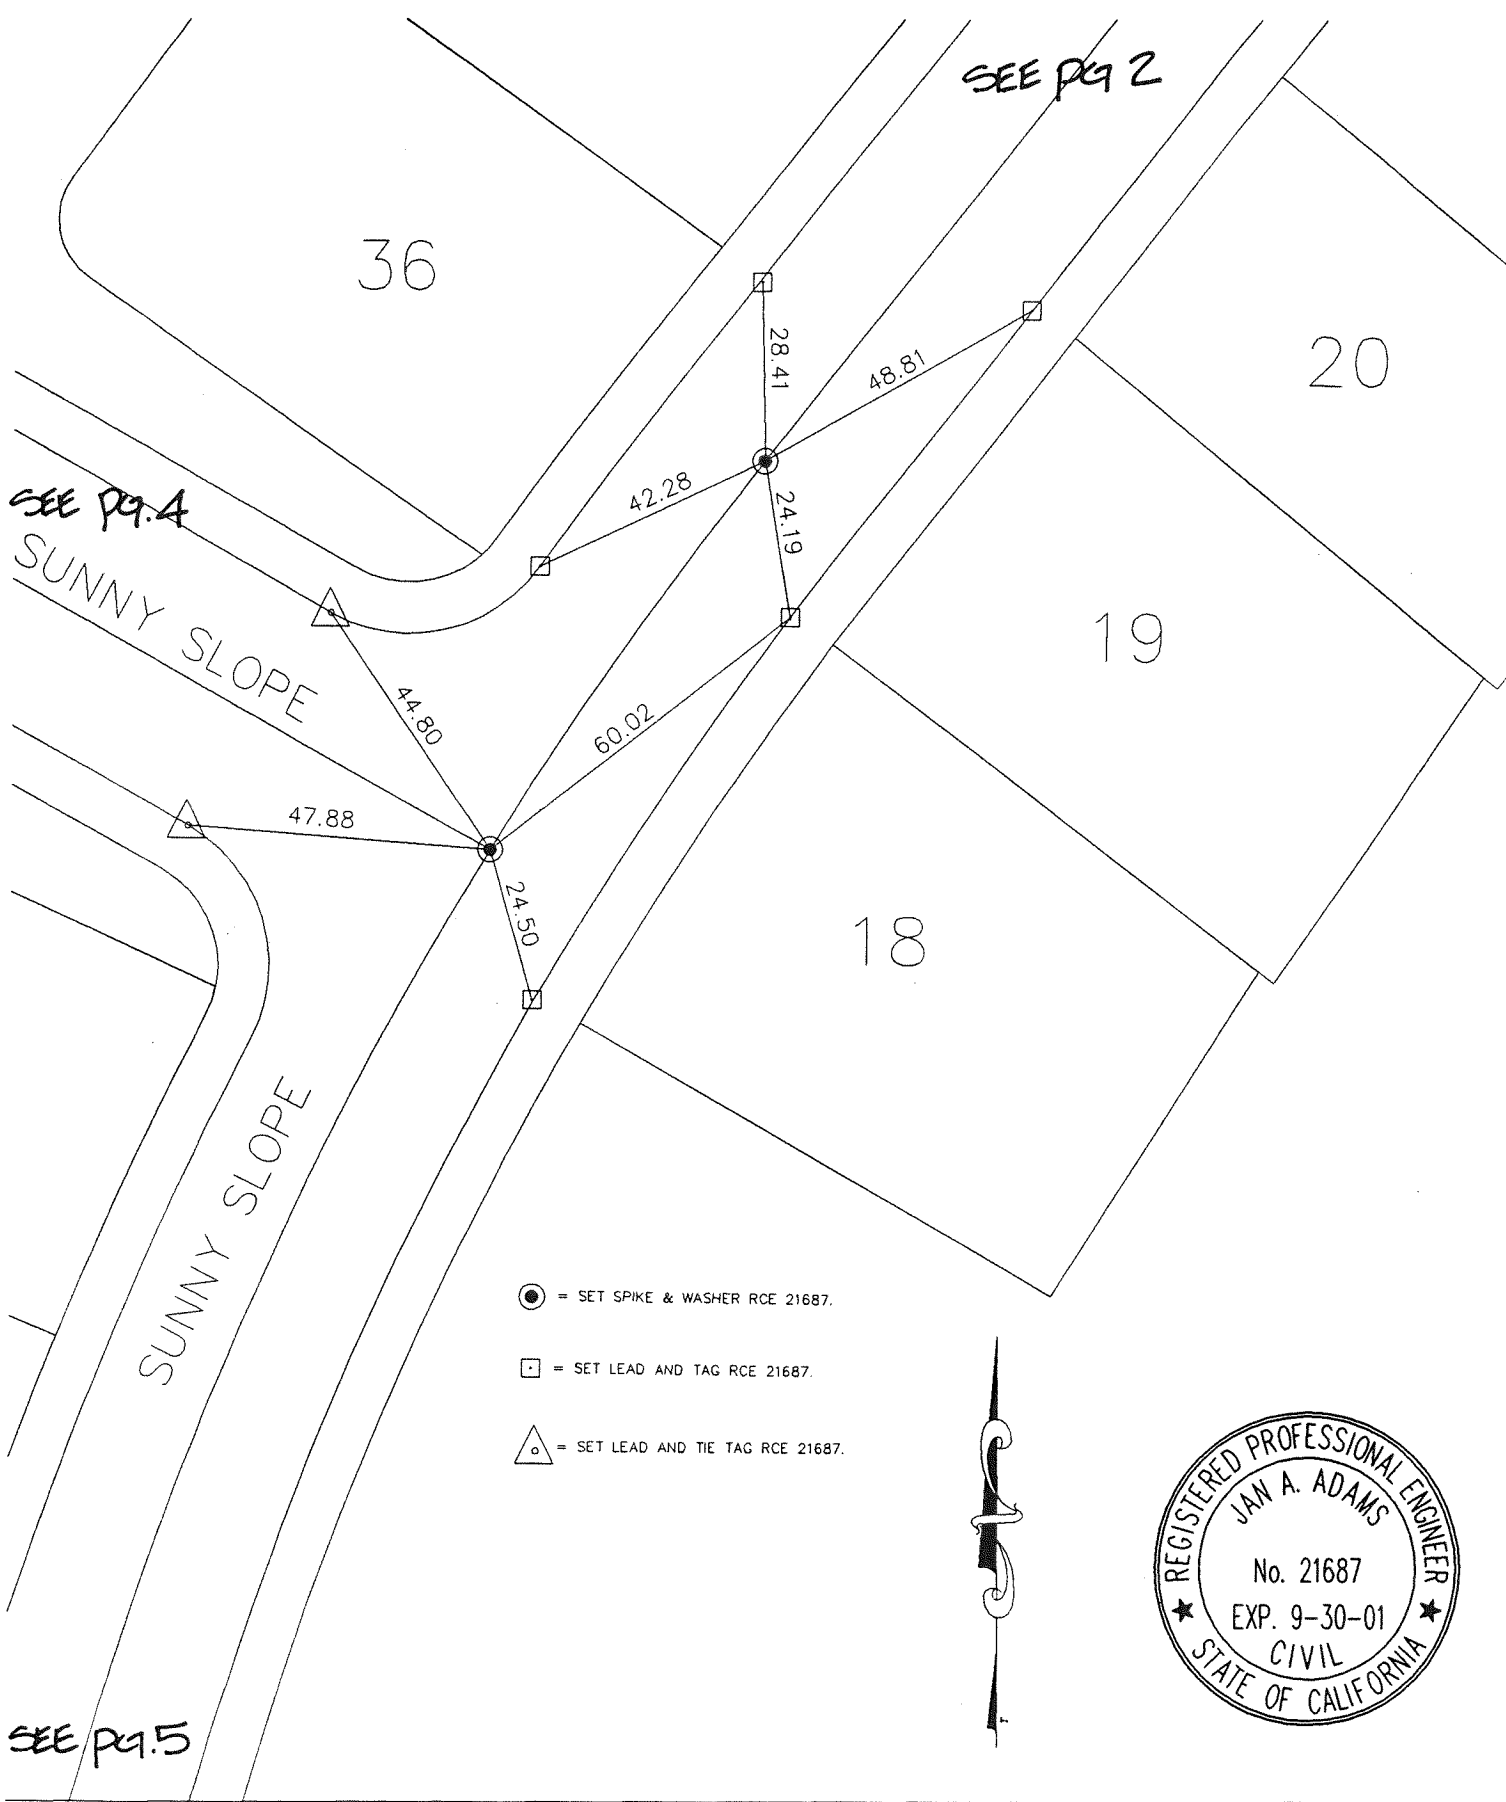

**Adams & Streeter**  
CIVIL ENGINEERS INC.

15 Corporate Park, Irvine, CA 92606  
Ph: (949) 474-2330 Fax: (949) 474-0251  
email: ASIASI@ix.netcom.com

TRACT NO. 15349

**CENTERLINE TIES**

DATE: 1/99

SCALE: 1" = 30'

PAGE 3 OF 5



⊙ = SET SPIKE & WASHER RCE 21687.

□ = SET LEAD AND TAG RCE 21687.

△ = SET LEAD AND TIE TAG RCE 21687.



MEANDERING TRAIL

SUNNY SLOPE

SEE PG. 3

1


2

32.37

32.40

54.30

54.92

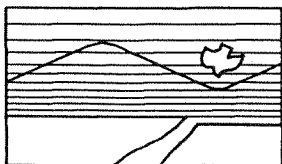

**Adams • Streeter**  
CIVIL ENGINEERS INC.

15 Corporate Park, Irvine, CA 92606  
Ph: (949) 474-2330 Fax: (949) 474-0251  
email: ASIASI@ix.netcom.com


TRACT NO. 15349

**CENTERLINE TIES**

DATE: 1/99

SCALE: 1" = 30'


PAGE 4 OF 5

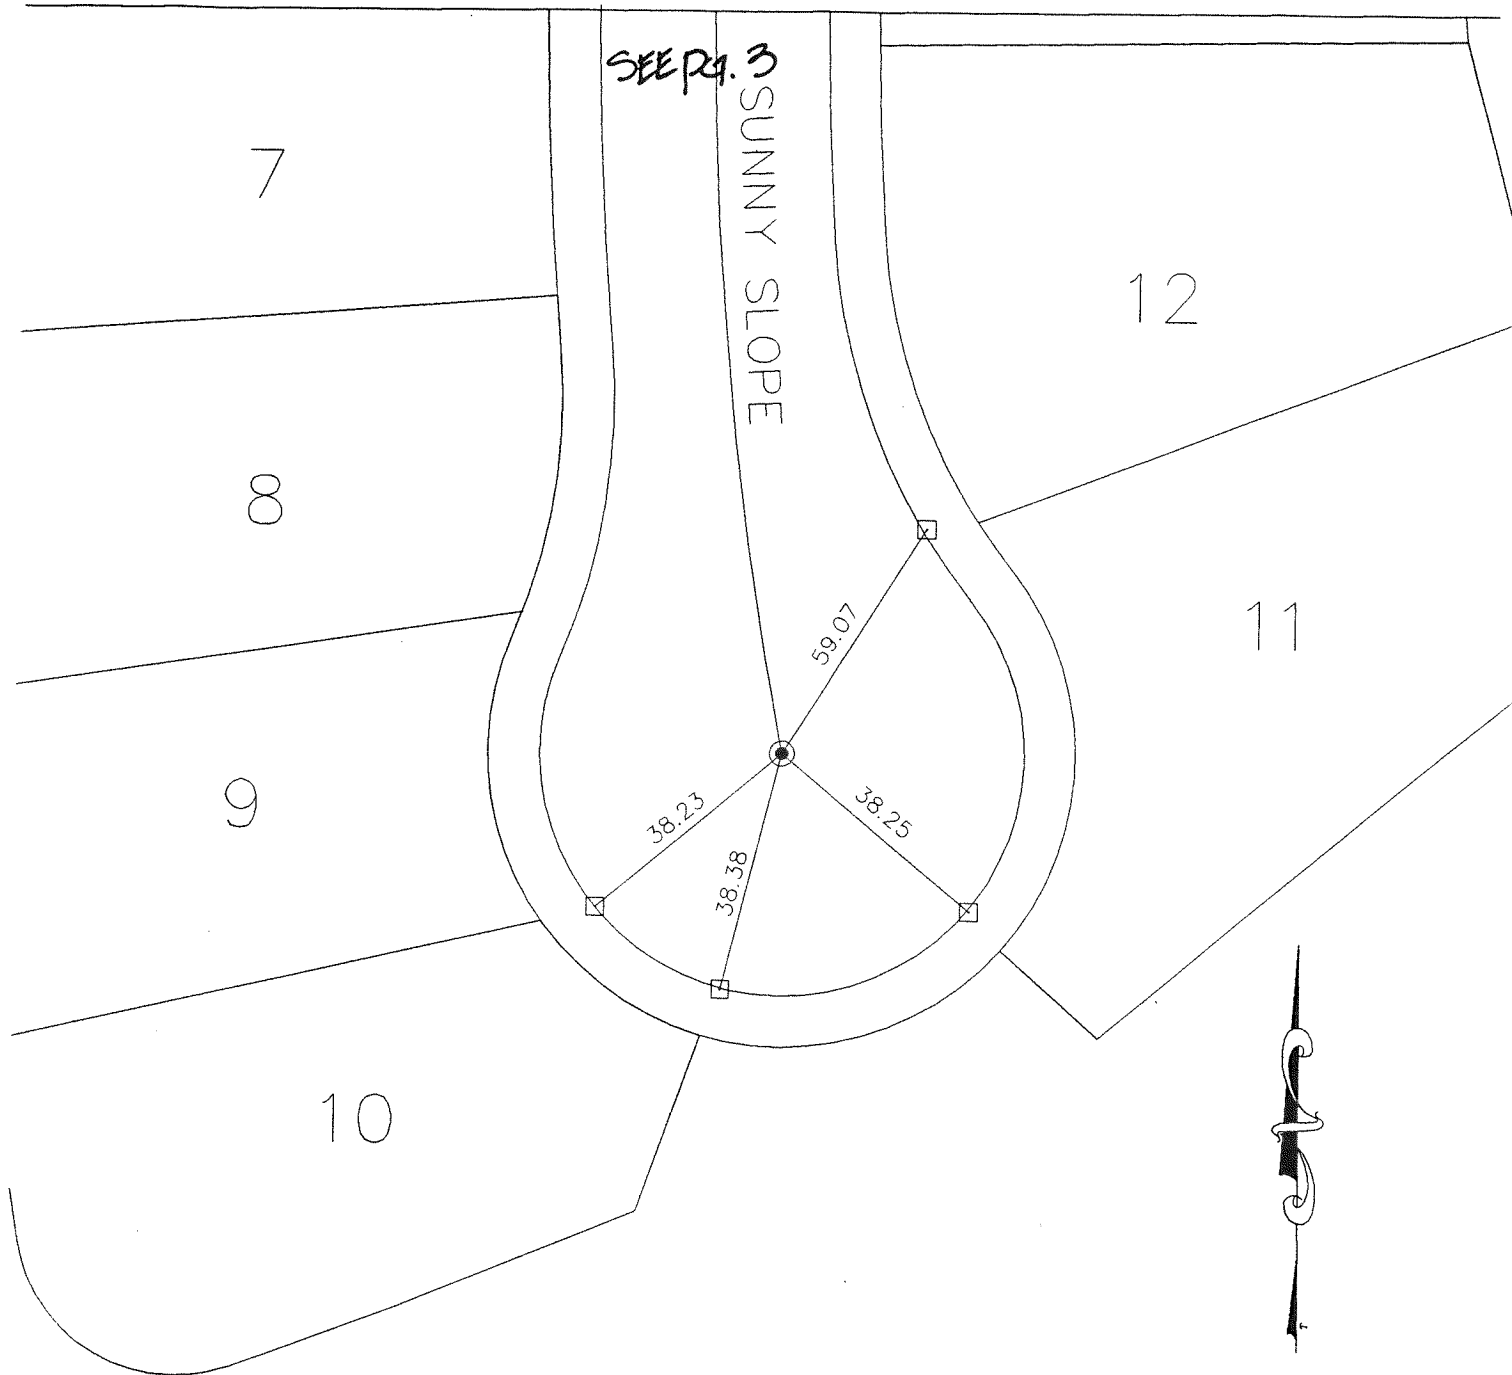

● = SET SPIKE & WASHER RCE 21687.

□ = SET LEAD AND TAG RCE 21687.

△ = SET LEAD AND TIE TAG RCE 21687.

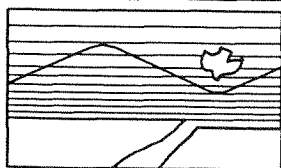

**Adams & Streeter**  
CIVIL ENGINEERS INC.

15 Corporate Park, Irvine, CA 92606  
Ph: (949) 474-2330 Fax: (949) 474-0251  
email: ASIASI@ix.netcom.com

TRACT NO. 15349

**CENTERLINE TIES**

DATE: 1/99

SCALE: 1" = 30'

PAGE 5 OF 5