


BLOCK: 5158 MODULE: 71 728182. WM40E
CORNER RECORD Document Number 2000-228
City of UNINCORPORATED County of ORANGE, California
Brief Legal Description CENTERLINE TIE NOTES FOR TRACT 15536

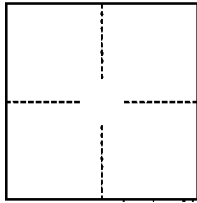

CORNER TYPE
Government Corner ☐ Control ☐
Meander ☐ Property ☒
Rancho ☐ Other ☐ Zone _____
Date of Survey January 4, 2000

COORDINATES
(Optional)
N. _____
E. _____
Datum _____
Elev. _____

Corner — Left as found ☐ Found and tagged ☐ Established ☒ Reestablished ☐ Rebuilt ☐

Identification and type of corner found: Evidence used to identify or procedure used to establish or reestablish the corner:
INDEX MAP FOR TRACT 15536

A description of the physical condition of the monument as found and as set or reset:

SURVEYOR'S STATEMENT

This Corner Record was prepared by me or under my direction in conformance with the
Land Surveyors' Act on January 4, 2000.


Signed Tom R. McGannon R.C.E. Number 23956



COUNTY SURVEYOR'S STATEMENT

This Corner Record was received 6/15 2000 and examined
and filed 6-22-00 2000

Signed Robert Jelinek Title DEPUTY COUNTY SURVEYOR

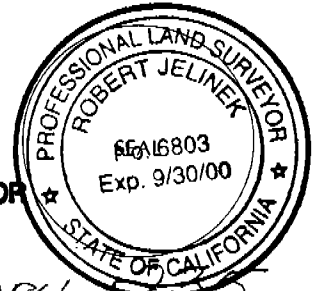

County Surveyor's Comment See CR 2000-229 thru 235
for the continuation of Tr. 15536

MONUMENT NOTES

- SET SPIKE & WASHER
STAMPED R.C.E. 23956,
UNLESS OTHERWISE NOTED.

ALL TIE POINTS ARE LEAD &
TACK TAGGED R.C.E. 23956
IN TOP OF CURB.



SCALE: 1" = 200'

