


BLOCK: 5158 MODULE: 82 WM 40E  
CORNER RECORD

Document Number 2000-233

City of UNINCORPORATED

County of ORANGE, California

Brief Legal Description CENTERLINE TIE NOTES FOR TRACT 15536

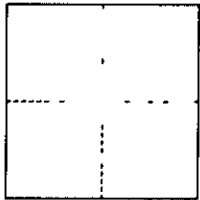

CORNER TYPE

Government Corner ☐ Control ☐  
Meander ☐ Property ☒  
Rancho ☐ Other ☐ Zone \_\_\_\_\_  
Date of Survey January 4, 2000

COORDINATES  
(Optional)

N \_\_\_\_\_  
E \_\_\_\_\_  
Datum \_\_\_\_\_  
Elev \_\_\_\_\_

Corner — Left as found ☐ Found and tagged ☐ Established ☒ Reestablished ☐ Rebuilt ☐

Identification and type of corner found Evidence used to identify or procedure used to establish or reestablish the corner  
A PORTION OF THE CENTERLINE TIE NOTE'S FOR THE ABOVE MENTIONED TRACT

A description of the physical condition of the monument as found and as set or reset

SURVEYOR'S STATEMENT

This Corner Record was prepared by me or under my direction in conformance with the  
Land Surveyors' Act on January 4, 2000

Signed Tom R. McGannon R C E Number 23956




COUNTY SURVEYOR'S STATEMENT

This Corner Record was received 6-15 2000 and examined

and filed June 22nd 2000

Signed Robert Jelinek Title DEPUTY COUNTY SURVEYOR

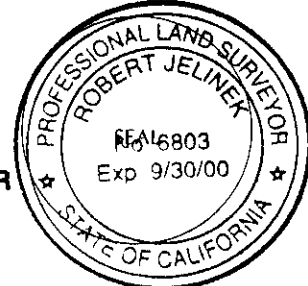

County Surveyor's Comment

MONUMENT NOTES

- SET SPIKE & WASHER  
 STAMPED R C E 23956,  
 UNLESS OTHERWISE NOTED

ALL TIE POINTS ARE LEAD &  
 TACK TAGGED R C E 23956  
 IN TOP OF CURB



SCALE 1" = 40'

