

BLOCK: 5158 MODULE: 72
CORNER RECORD


WM 40E

Document Number 2000-235

City of UNINCORPORATED

County of ORANGE, California

Brief Legal Description CENTERLINE TIE NOTES FOR TRACT 15536

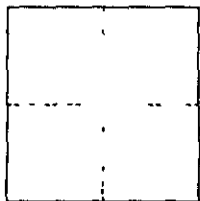

CORNER TYPE

Government Corner ☐ Control ☐
Meander ☐ Property ☒
Rancho ☐ Other ☐ Zone _____
Date of Survey January 4, 2000

**COORDINATES
(Optional)**

N _____
E _____
Datum _____
Elev _____

Corner — Left as found ☐ Found and tagged ☐ Established ☒ Reestablished ☐ Rebuilt ☐

Identification and type of corner found Evidence used to identify or procedure used to establish or reestablish the corner
A PORTION OF THE CENTERLINE TIE NOTE'S FOR THE ABOVE MENTIONED TRACT

A description of the physical condition of the monument as found and as set or reset _____

SURVEYOR'S STATEMENT

This Corner Record was prepared by me or under my direction in conformance with the
Land Surveyors' Act on January 4, 2000


Signed Tom R. McGannon R C E Number 23956

COUNTY SURVEYOR'S STATEMENT

This Corner Record was received 6/15 2000 and examined
and filed June 22nd 2000

Signed Robert Jelinek Title DEPUTY COUNTY SURVEYOR

County Surveyor's Comment _____

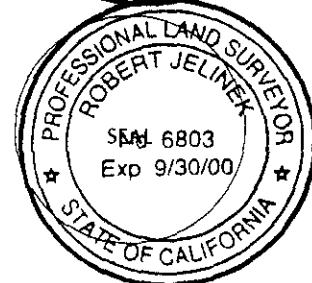

HUNSAKER & ASSOCIATES, INC
LAND SURVEYOR TOM R McGANNON, R C E 23956

DATE 1/4/00



SCALE 1" = 40'

MONUMENT NOTES

- SET SPIKE & WASHER
STAMPED R C E 23956,
UNLESS OTHERWISE NOTED

ALL TIE POINTS ARE LEAD &
TACK TAGGED R C E 23956
IN TOP OF CURB

