

BLOCK: 5158 MODULE: 82

WM 40E


CORNER RECORD

Document Number 2000-241

City of UNINCORPORATED

County of ORANGE, California

Brief Legal Description CENTERLINE TIE NOTES FOR TRACT 15537, MM 769/33-36

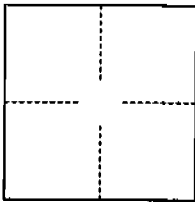

CORNER TYPE

Government Corner ☐ Control ☐
 Meander ☐ Property ☒
 Rancho ☐ Other ☐ Zone _____
 Date of Survey 1/6/00

COORDINATES (Optional)

N. _____
 E. _____
 Datum _____
 Elev. _____

Corner — Left as found ☐ Found and tagged ☐ Established ☒ Reestablished ☐ Rebuilt ☐

Identification and type of corner found: Evidence used to identify or procedure used to establish or reestablish the corner:
INDEX MAP FOR TRACT 15537

A description of the physical condition of the monument as found and as set or reset: _____

SURVEYOR'S STATEMENT

This Corner Record was prepared by me or under my direction in conformance with the
 Land Surveyors' Act on JANUARY 6, 2000.

Signed Tom R. McGannon R.C.E. Number 23956




COUNTY SURVEYOR'S STATEMENT

This Corner Record was received 6/15 2000 and examined

and filed July 5th 2000

Signed Robert Jelinek Title DEPUTY COUNTY SURVEYOR

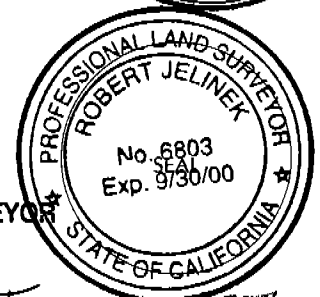

County Surveyor's Comment For continuation of Tr 15537
See CR2000-242 thru -246

CENTERLINE TIES FOR TRACT 15537

HUNSAKER & ASSOCIATES, INC.
LAND SURVEYOR: TOM R. MCGANNON, R.C.E. 23956

DATE: 1/6/00

SHEET 2 OF 2 SHEETS
OTHER SHEETS ARE ON
SEPARATE CORNER RECORDS

MONUMENT NOTES

- SET SPIKE & WASHER
STAMPED R.C.E. 23956,
UNLESS OTHERWISE NOTED.

ALL TIE POINTS ARE LEAD &
TACK TAGGED R.C.E. 23956
IN TOP OF CURB.



SCALE: 1" = 200'

