

CORNER RECORD

BLOCK 5158 MODULE 80


WM 44W

Document Number 2000-389

City of UNINCORPORATED

County of ORANGE, California

Brief Legal Description CENTERLINE TIE NOTES FOR TRACT 15582, MM 771/19-22

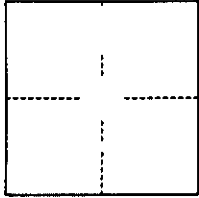

CORNER TYPE

Government Corner ☐ Control ☐
 Meander ☐ Property ☒
 Rancho ☐ Other ☐ Zone _____
 Date of Survey MAY 23, 2000

COORDINATES (Optional)

N _____
 E _____
 Datum _____
 Elev _____

Corner — Left as found ☐ Found and tagged ☐ Established ☒ Reestablished ☐ Rebuilt ☐

Identification and type of corner found Evidence used to identify or procedure used to establish or reestablish the corner
 A PORTION OF THE CENTERLINE TIE NOTE'S FOR THE ABOVE MENTIONED TRACT

A description of the physical condition of the monument as found and as set or reset

SURVEYOR'S STATEMENT

This Corner Record was prepared by me or under my direction in conformance with the
 Land Surveyors' Act on MAY 23, 2000


Signed Tom R. McManis R C E Number 23956



COUNTY SURVEYOR'S STATEMENT

This Corner Record was received 7/3 2000 and examined
 and filed July 5th 2000

Signed Robert Jelinek Title DEPUTY COUNTY SURVEYOR

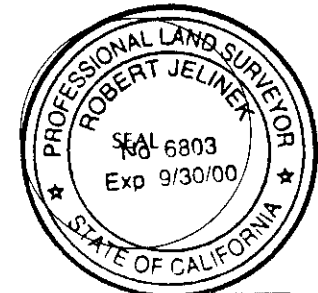

County Surveyor's Comment

MONUMENT NOTES

• SET SPIKE & WASHER
 STAMPED R C E 23956,
 UNLESS OTHERWISE NOTED

ALL TIE POINTS ARE LEAD &
 TACK TAGGED R C E 23956
 IN TOP OF CURB



SCALE 1" = 40'

