

# CORNER RECORD


BLOCK: 5158 MODULE: B1 NM 44W

Document Number 2000-331

City of UNINCORPORATED

County of ORANGE, California

Brief Legal Description CENTERLINE TIE NOTES FOR TRACT 15582, MM 771/19-22

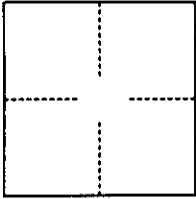

## CORNER TYPE

Government Corner ☐ Control ☐  
 Meander ☐ Property ☒  
 Rancho ☐ Other ☐ Zone \_\_\_\_\_  
 Date of Survey MAY 23, 2000

## COORDINATES (Optional)

N \_\_\_\_\_  
 E \_\_\_\_\_  
 Datum \_\_\_\_\_  
 Elev \_\_\_\_\_

Corner — Left as found ☐ Found and tagged ☐ Established ☒ Reestablished ☐ Rebuilt ☐

Identification and type of corner found Evidence used to identify or procedure used to establish or reestablish the corner  
A PORTION OF THE CENTERLINE TIE NOTE'S FOR THE ABOVE MENTIONED TRACT

A description of the physical condition of the monument as found and as set or reset

## SURVEYOR'S STATEMENT

This Corner Record was prepared by me or under my direction in conformance with the  
 Land Surveyors' Act on MAY 23, 2000


Signed Tom R. McGannon R C E Number 23956

## COUNTY SURVEYOR'S STATEMENT

This Corner Record was received 7/5 20 00 and examined  
 and filed July 5th, 20 00

Signed Robert Jelinek Title DEPUTY COUNTY SURVEYOR

County Surveyor's Comment

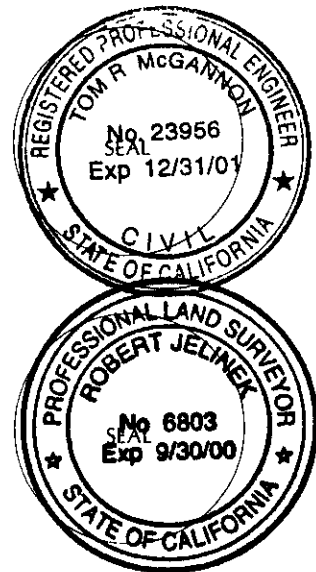

**MONUMENT NOTES**

- SET SPIKE & WASHER  
STAMPED R C E 23956,  
UNLESS OTHERWISE NOTED

ALL TIE POINTS ARE LEAD &  
TACK TAGGED R C E 23956  
IN TOP OF CURB

